

71. 8. 01

SINGLE PLATE $\frac{22}{20}$

STOPPERA
COLLAR ON THIS
PINTLE ONLY

44-5-
TOTAL HEIGHT

NOTE:- RIVETS IN STAYS TO BE
SPACED $5\frac{5}{8}$ CENTRES & $\frac{1}{8}$ " DIA^R

DISTANCE BETWEEN
GUDGEONS TO BE TAKEN
FROM STERNFRAME

STOPPER B

STOPPER B

SECTION AT C.D.

East Hill Radder


Misses Sunderland & Co

No 214

SS Monmouthshire

Back to Newcastle

Sunderland. No. 21105

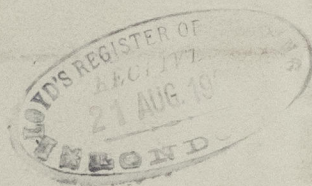

Sec Letter 21-8-01



© 2020

Lloyd's Register
Foundation

009030-009039-0320