

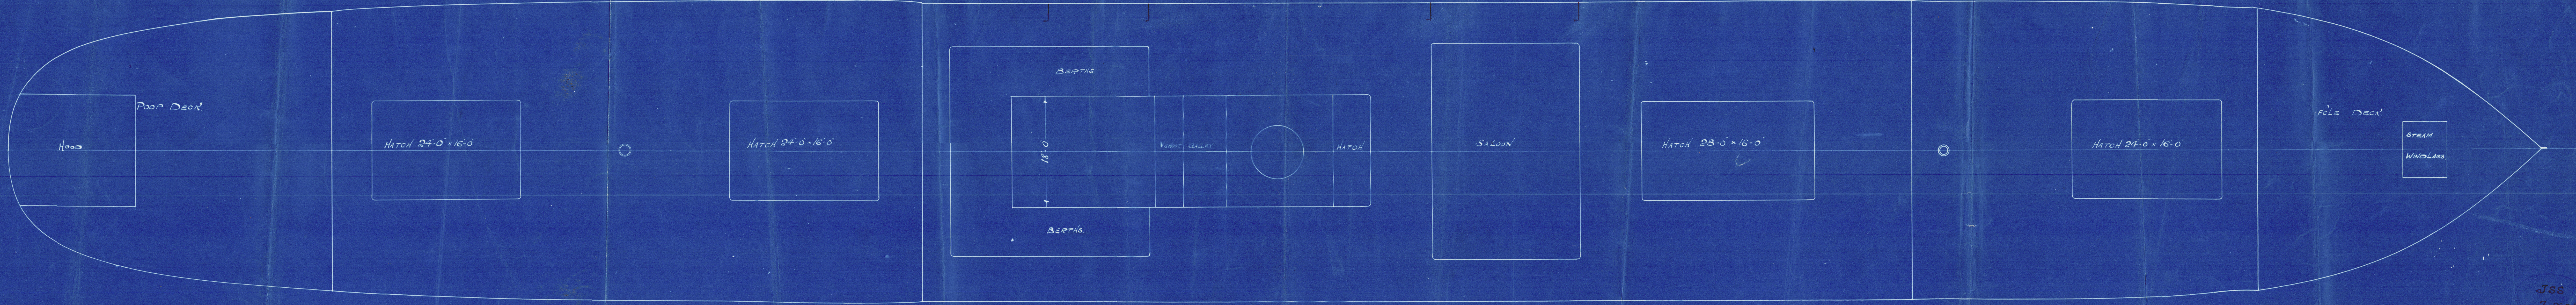


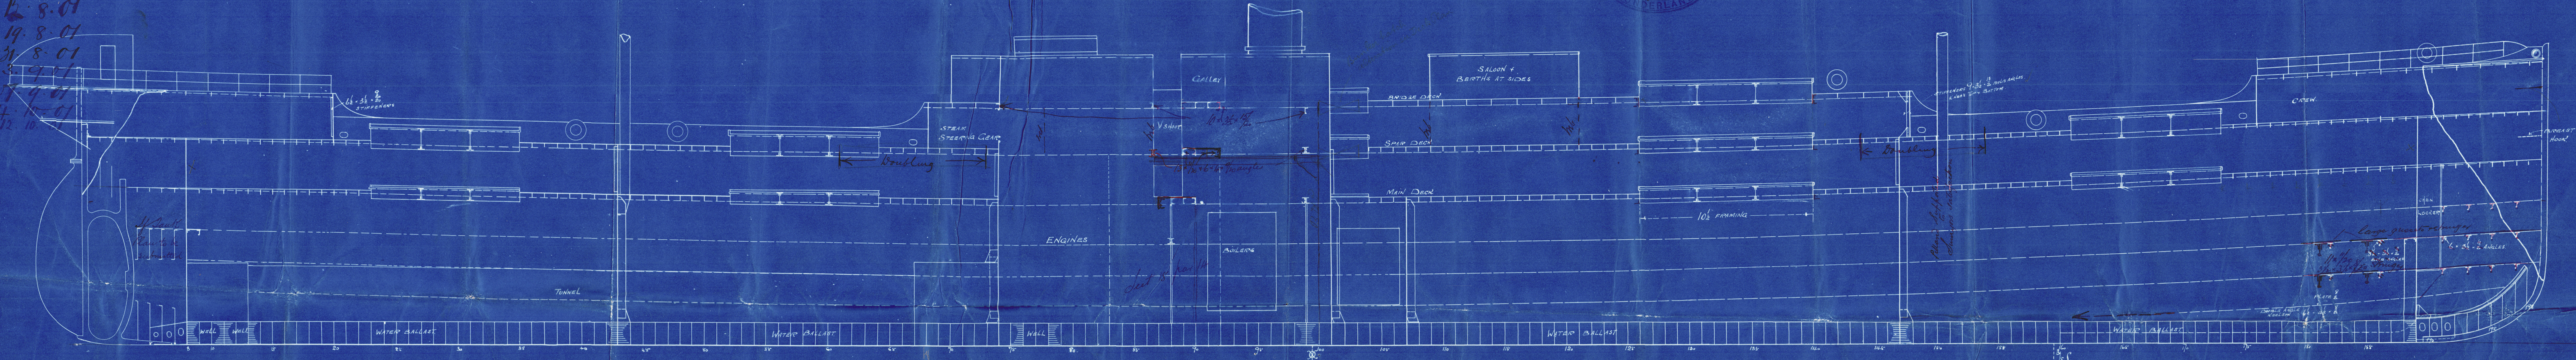

12-8-01
19-8-01
31-8-01
3-9-01
27-9-01
4-10-01
12-10-01

PROFILE - N° 214 S
LENGTH B.P. 400-0
BREADTH 52-0
DEPTH M.P. TO SPAR DECK 31-0
CLASS 100 A.I. SPAR DECK 30-11 1/2
SCALE 1/8" = 1 FOOT

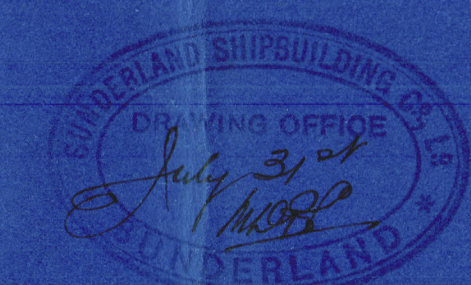

12/8/01

JSS
7-8-01




Sund SBC^o

"
SS Monmouthshire

No 214

Lundland No 21105

Profile

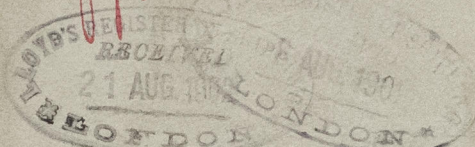

Sec Letter 12-8-01 SHIPPING
19-8-01

