


21.5.10
3.6.10

13/5/10
S. S. Nos 135 & 136.
LONGITUDINAL SECTION.

DIMS: 126'-8" B.P. x 23'-0" EX. x 12'-6" M.H.
SCALE 1/4" IN. = 1 FT.

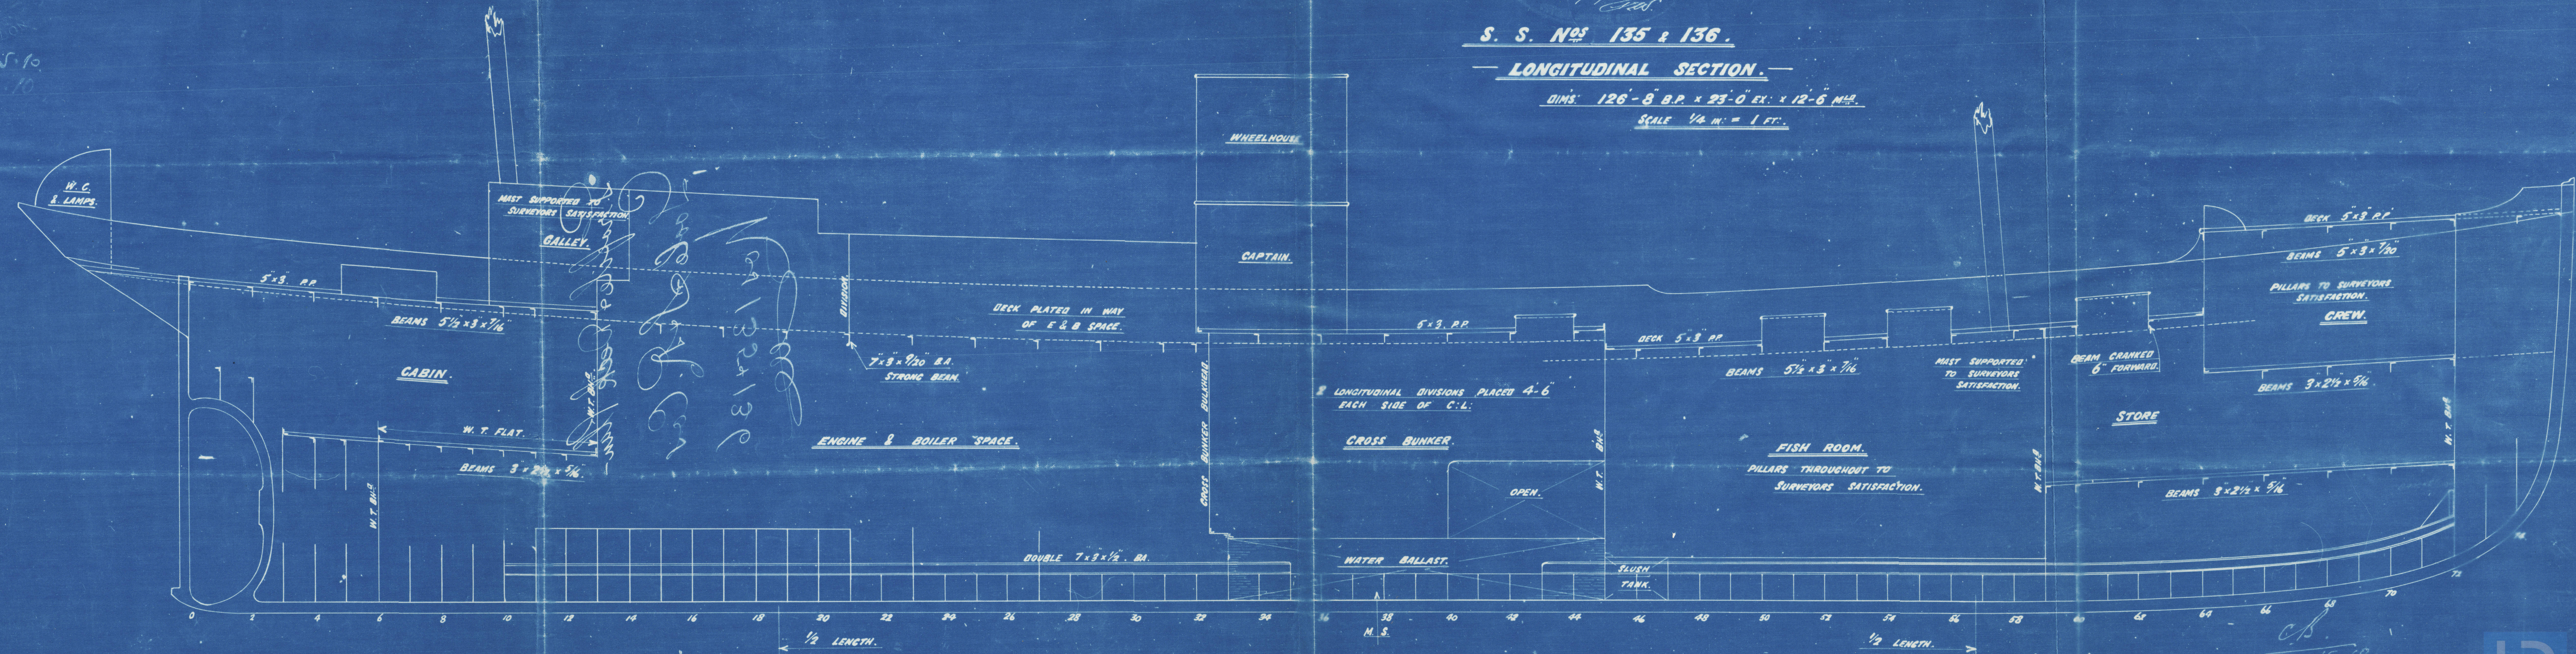

Goole S. & R. Co. Ltd.

Duplicate


Profile.

No 135 & 136.

W. Kildan

Hull Rpt No. 23526

009040-009049-0014

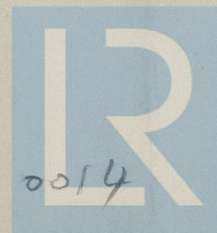

© 2020

Lloyd's Register
Foundation