


No. 484-6.  
S.S. OIL TANK STEAMER  
GENERAL ARRANGEMENT  
SCALE 1/4" TO 1 FT.

PRINCIPAL DIMENSIONS	
LENGTH P.P.	405'-0"
BREADTH MOULDED	53'-0"
DEPTH	34'-0"
TWEEN DECK HEIGHT (HT CENTAG)	9'-0"

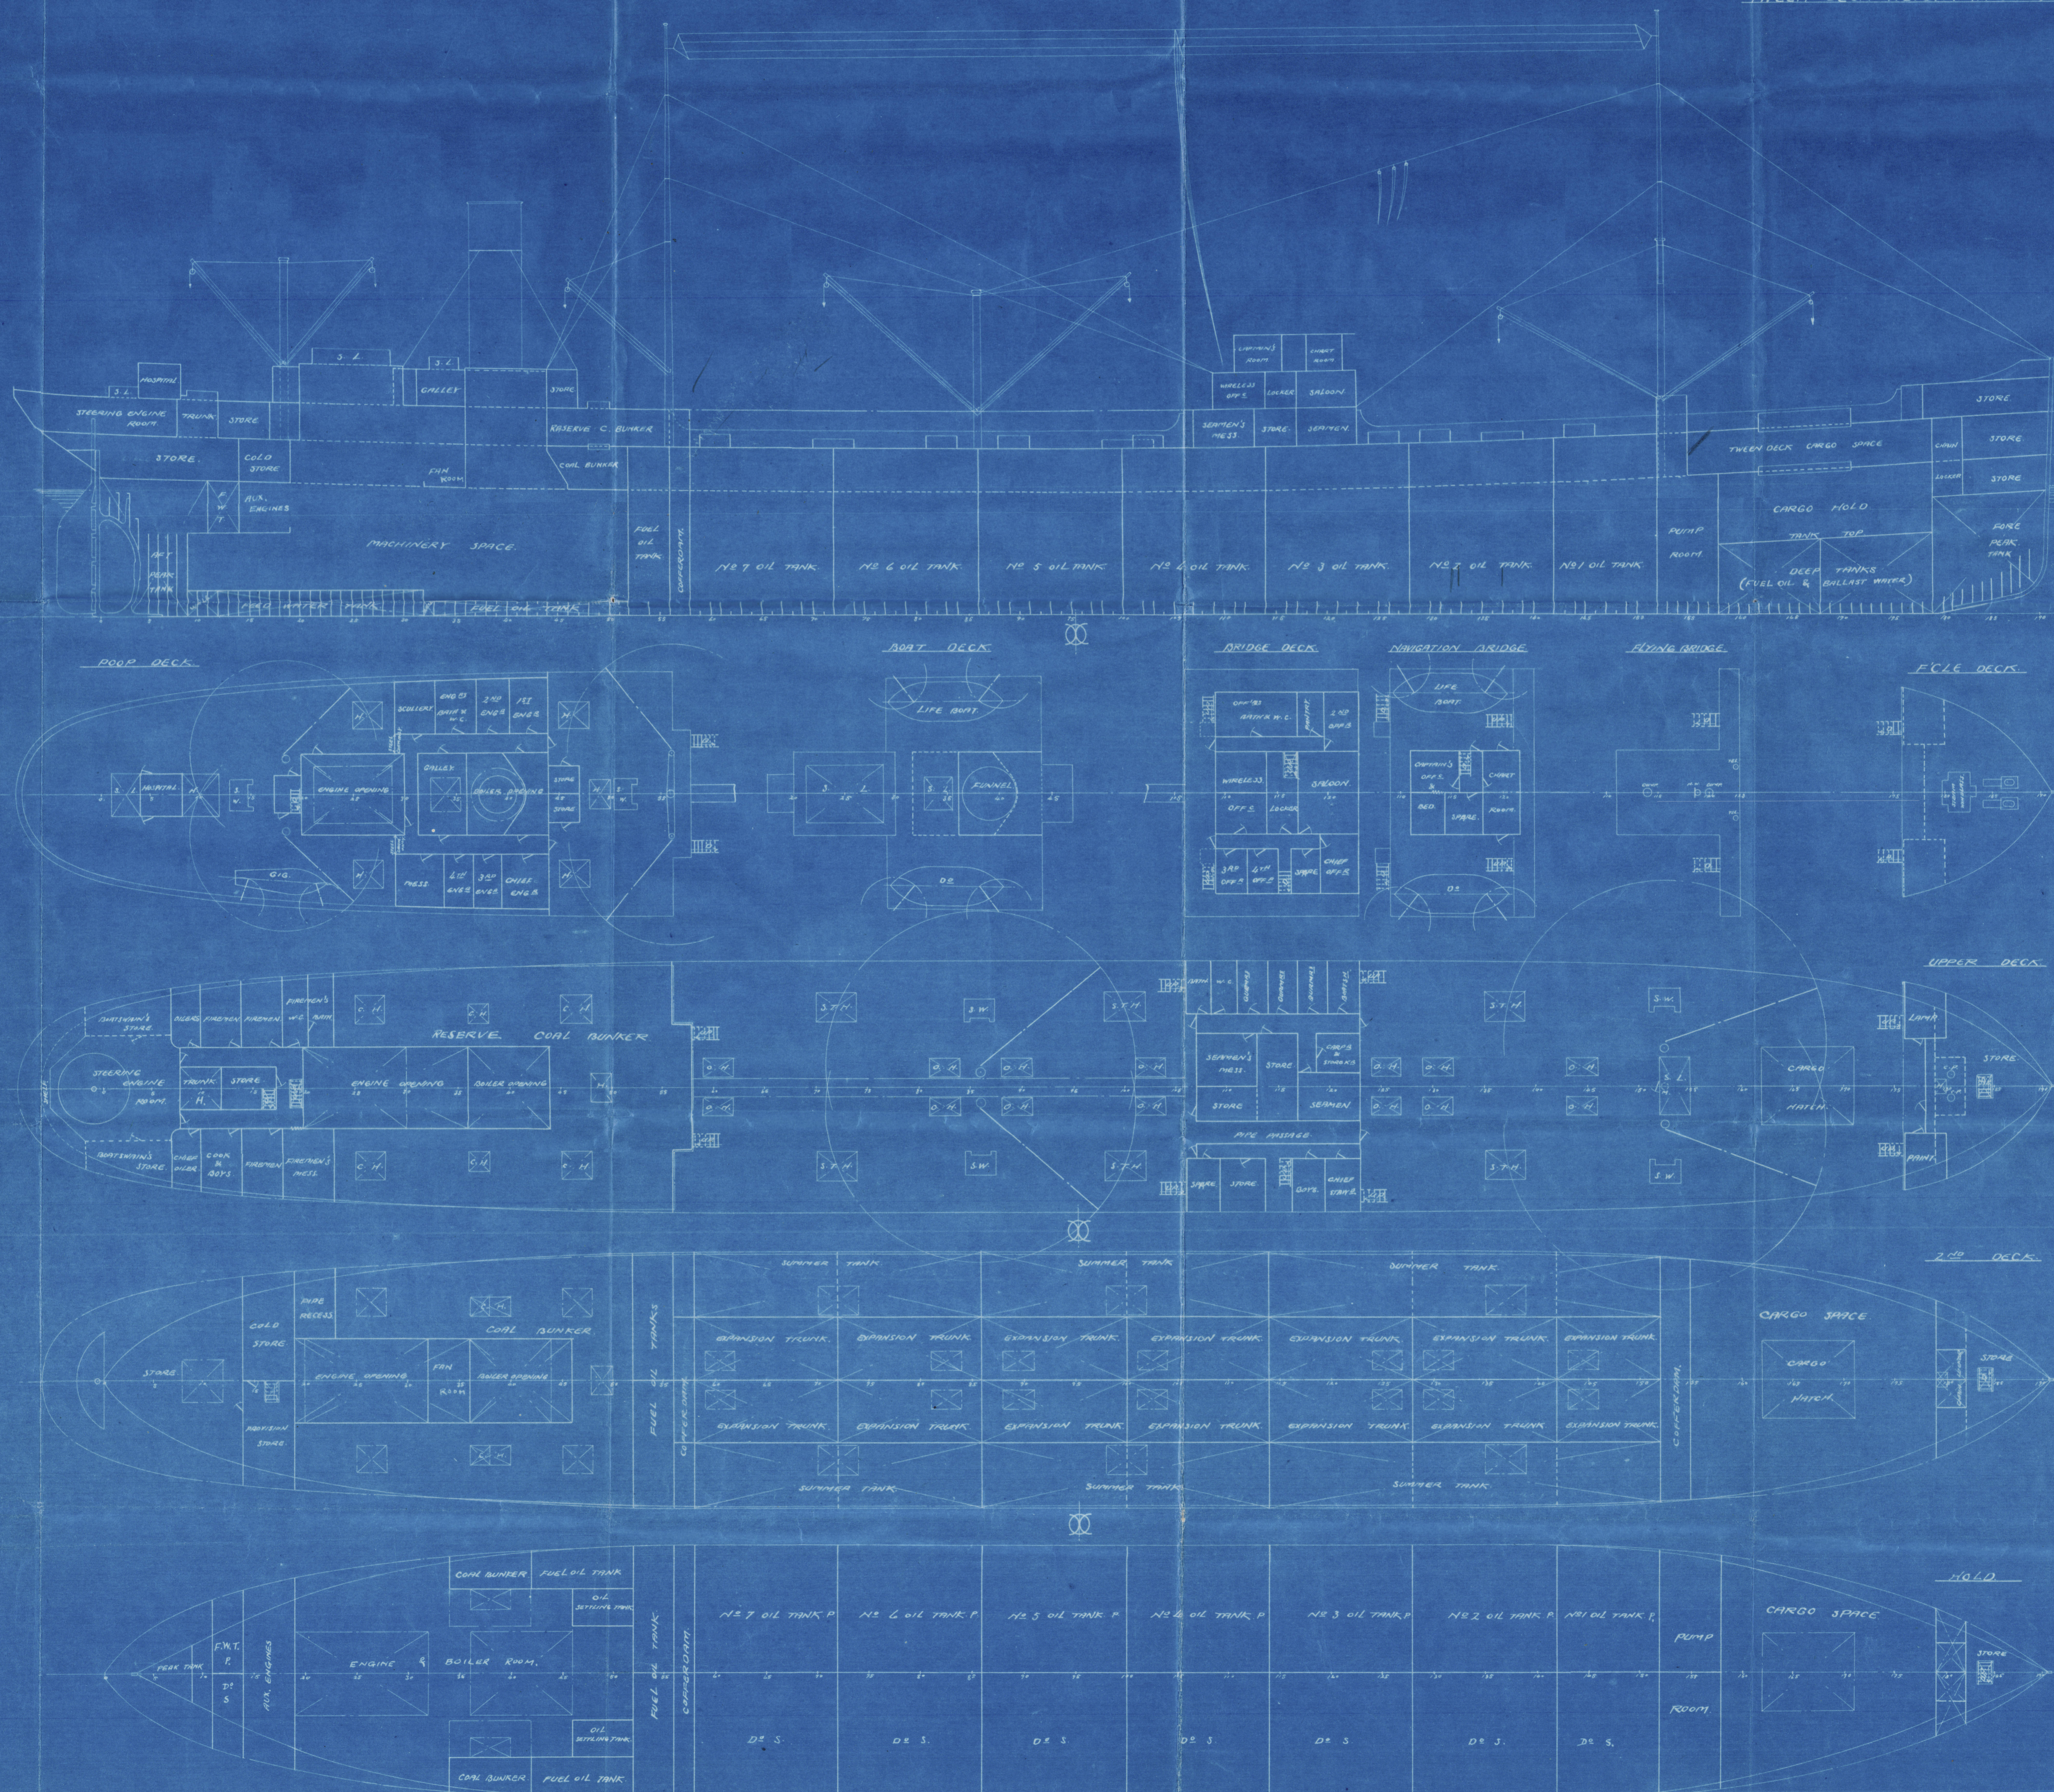

APPROVED

MAY 13 1921




General Arrgt.

~~Gen Box 3536~~

2/5 Florida Maru

Robt 4787

00 9040-009049-0264

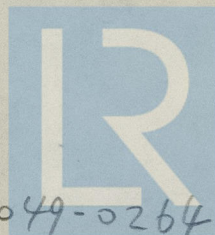

© 2020

Lloyd's Register  
Foundation

G.A.

London



© 2020

Lloyd's Register  
Foundation

00 9040 - 009049 - 0264