


NUMERAL A x D = 125.5 x 3.1 = 389.
SPEED UNDER 10 KNOTS.

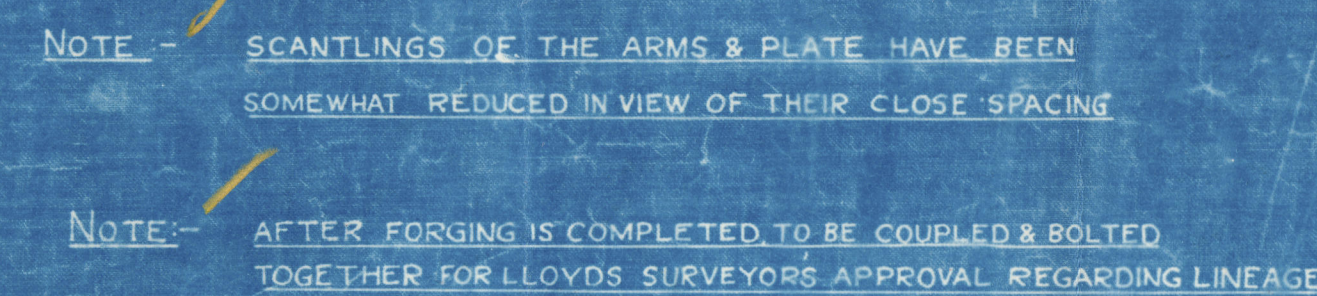

JOHN READHEAD & SONS LTD.
SHIPBUILDERS ENGINEERS &c.
SOUTH SHIELDS.

481

Messrs J. Readhead & Sons Ltd

S/L No 481

Stem post & Rudder


"DEMIR"

EX

S. S. EAST VILLE

NEWCASTLE ON TYNE.

Report No. 49488.

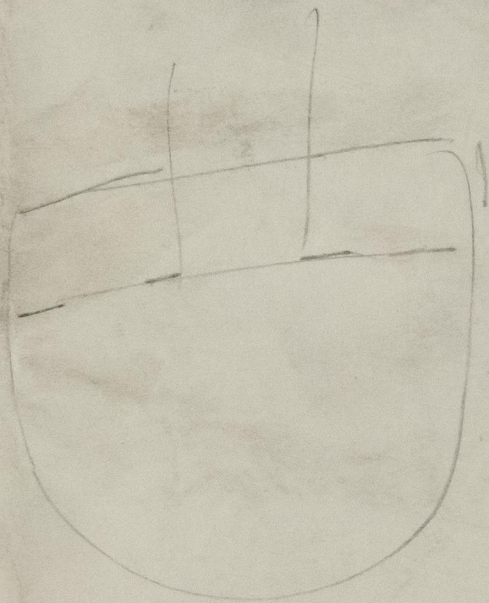

J. Readhead & Sons No 481

Stem & Rudder frame