

22/3/23

# EQUIPMENT

1ST BOWER ANCHOR 5 1/2 CWTs STOCKLESS ✓  
 2ND " " 5 CWTs " ✓  
 KEDGE ANCHOR 2 1/2 CWTs EX STOCK ✓  
 75 FATHOMS 5/16 STUD LINK CHAIN ✓  
 60 " 5/2 HAWSER ✓  
 60 " 3/2 WARP ✓

# NUMERALS

L x D	1063 75 ✓
B + D	37 50 ✓
L x (B+D)	3468 75 ✓
d	10 17 ✓
L/D	8 04 ✓

## BULWARKS 25

BUTTS STRAPPED AND SINGLE RIVETED

BELTING 9" x 7" ENGLISH ELM.  
 3/2 x 3 x 30 ANGLES  
 CONVEX BEAD ON FACE

## SHEERSTRAKE 4 1/2 x 32

BUTTS STRAPPED AND DOUBLE RIVETED


## D IN 56 x 32 TO 26

BUTTS LAPPED AND DOUBLE RIVETED

## C OUT 56 x 30 TO 26

BUTTS LAPPED AND DOUBLE RIVETED

PROPELLER BOSS PLATES 30 ✓

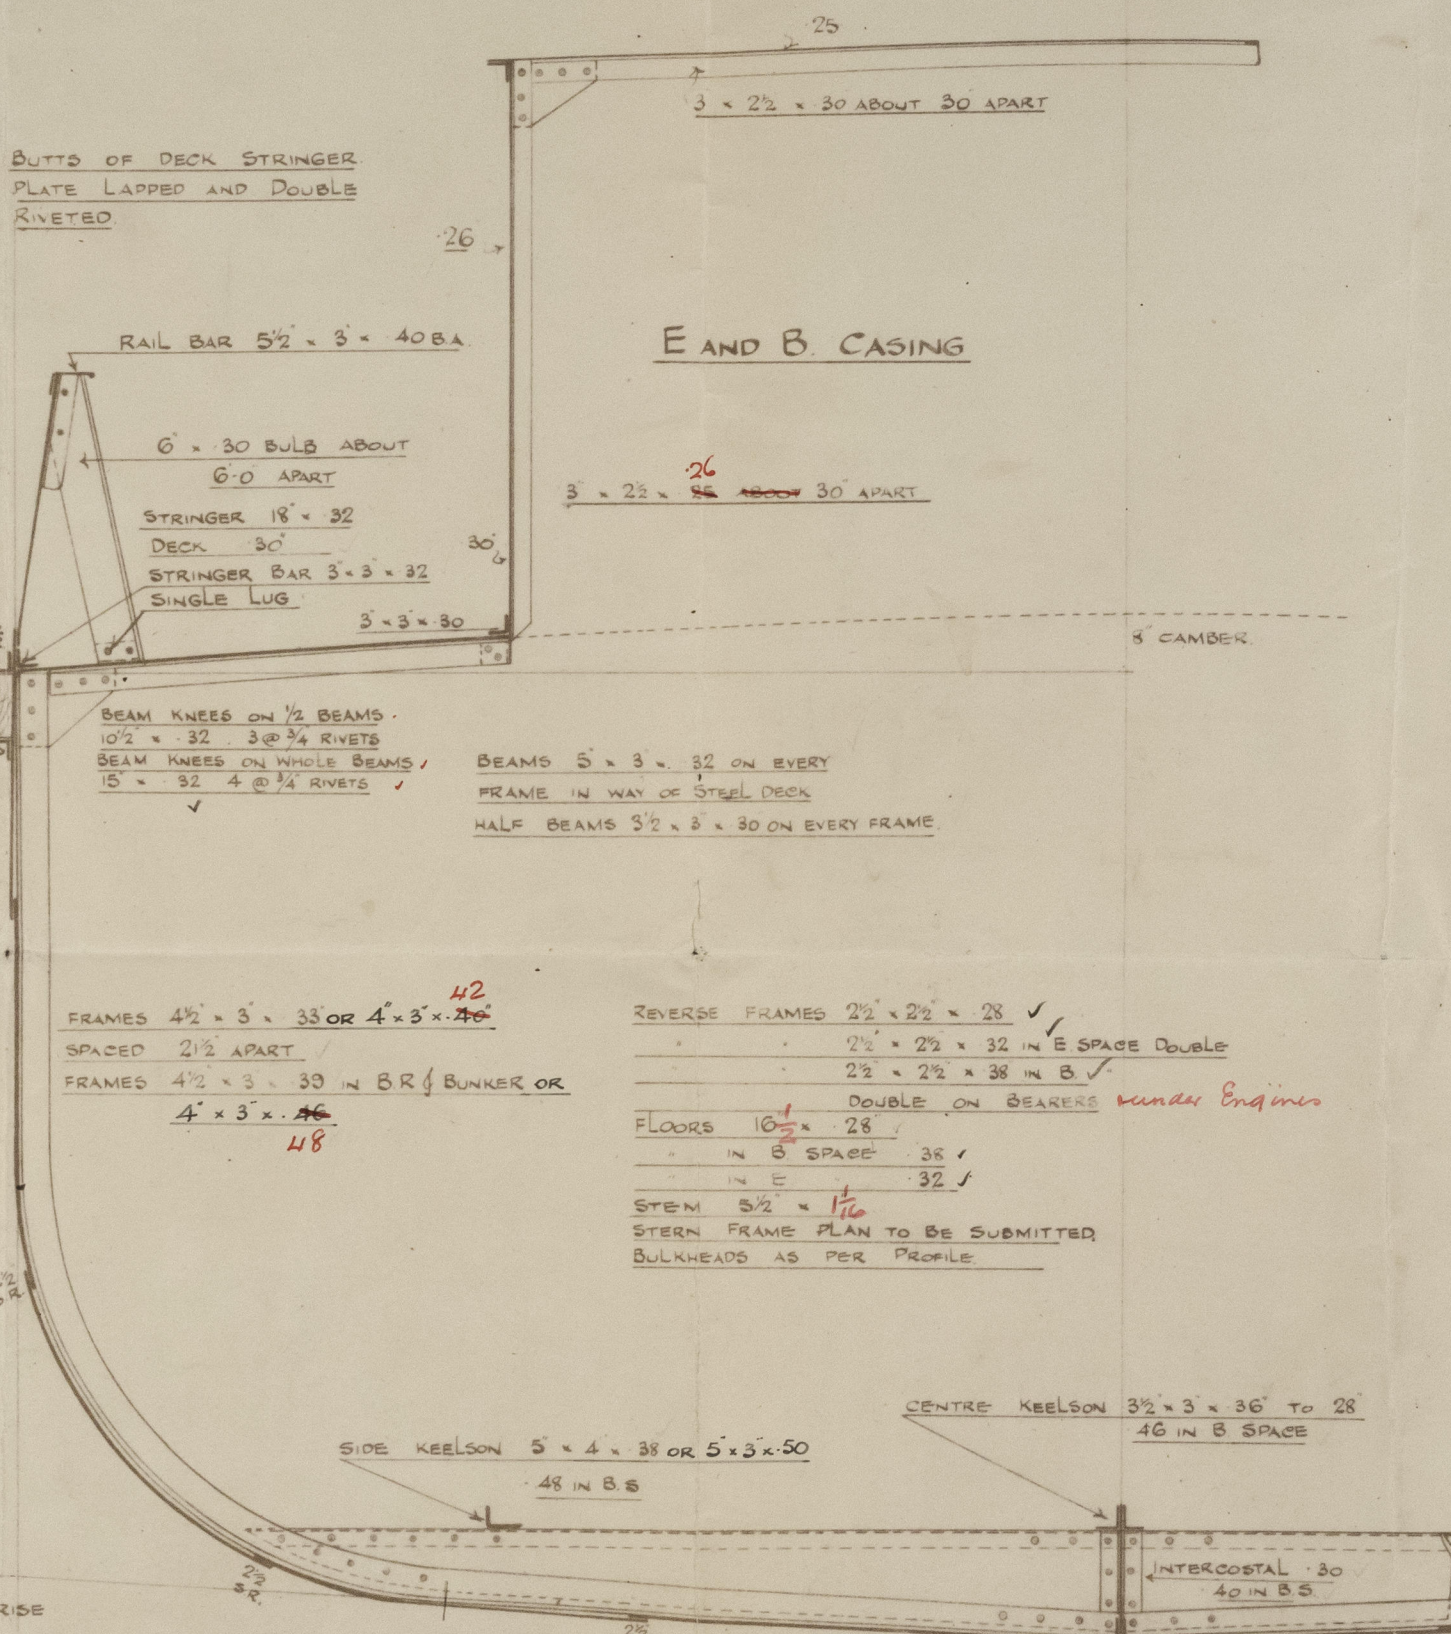

B IN 4 OUT 30 TO 26

56 WIDE

BUTTS LAPPED AND DOUBLE RIVETED

STRAKES A AND B MIDSHIP THICKNESS MAINTAINED TO WHERE BOTTOM IS STRENGTHENED FOR ICE SEE PROFILE

A IN 30 TO 26

56 WIDE

BUTTS LAPPED AND DOUBLE RIVETED

KEEL 36 x 40 TO 36

BUTTS LAPPED AND DOUBLE RIVETED

## MIDSHIP SECTION

STEEL SCREW TUG

TO CLASS 100 A.I. FOR TOWING PURPOSES


DIMNS - 92'-6" B.P. x 26'-0" MLD x 11'-6" MLD

1/2" SCALE

Nº 793

PLAN No. 365

FOR ENCLOSURE TO  
 Messrs. Lloyd's Surveyors  
 Hull.  
 FROM  
 COCHRANE & SONS, LTD.  
 SHIPBUILDERS, SELBY.  
 DATE 20/3/23. V.L.

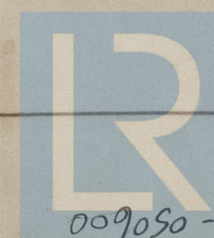

© 2021

Lloyd's Register

009050-009057-0206

Bochrane Sows

Midships Section

N<sup>o</sup> 793

Hull Fbd Rpt by 34206  
s/s "Salvage Prince"  
Hull Rpt No. 35095

009080-009087-0206



© 2021

Lloyd's Register  
Foundation