


# TWIN SCREW MOTOR VESSEL ELEVATION AND DECK PLANS No 497 SCALE 1/4" = ONE FT

DIMENSIONS 116'-0" O.A. x 21'-0" x 9'-0" M.O. DEPTH  
TO CLASS 100 A LLOYDS

DRAWING NO 1/497

SCANTLING SHOWN ON THIS PLAN ARE PRESUMED TO BE A MINIMUM WHICH COULD BE ACCEPTED FOR THE CLASS CONTEMPLATED. IF NOT, REDUCE SAME TO A MINIMUM AND DIMENSIONS REQUIREMENTS TO BE ADDED LATER

In 20 of Rules to be complied with  
F.P. of Sub Fuel in over 150°F

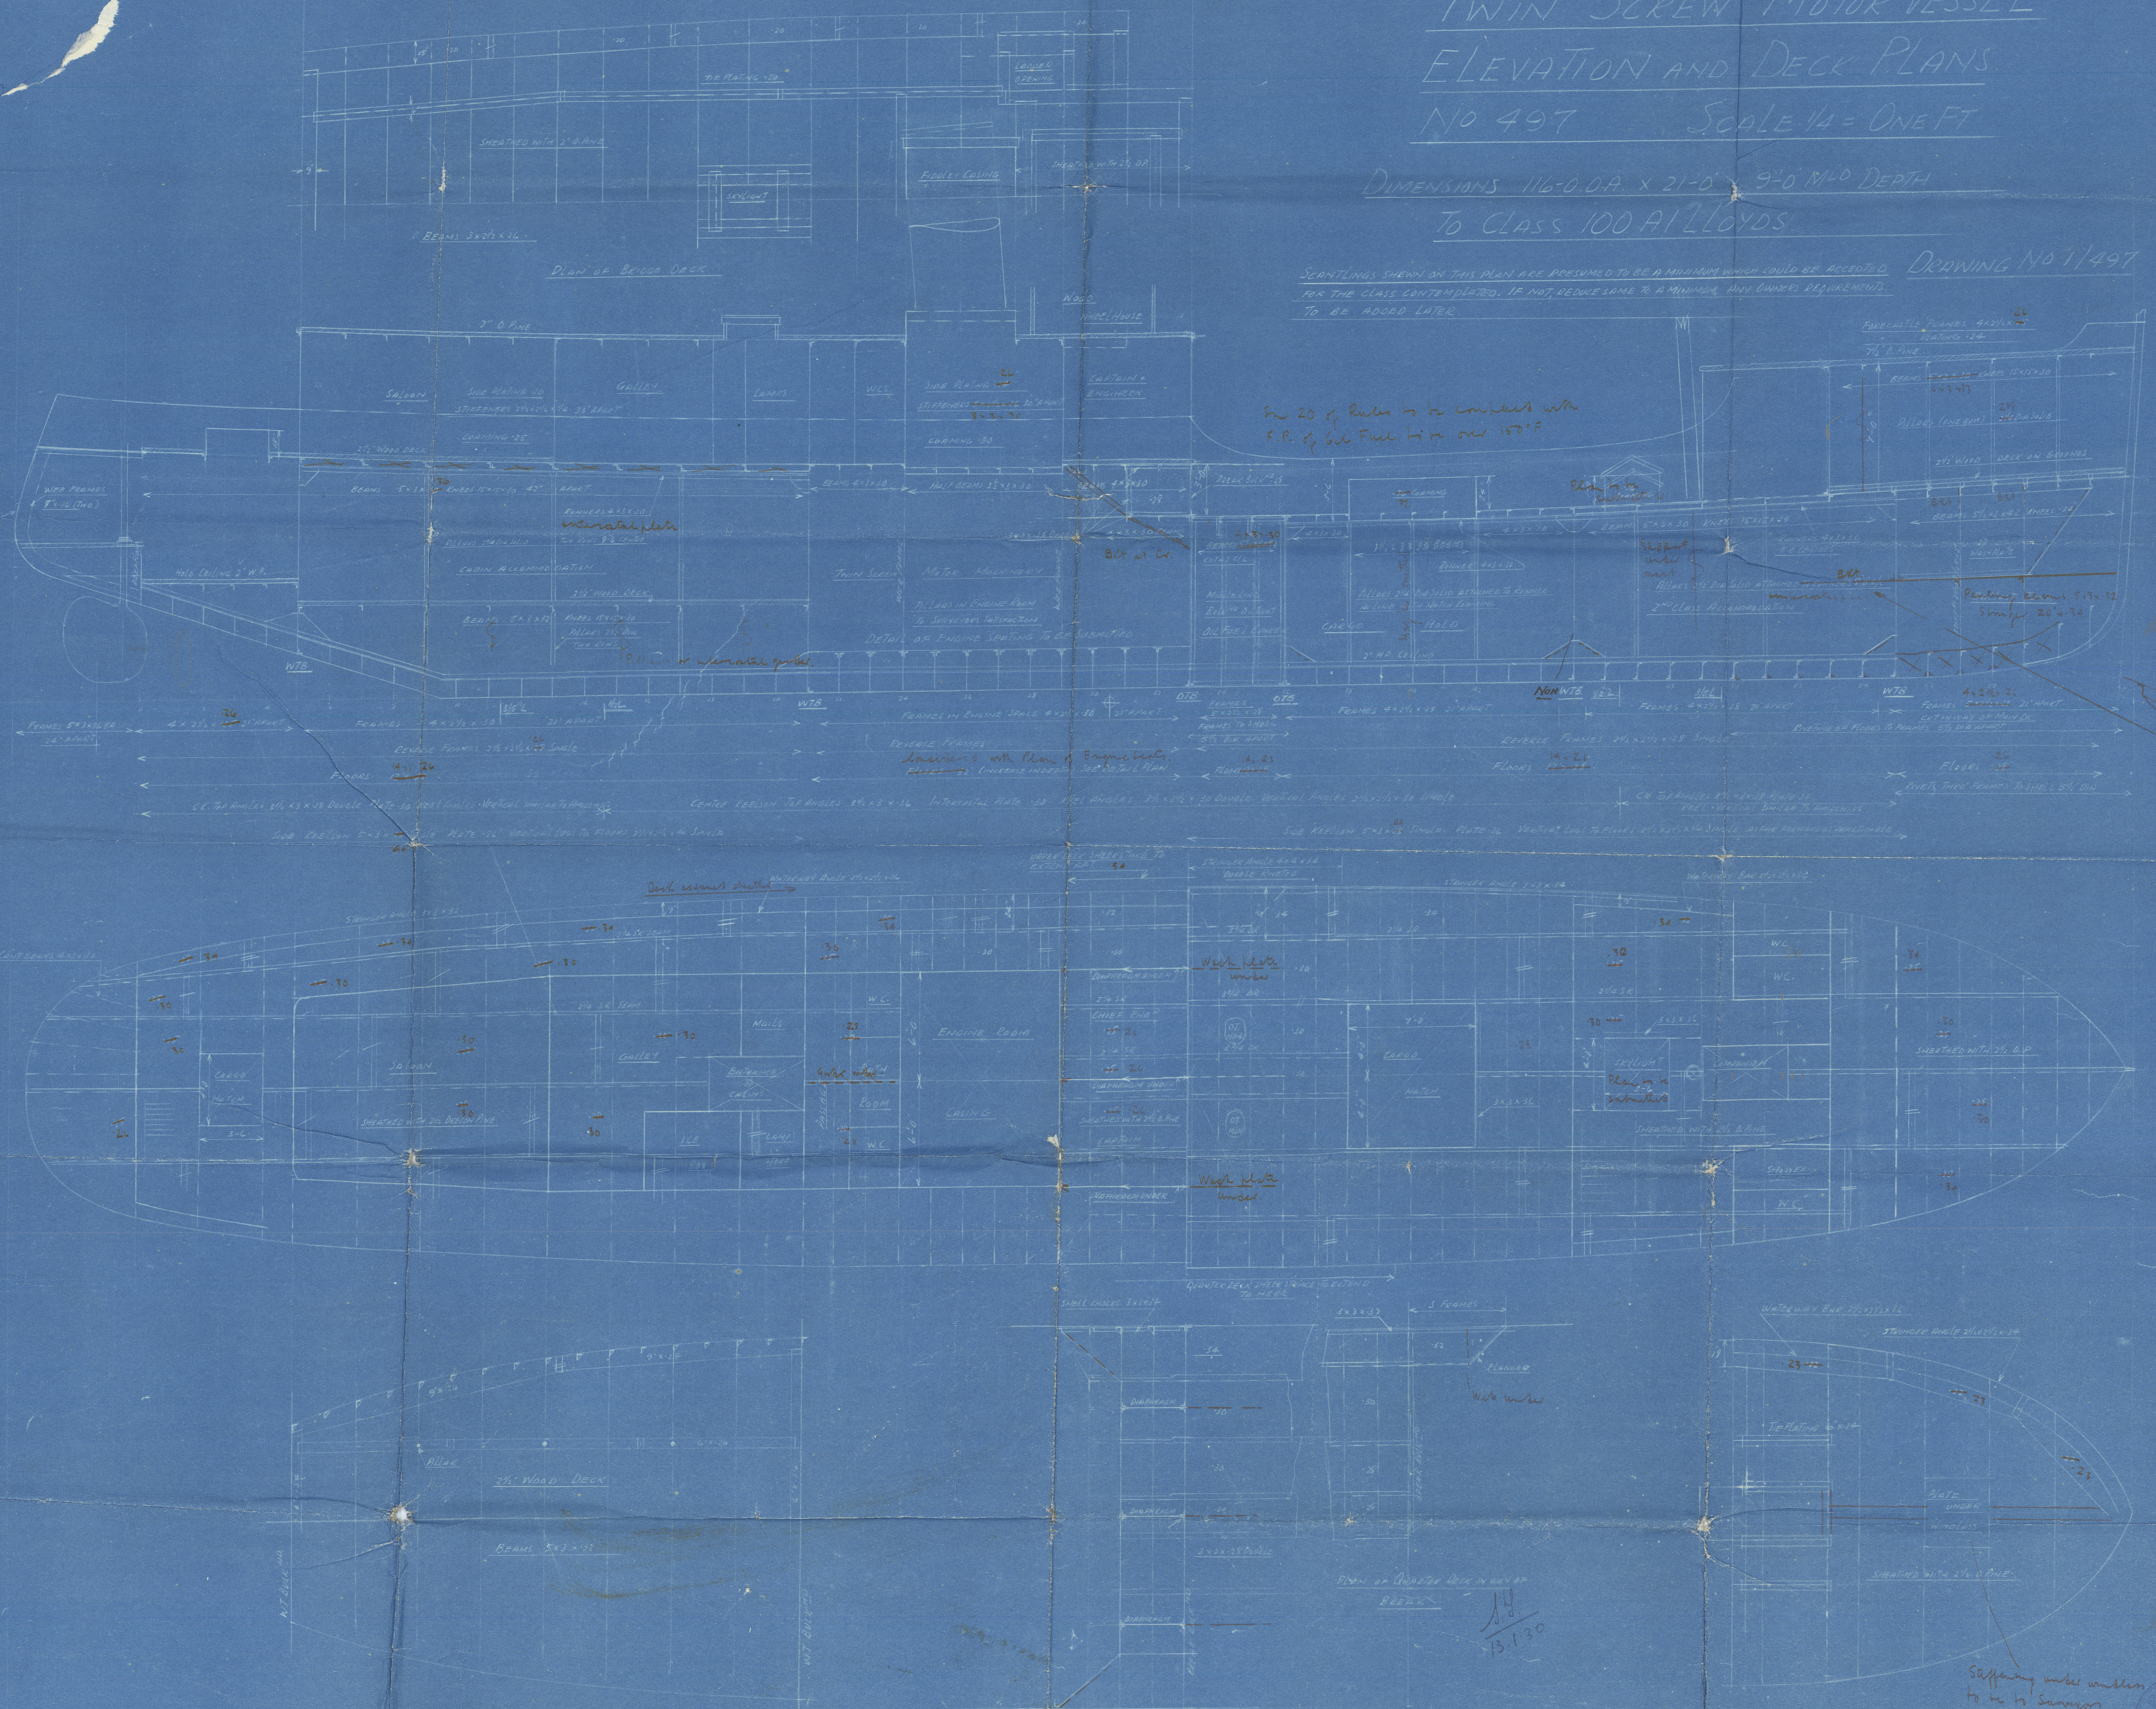

Staffing under orders  
to be in Surveyors  
Satisfaction



Elevation & Deck Plans

J. Buckton & Co

N<sup>o</sup> 497

S. S. *Sir Charles Carr*

LIVERPOOL.

Report No. *97350*



© 2021

Lloyd's Register  
Foundation

009050 - 009057 - 0259