


THU 13 DEC 83
SAT 22 DEC 88

Q
Era Sld 15136

BEAM ARRANGEMENT FOR NO 87

Scale 1/8" = 1 foot

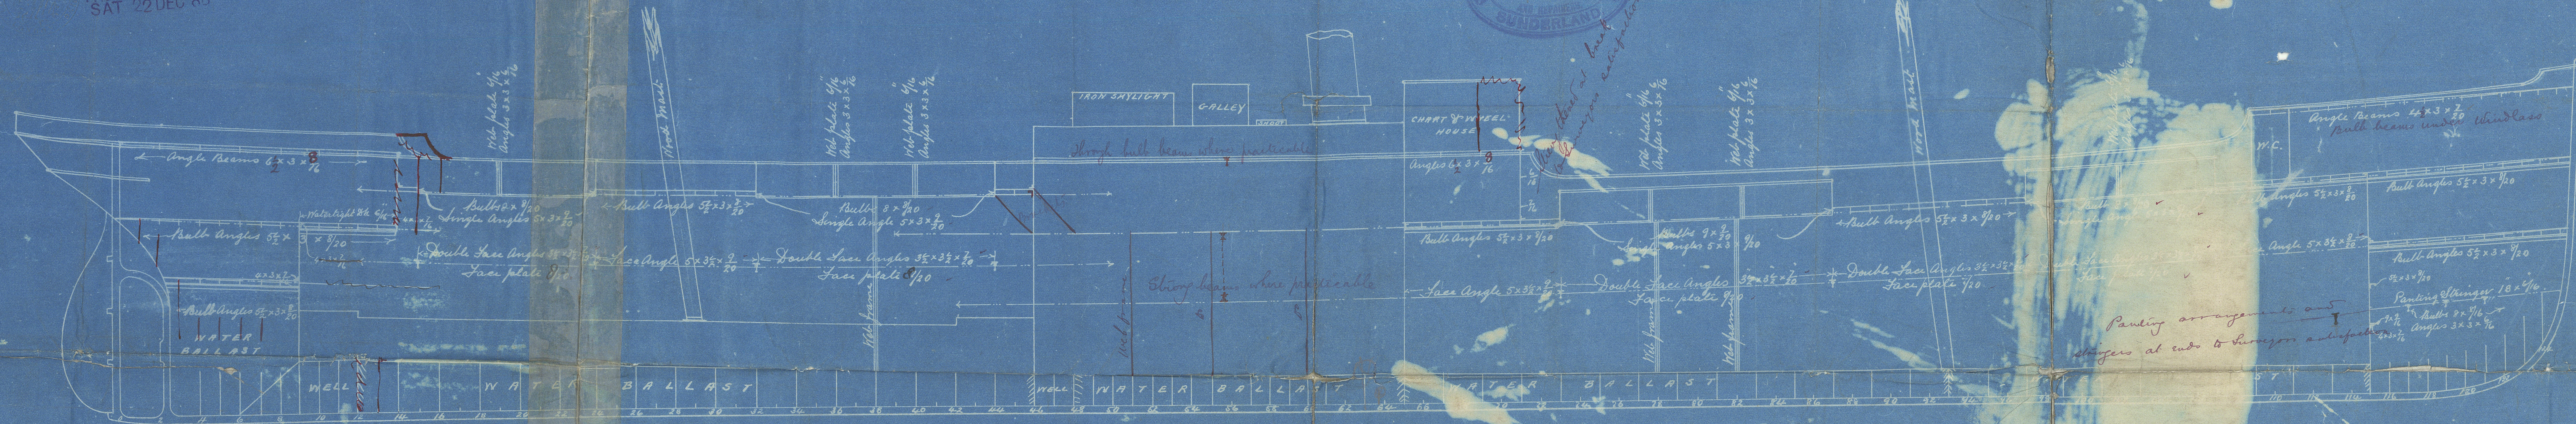

Strike of 1/4" plating at side of hatch increased 1/8" of an inch

Hatch 17'-3" x 12'-0"

Strike of 1/4" plating at side of Hatch increased 2/8" of an inch

Hatch 23'-0" x 16'-0"

Strike of main 1/4" plating increased 1/8" at sides of coamings



Strike of 1/4" plating at side of Hatch increased 3/8" of an inch



Hatch 26'-10" x 16'-0"

Strike of 1/4" plating at side of Hatch increased 1/8" of an inch

Hatch 26'-10" x 16'-0"





1889-

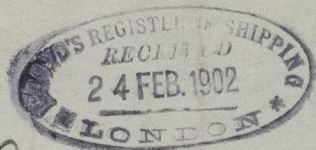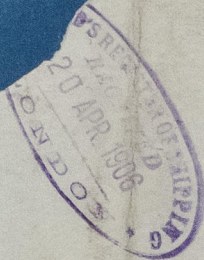

Eva


Slid 15136

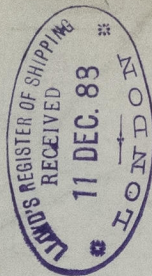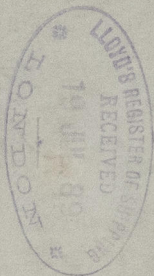

P. a D.

"Autania"

009058-009066-0143

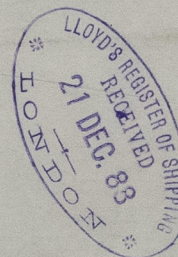

© 2021

Lloyd's Register
Foundation

0143