


SCALE $\frac{1}{4}$ = ONE FOOT.

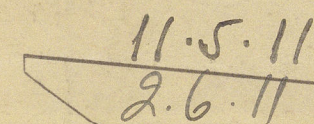

Pillars throughout to Surveyor's satisfaction

RIVETING

STRINGER PLATES, DOUBLE $\frac{3}{4}$ RIVETED BUTTS 5" BROAD, RIVETS SPACED 2 $\frac{5}{8}$ CR. TO
EDGES OF DECK PLATING SINGLE $\frac{3}{4}$ RIVETED 2 $\frac{5}{8}$ BROAD, RIVETS SPACED 3 $\frac{5}{8}$ CR. TO
DECK PLATING TO BEAMS. $\frac{3}{4}$ RIVETS SPACED 4 $\frac{1}{2}$ CR. TO CR.
BUTTS OF DECK PLATING $\frac{5}{8}$ RIVETED BUTTS 2 $\frac{5}{8}$ BROAD RIVETS SPACED 4 $\frac{1}{2}$ CR.

C. 7.
11. 5. 11.




009058-009066-9155

J. Duthie Tonnage S. B. Co.

Nos. 363-4.




Profile + Deck Plan.

363 S.S. "Daisy" 

Abn. Rpt. No. 10444.

364 S.S. "Esther"

Abn. Rpt. No. 10482.

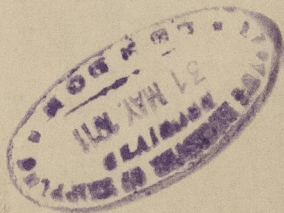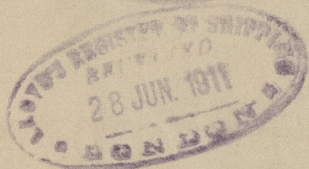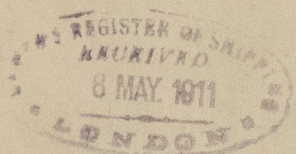

© 2021

Lloyd's Register
Foundation

009058-009066-0155