


11.5.11


BOTH FORGINGS.

SPEED ~~OVER 10 KNOTS~~ 10 & under 12 Knots.


Scale 1" = one foot

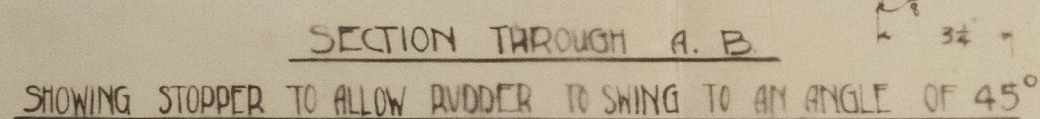

Scale 3" = one foot

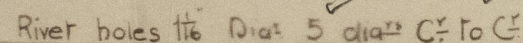

No holes in eye of boss

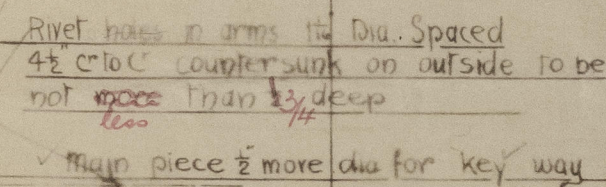

✓ Plate .86 Thick ✓

C. 7.
11.5.11




Lloyd's Register
Foundation

009058-009066-0156

J. Dulkie Long, S.B.C.

Nos. 363-4.


Rudder Frame.

³⁶³
S.S. "Daisy" 

Abn. Rpt. No. 10444

³⁶⁴
S.S. "Esther"

Abn. Rpt. No. 10482

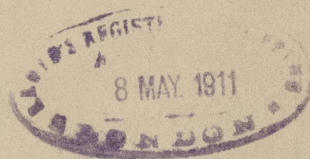

© 2021

Lloyd's Register
Foundation

009058-009066-0156