


<u>DIMENSIONS</u>	
LENGTH (L)	125 00' X
BREADTH (B)	22 50' X
DEPTH (D)	13 00' X
DEPTH (d)	11 66' X
TRANSVERSE N° (D+B)	= 35.50' X
LONGITUDINAL N° L(B+D)	= 4437.50' X

CLASS 100A1 ALLOYS

Scale $\frac{3}{4}'' = \text{one foot}$

EQUIPMENT


1st ANCHOR 12 CWT. STOCKLESS ✓
2nd ANCHOR 12 CWT. STOCKLESS ✓
3rd ANCHOR 3 CWT. EX STOCK ✓
200 Fathoms of 1 1/2" Stud link Chain ✓
150 Fathoms of 2 1/2" flexible galvanized steel Wire ✓

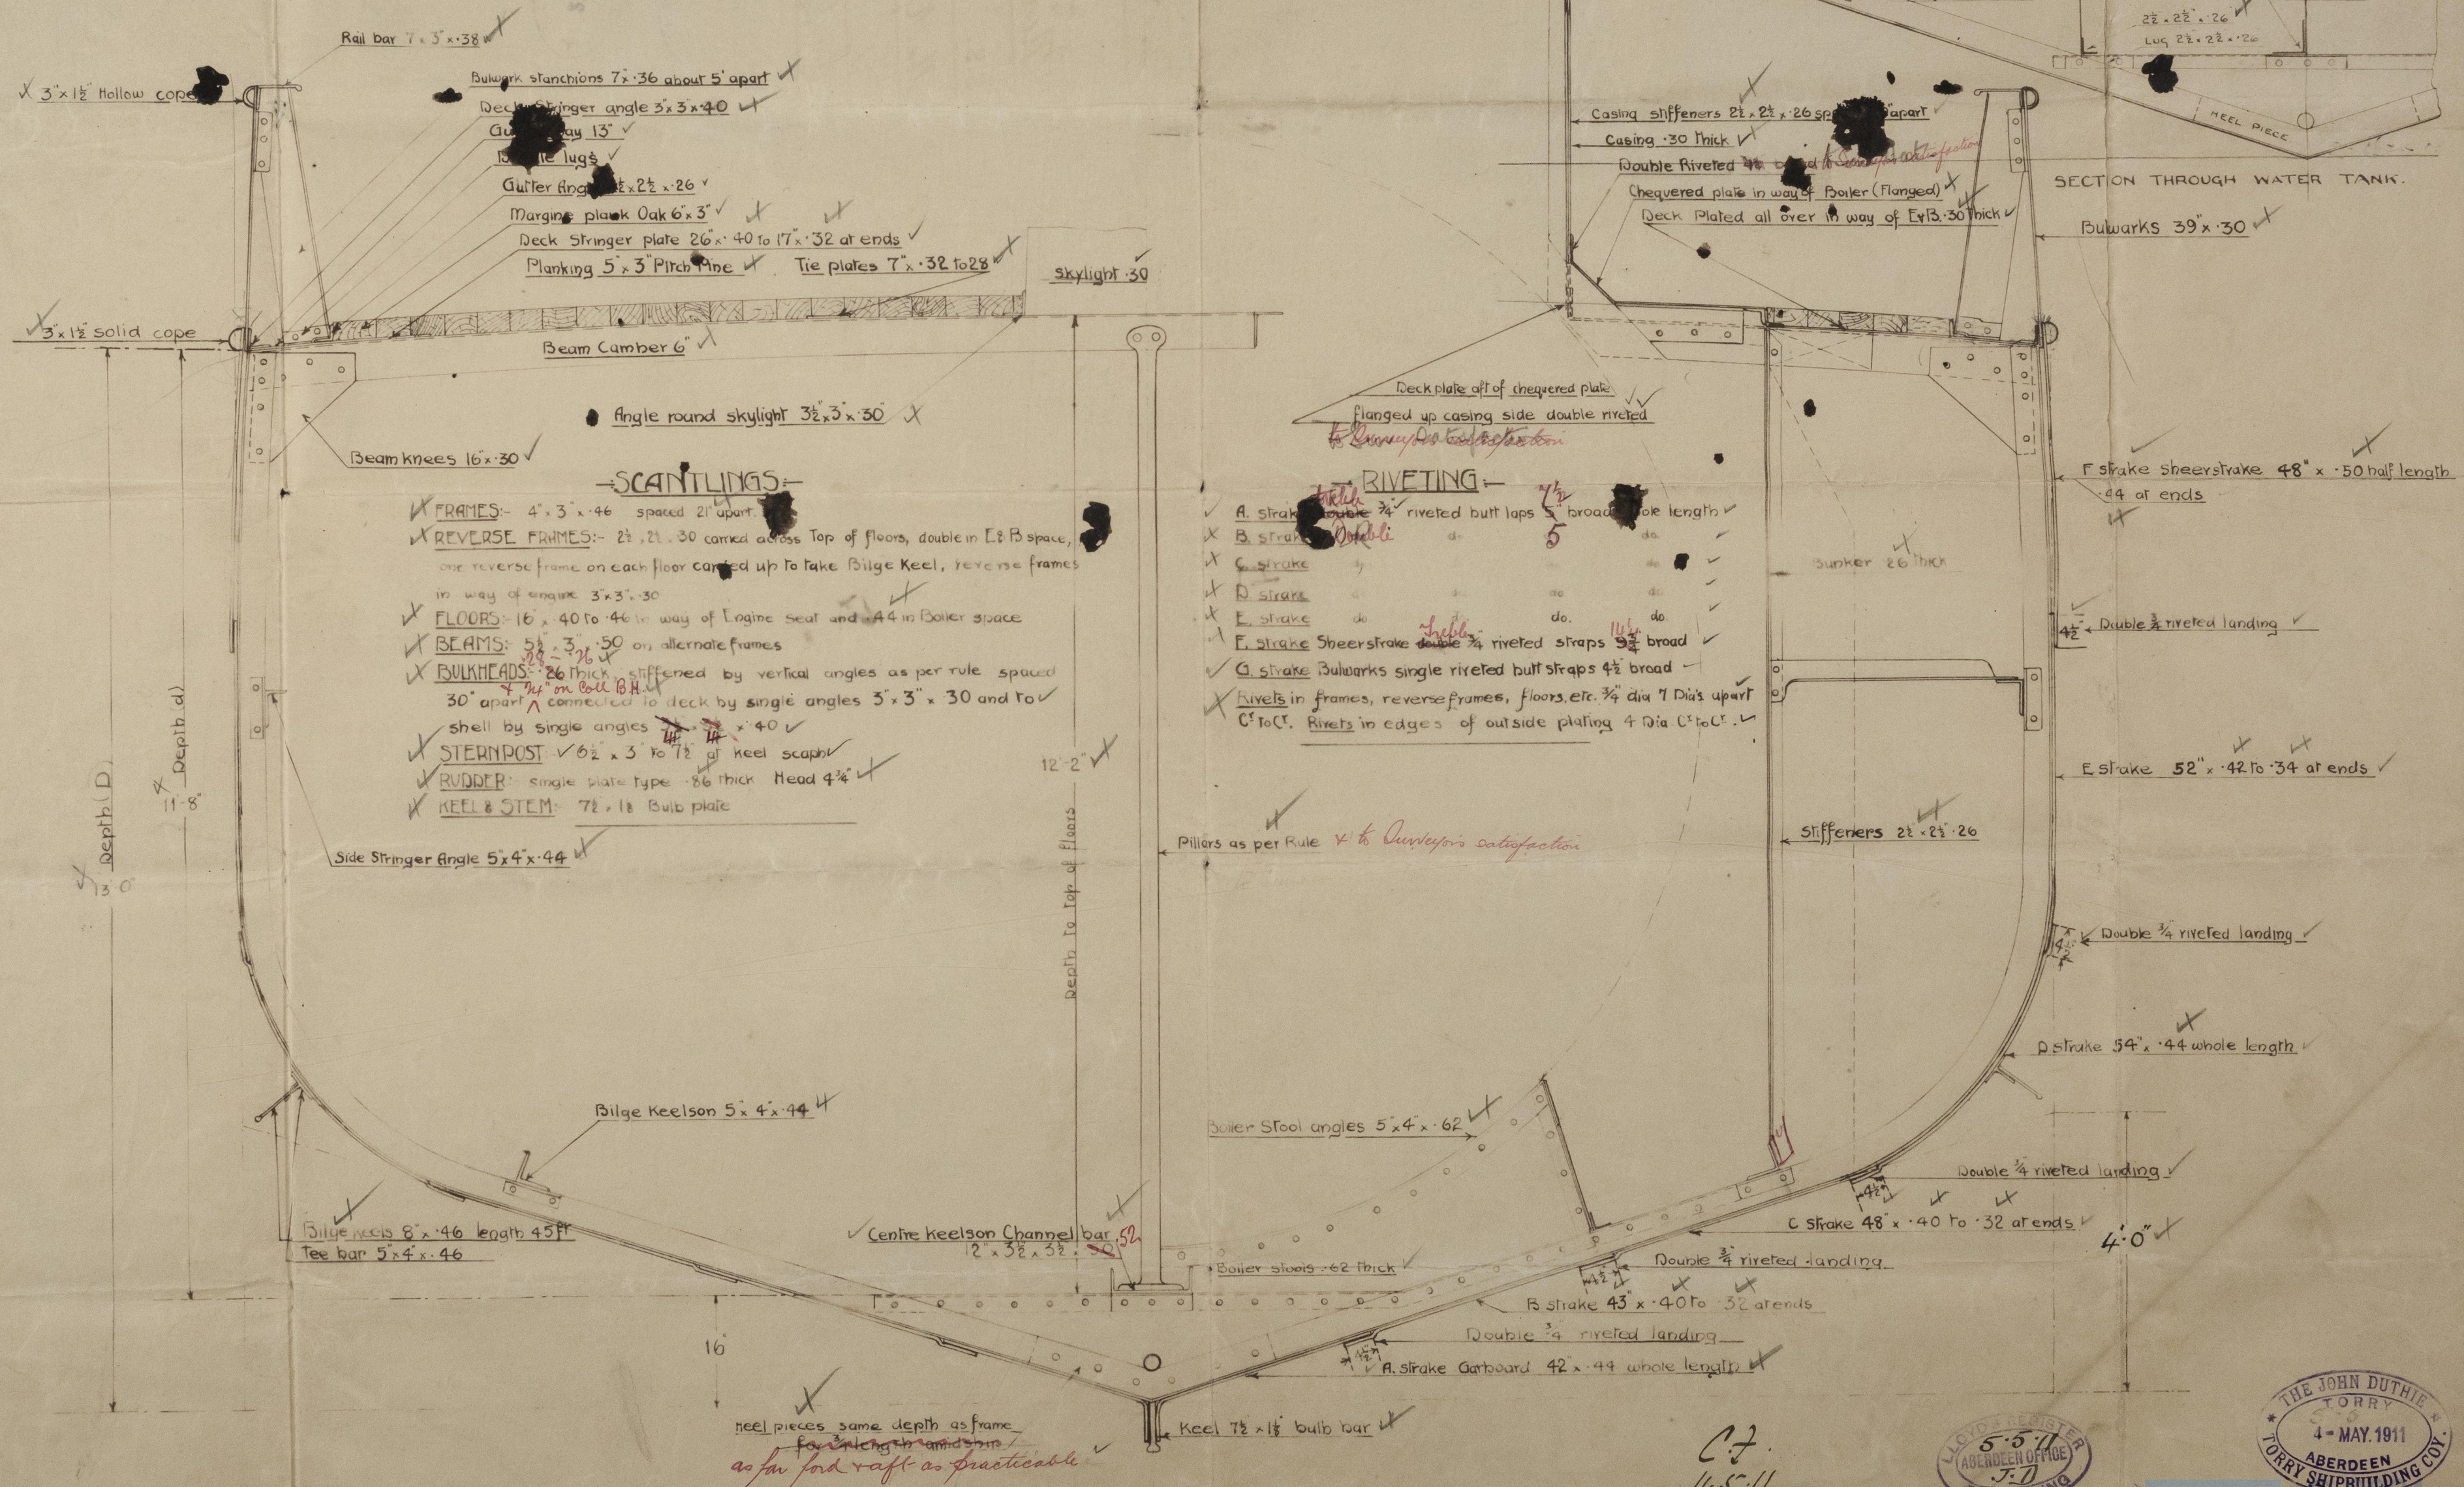

J. Duthie & Co. S.A.C.

Nos. 363-4.






Midship Section

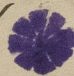³⁶³
S.S. "Daisy". 

Abn. Rpt. No. 10444.

³⁶⁴
S.S. "Esther".

Abn. Rpt. No. 10482.

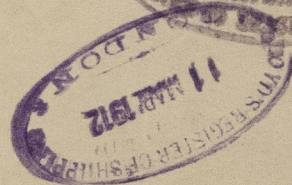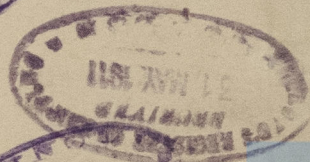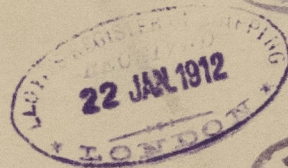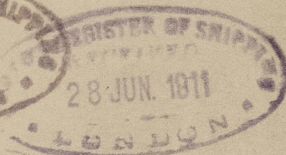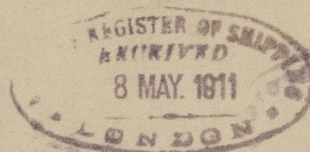

© 2021

Lloyd's Register
Foundation