


S.S. HOLLAND  
No. 121.



FORGED IRON RUDDER &  
STERNFRAME.

MATERIAL WITH LLOYDS TEST & CERTIFICATE.  
RUDDER AREA. 46.3 sq. ft.  
CENTRE OF GRAVITY ABT CENTRE LINE OF PINTLES 2.63 ft.  
46.3 x 2.63: 121.77  
SPEED ABOUT 9 1/4 KNOTS.

DETAILS OF SOLEPIECE:  
SCALE 6" = 1"

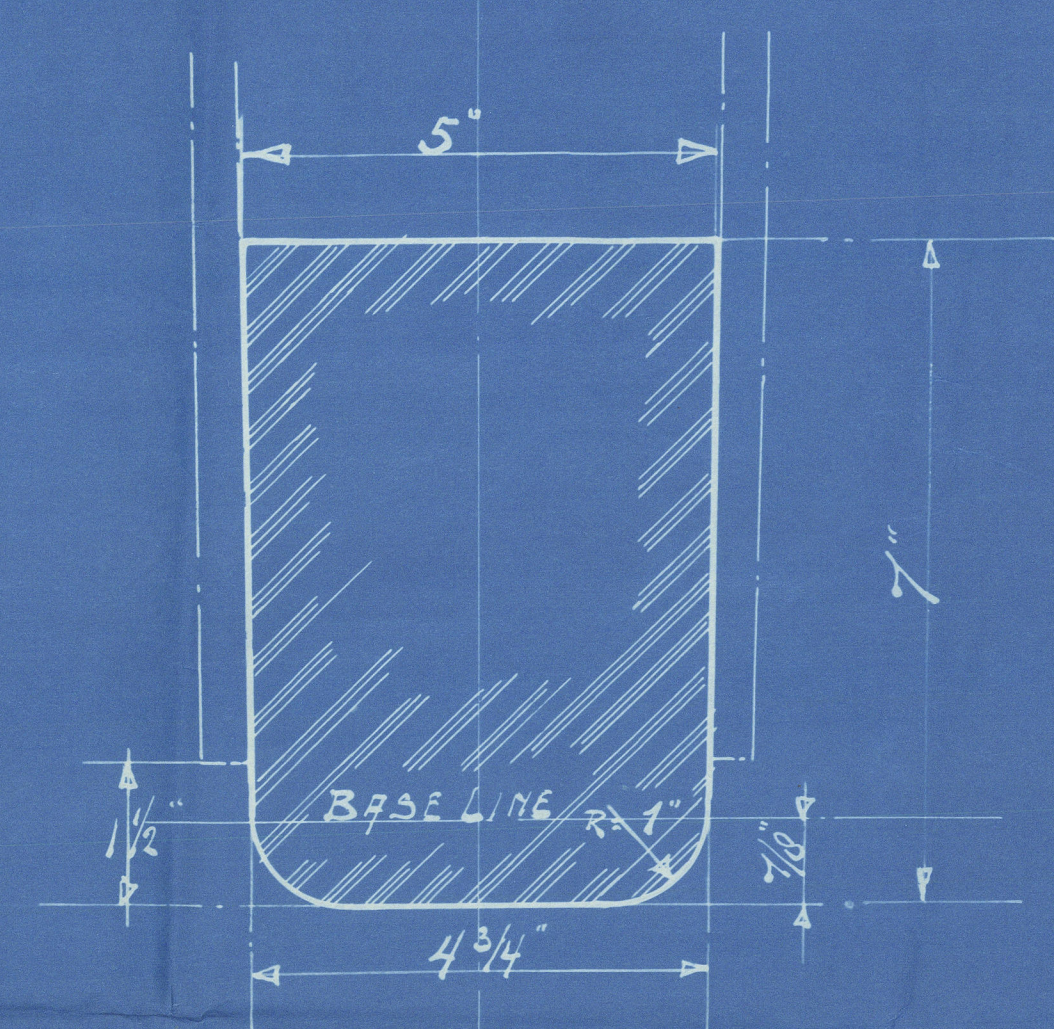


SECTION THROUGH FR 4.

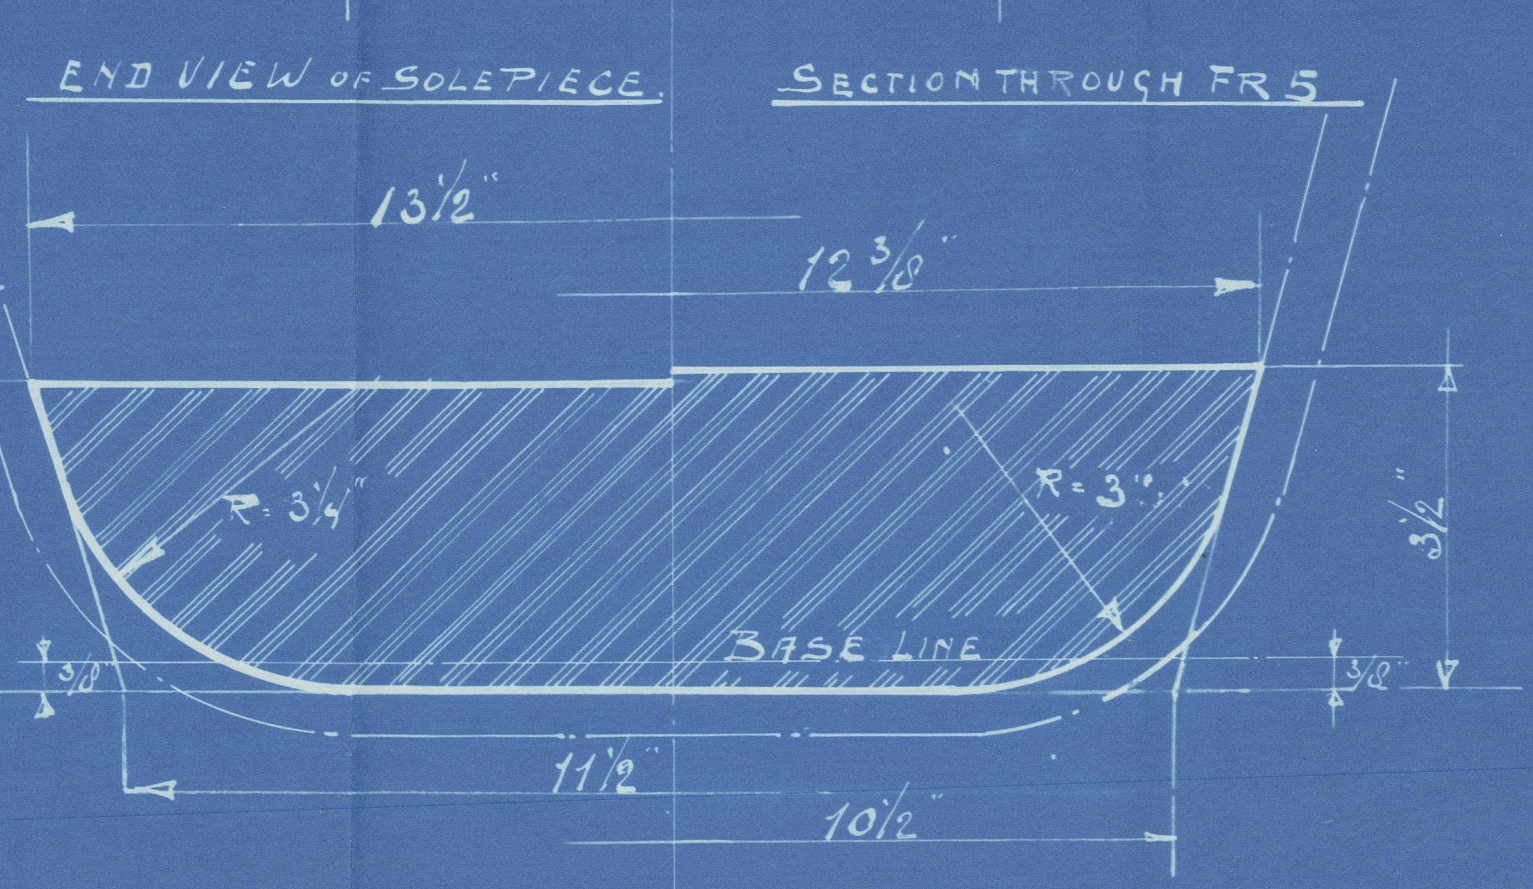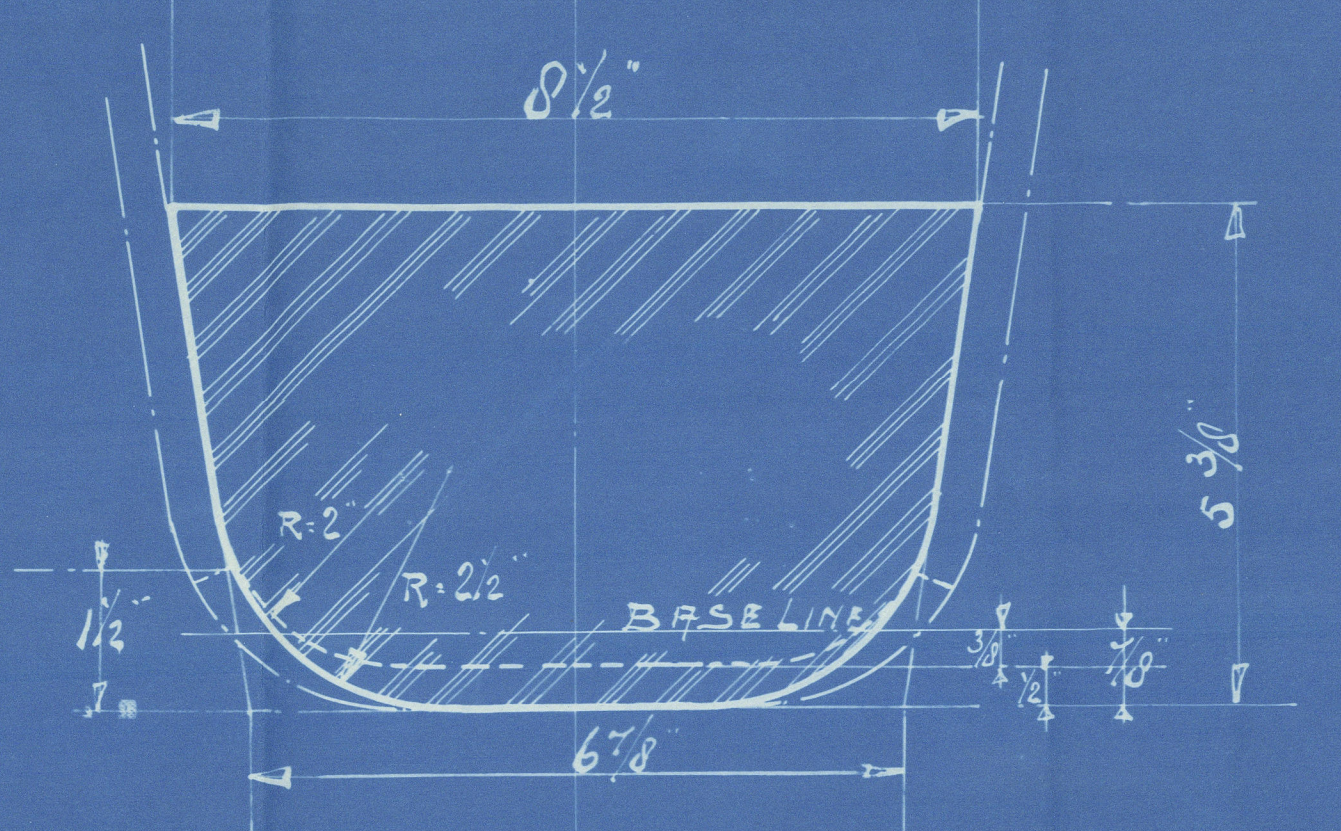

17-3-23  
1890  
SCHEEPSBOUW


DETAIL OF COUPLING.

SCALE 3" = 1"

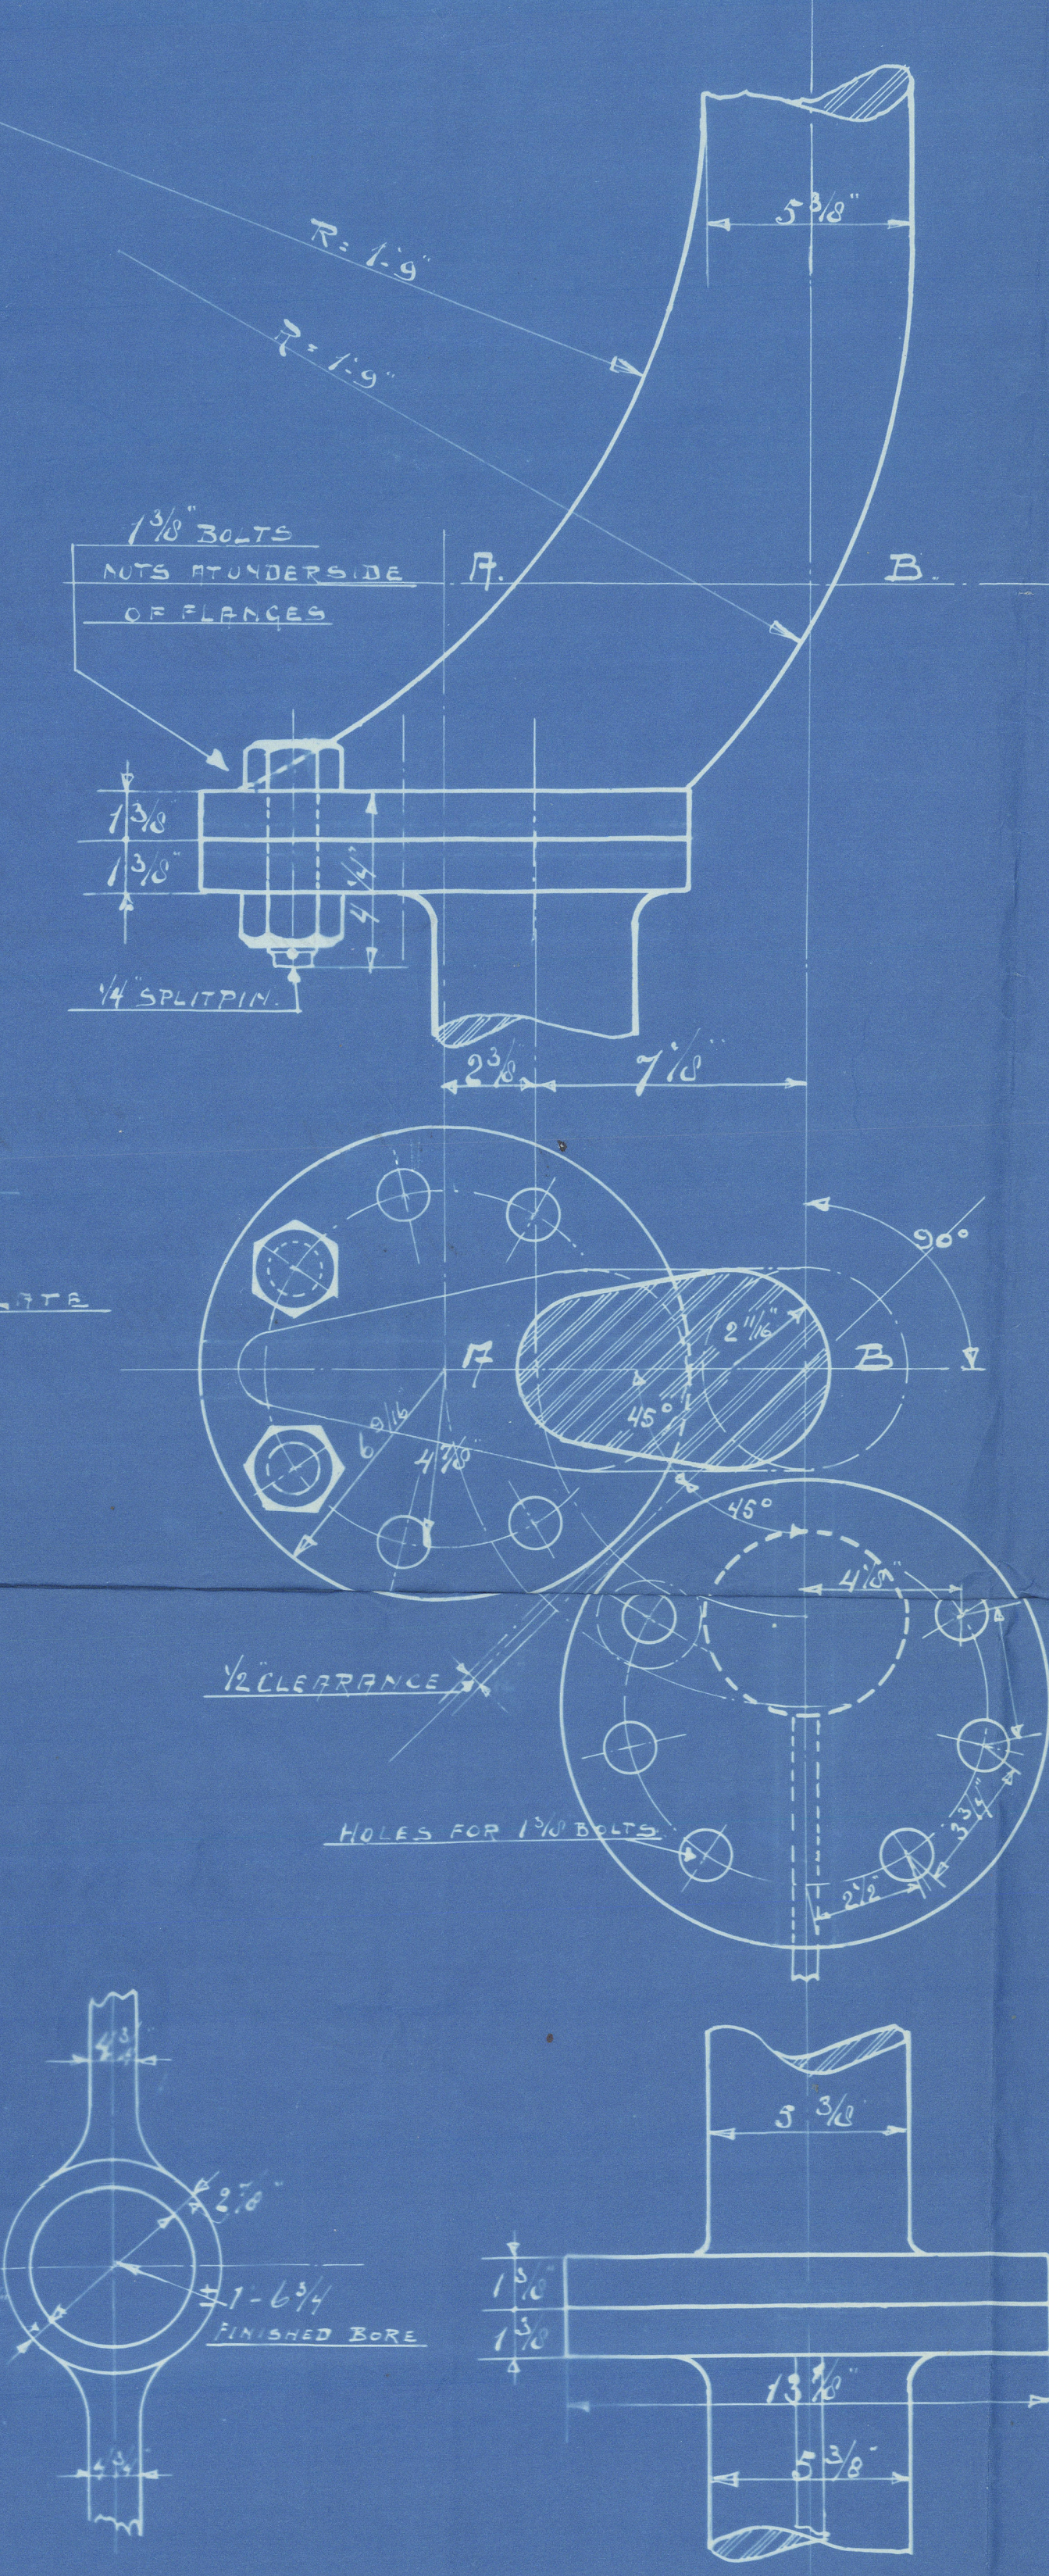


DETAIL OF PINTLES.

SCALE 6" = 1"

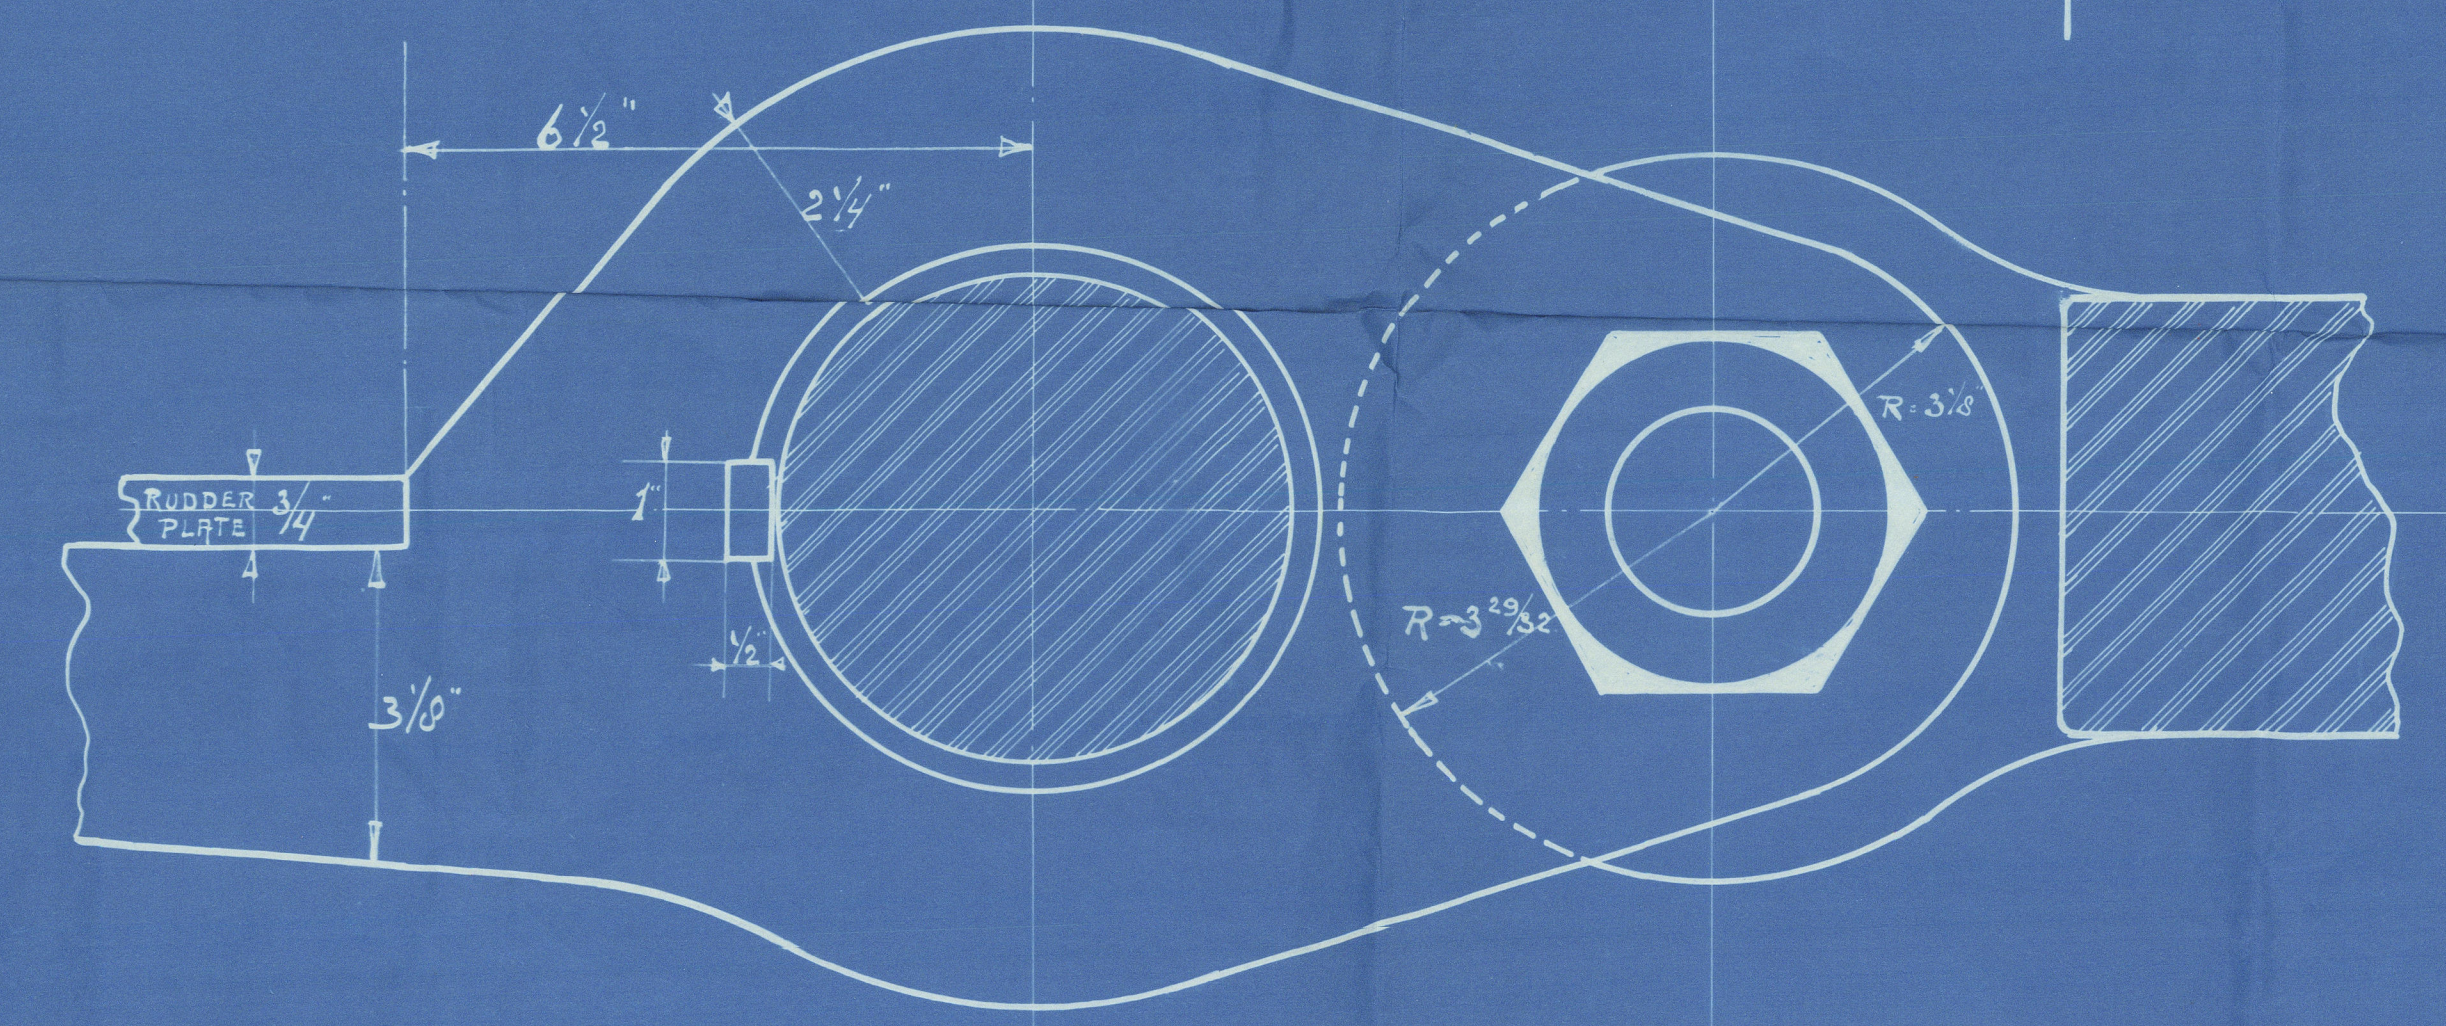


DETAIL OF BOTTOM  
GUDGEON.

SCALE 6" = 1"


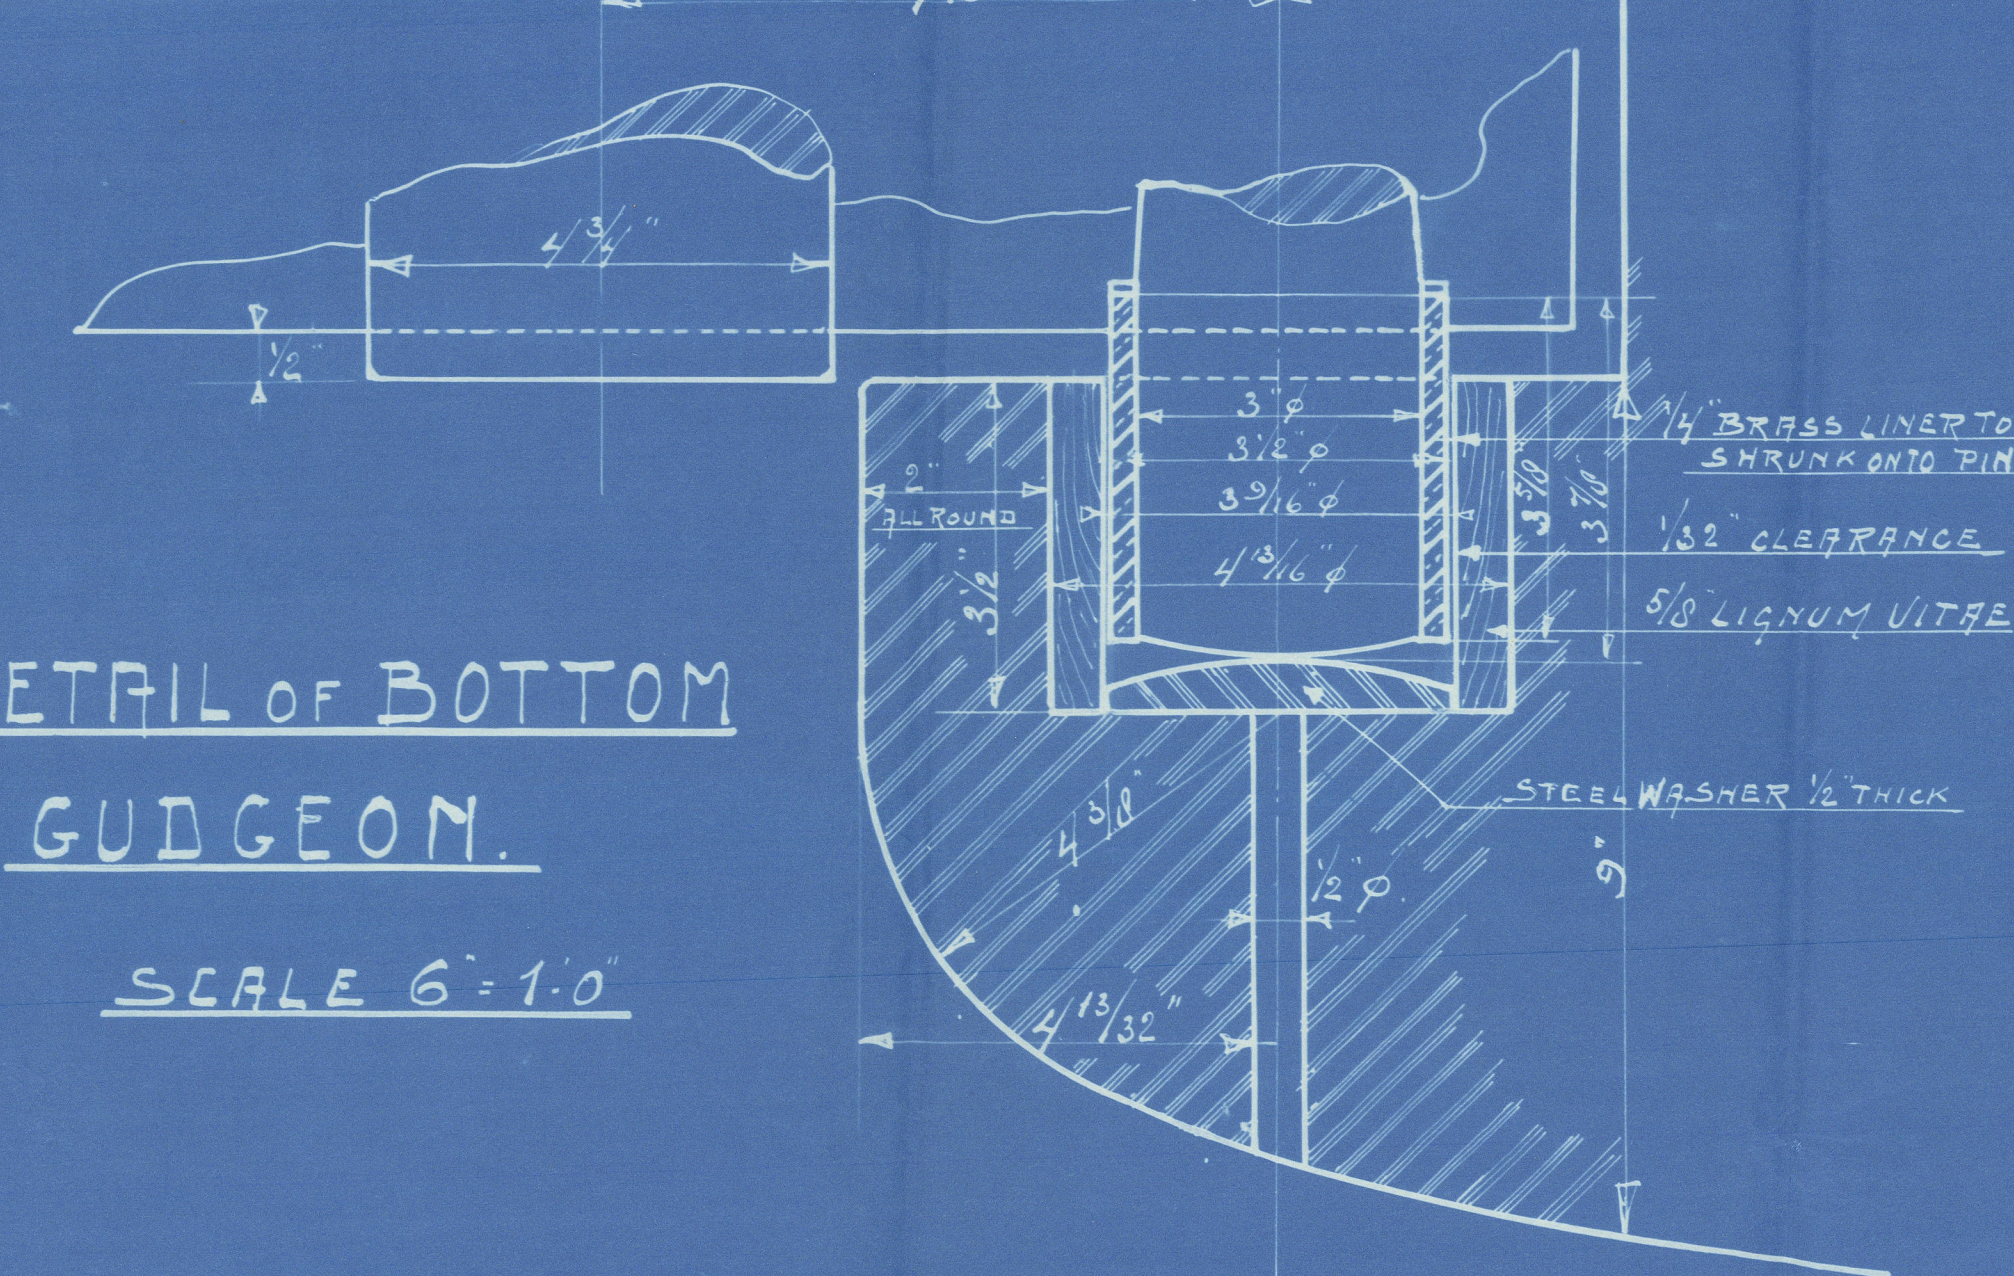


DETAIL OF EYE BOLT.

SCALE 3" = 1"

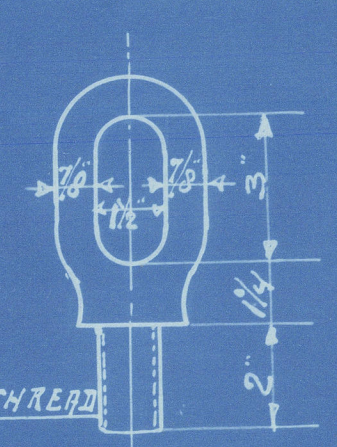

SCALE 3/4" = 1"

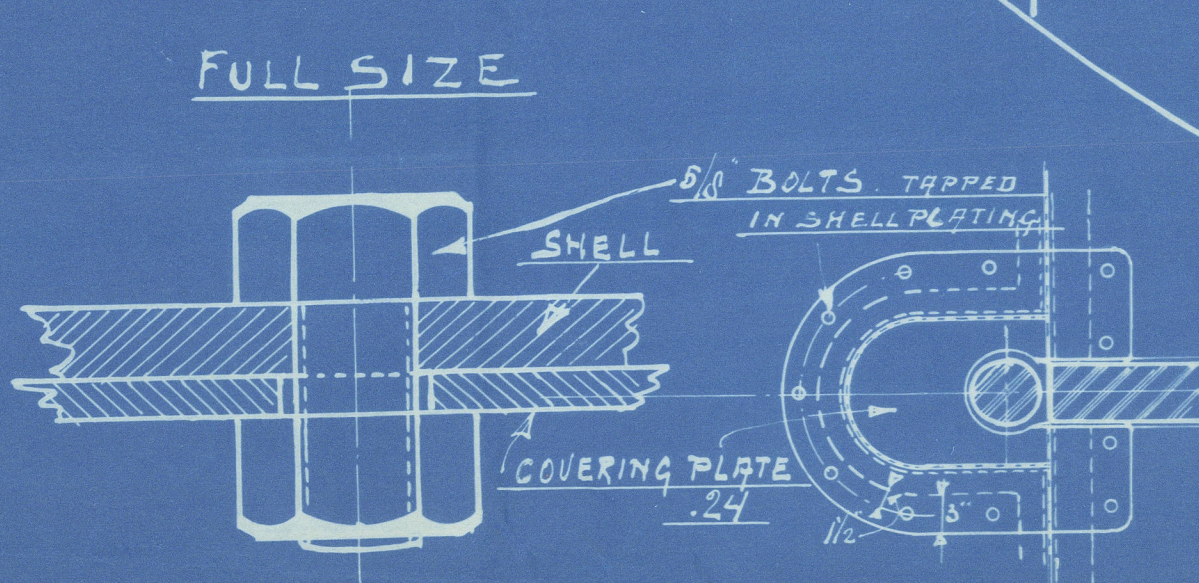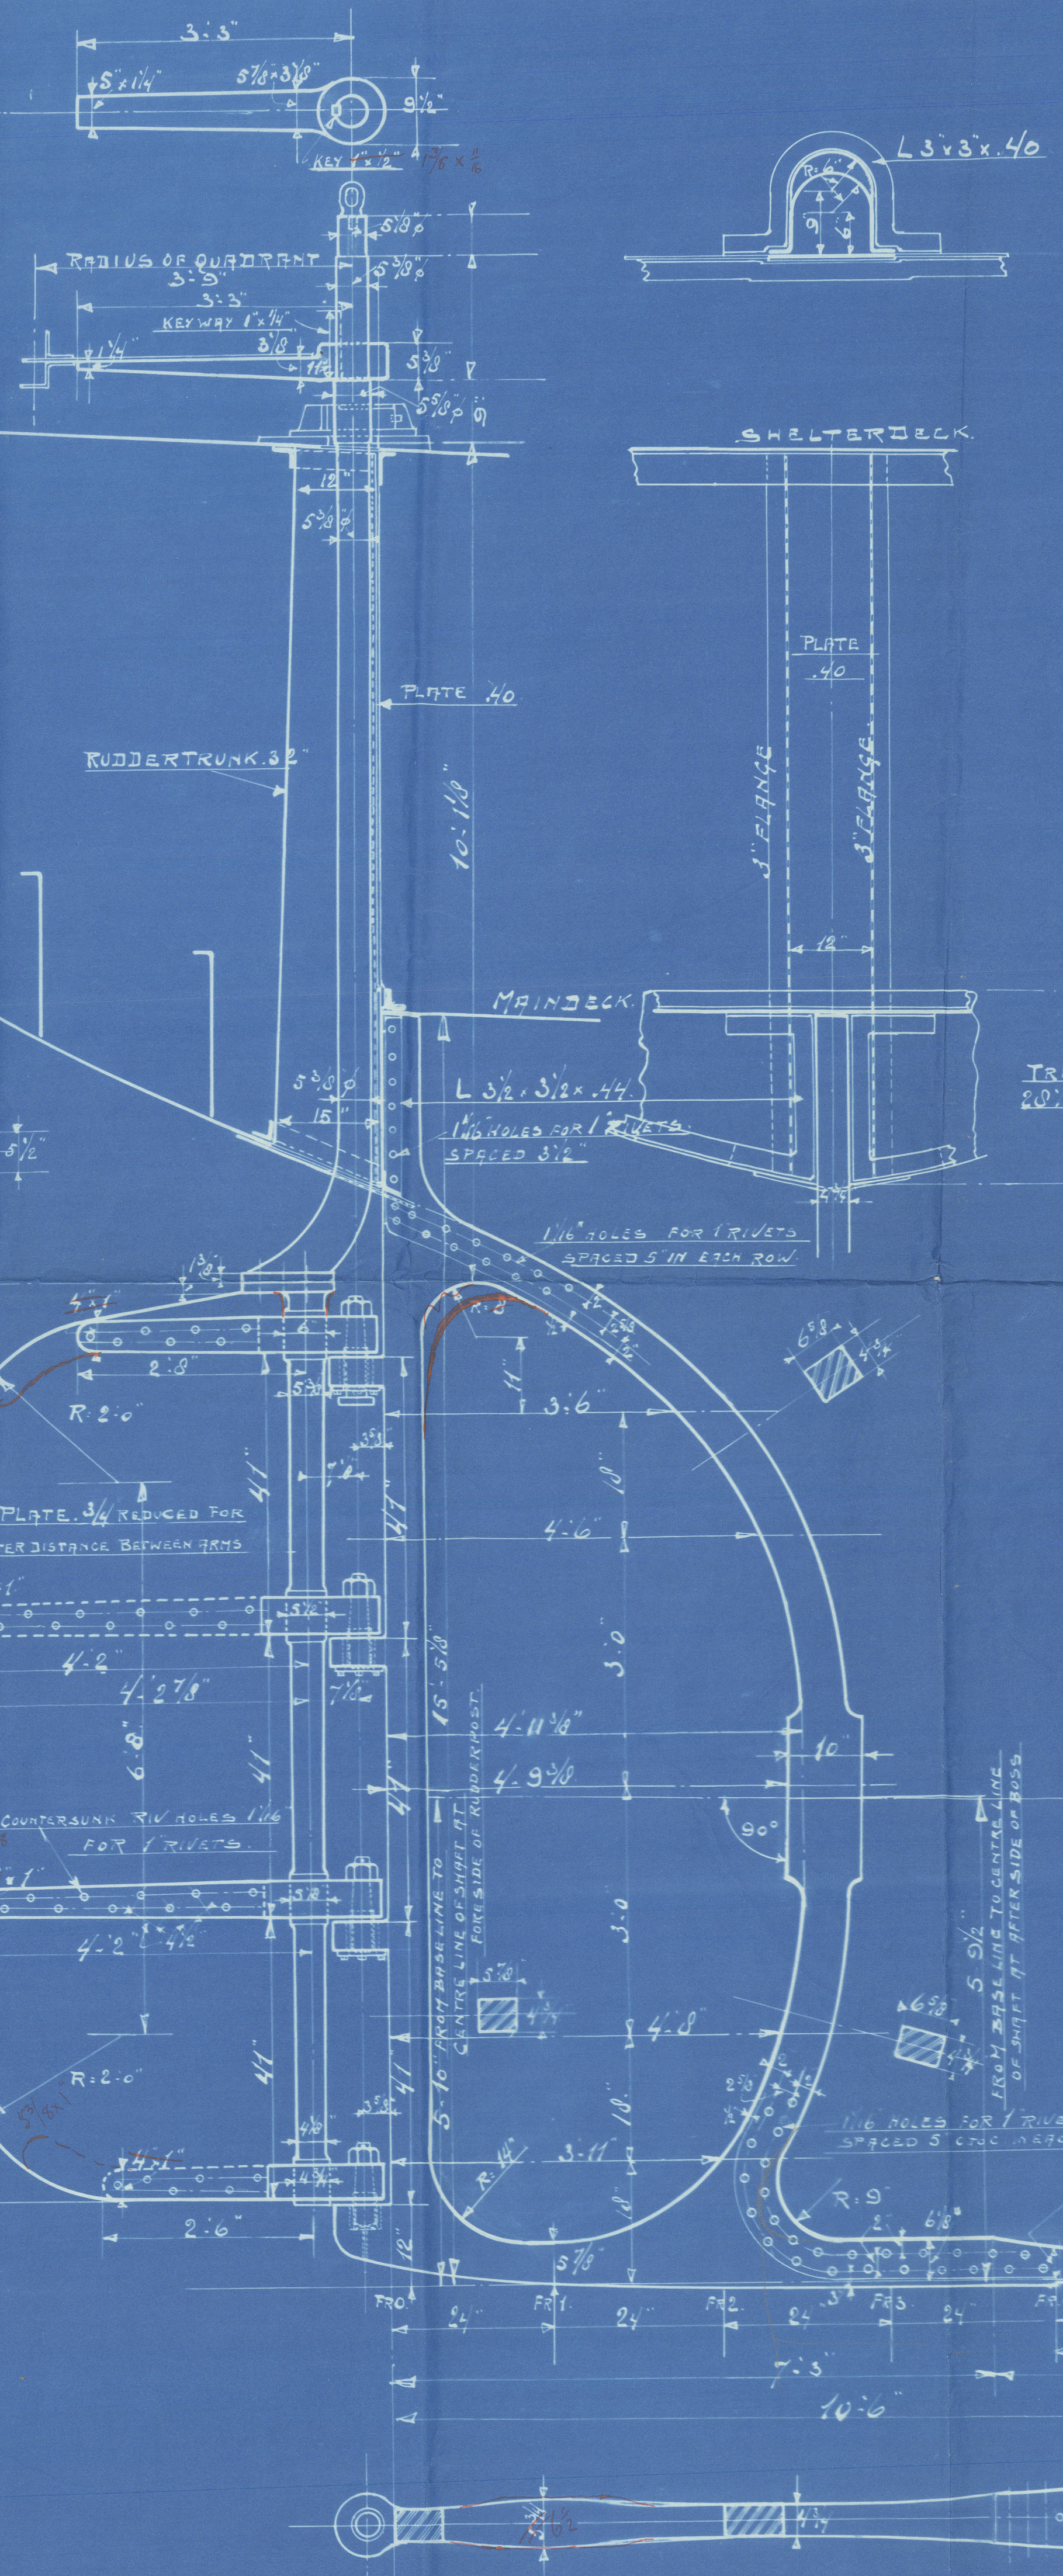

20-3-23  
C. Muller



*Stemframe*

Messrs The New Waterway S.B. Co

Yard No 121

Stemframe & Rudder Plan.

~~Gen. Doc 4026~~  
u

Ss Holland

Kott 13102



© 2021

Lloyd's Register  
Foundation

009067-009073-0110