


20/12/19


N° 504-II

PUMPING PLAN

SCALE 1/4" = ONE FOOT.

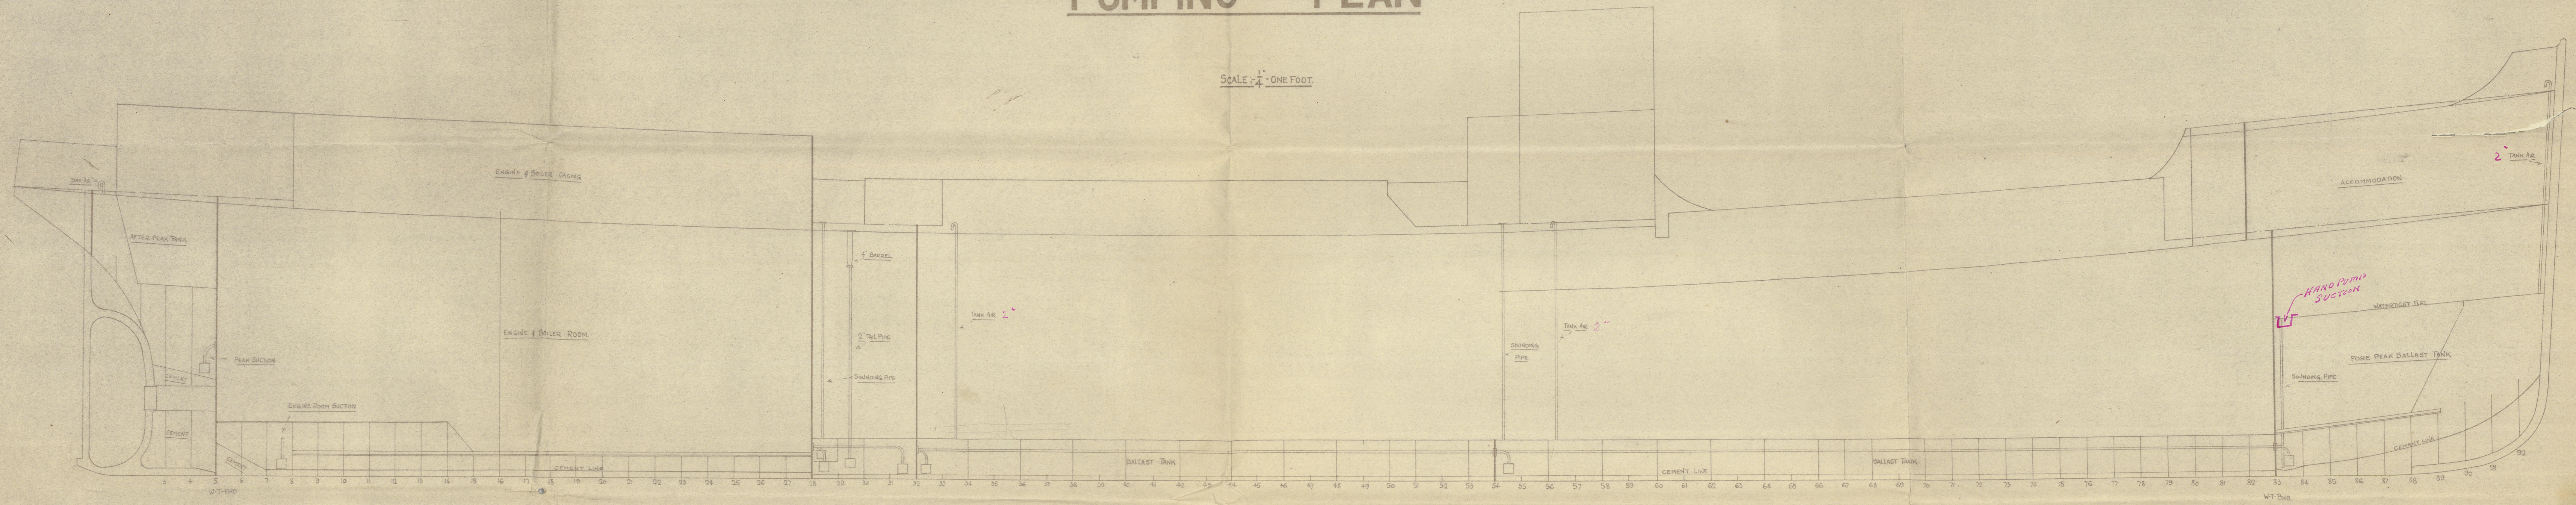

SUCTION PIPES THROUGHOUT TO BE OF CAST IRON WITH LEAD BENDS,
AND THOSE IN WAY OF BALLAST TANK TO BE RUN THRO' MANHOLES IN
FLOORS.

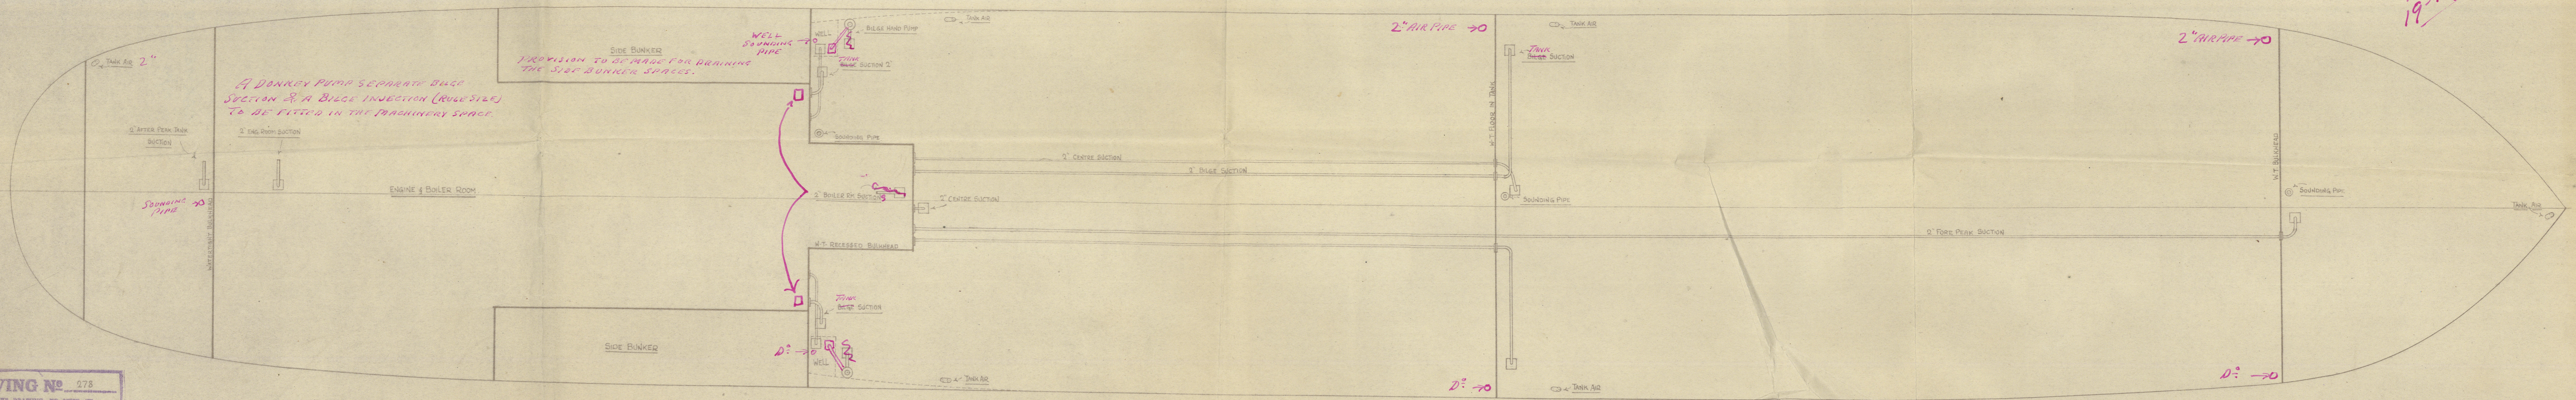

U.D.T. UNDER
500 TONS
19-12-19

Chambers Ltd.

P. As.

PLANS TRANSFERRED
TO SISTER VESSEL

S/S 504-11

Carmelita

'CARMELITA'

M/M. 9073

~~Yus B. 2684~~

Pumping Plan

"Royal Regis"

Lon. 8.5671

n. 51.0 Berriedale

009067-009073-0349

Lloyd's Register
Foundation