



20.11.19.

N<sup>o</sup>s 504 & 511  
STEEL SCREW STEAMERS

DIMENSIONS 168-0 B.P. 26-0 12-1/2 MLD.

PROFILE AND DECK PLAN

SCALE 1/4" = 1 FOOT

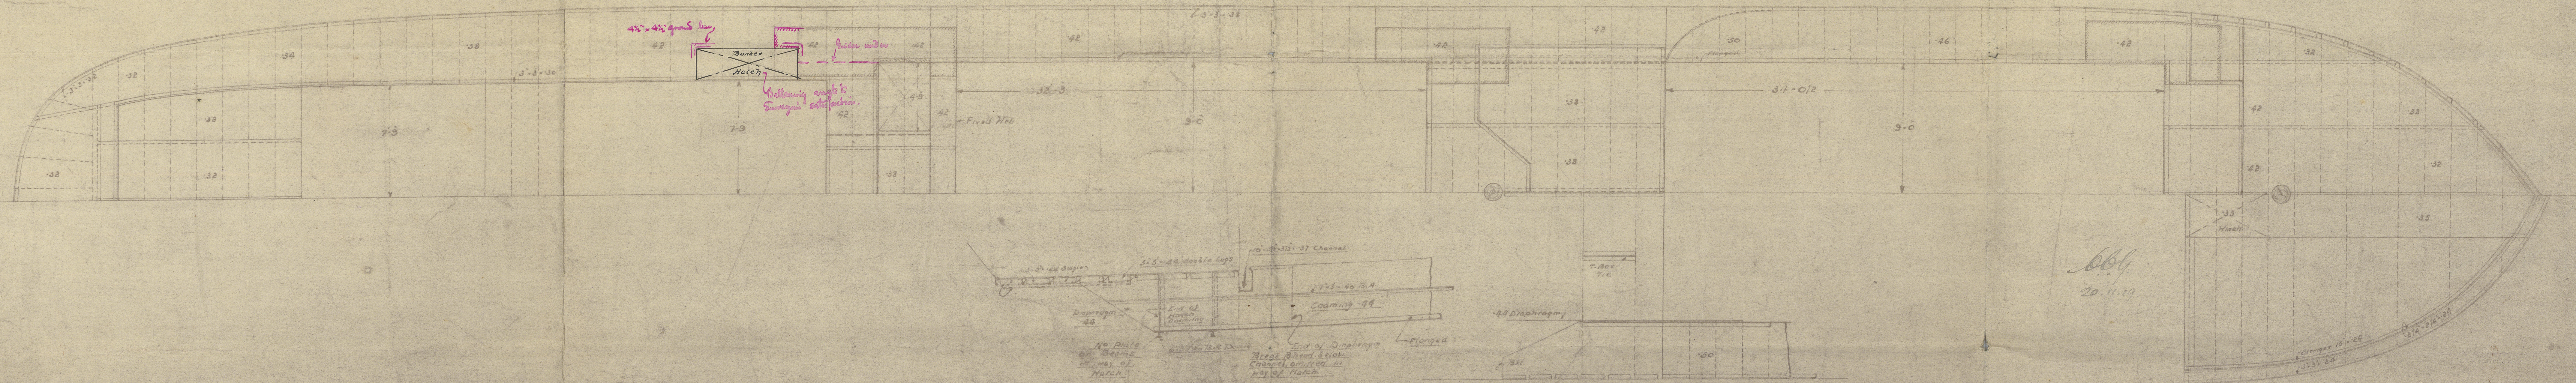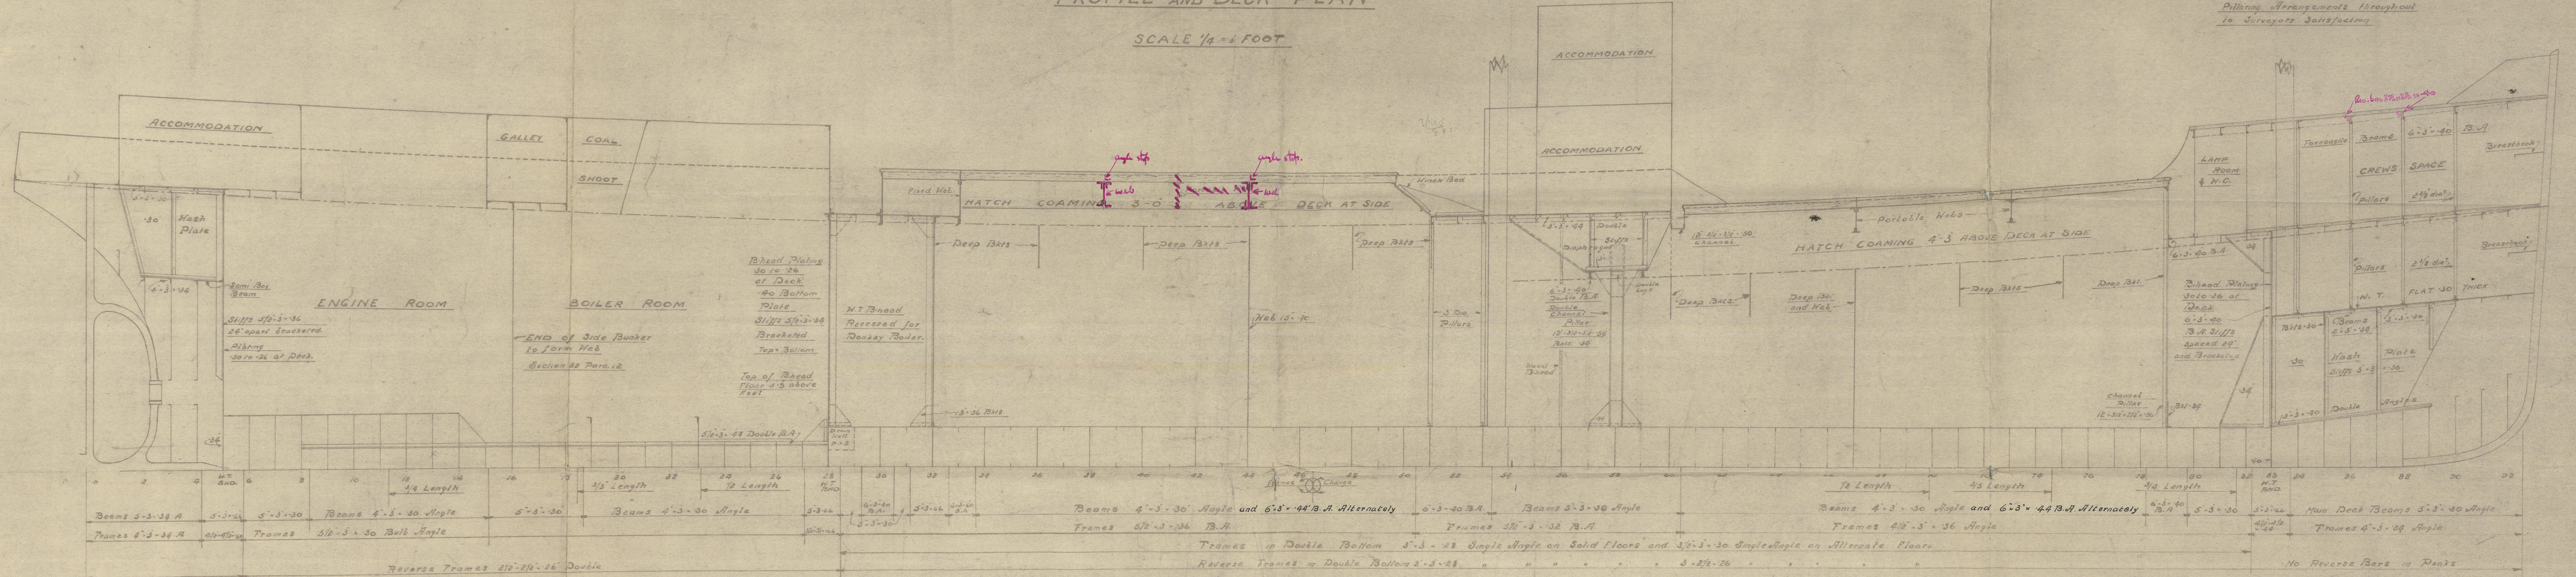



CHAMBERS

— 1 —

3048301

— 1 —

PROFILE

— 1 —

"Salcombe Regis"

"n. n. 'Rio Verde'"

Lon. Rpt. No. 84546.

Drs 221

Carmelita



© 2021

Lloyd's Register  
Foundation

009067-009073-0352