


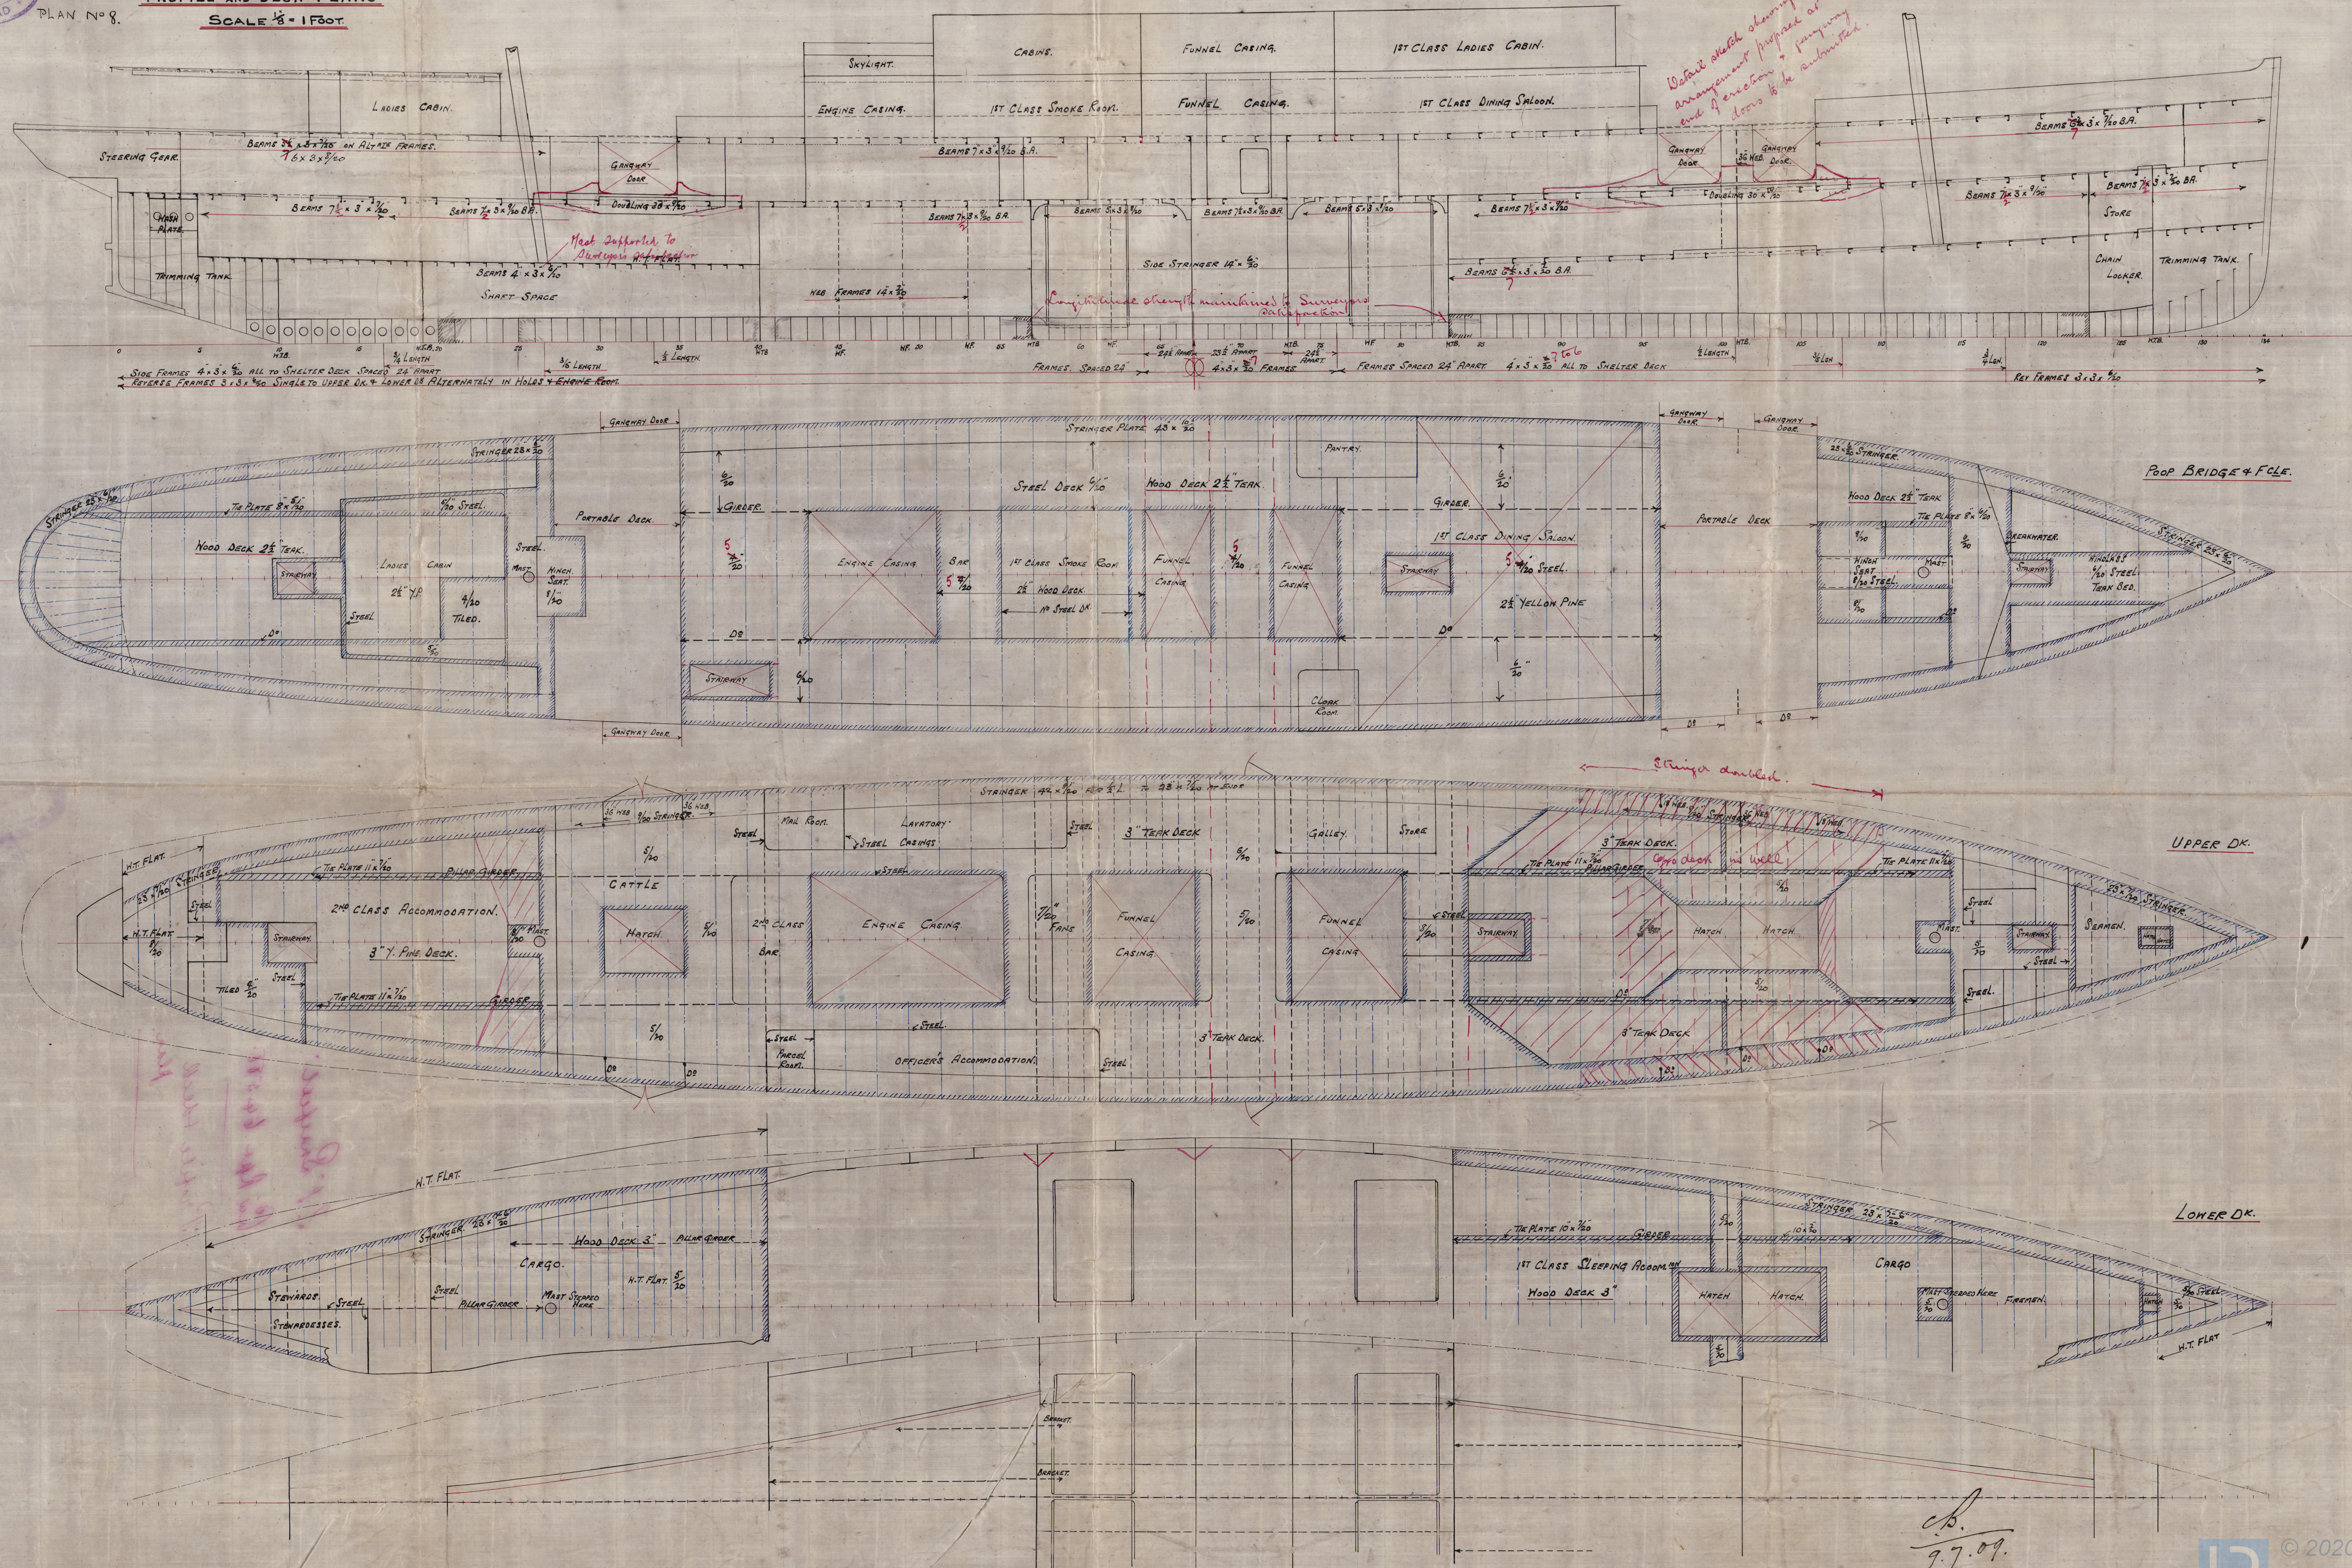

T.S.S. No 330
PROFILE AND DECK PLANS
PLAN No 8.
SCALE 1/8" = 1 FOOT

9.7.09
20.7.09
18.2.10.



9.7.09.

L. I. Snarell

Civ Rpt 64588.

Profile & deck
plan.

RETAIN

009074-009082-0058



08 9
© 2020

Lloyd's Register
Foundation