



14.11.11

— AMENDED —  
PROFILE & DECK PLANS S.S. 211  
LENGTH B.P. 335'-0" BREADTH EXT 48'-0" DEPTH 24'-10"  
SCALE  $\frac{1}{8}$ " = 1 FOOT.

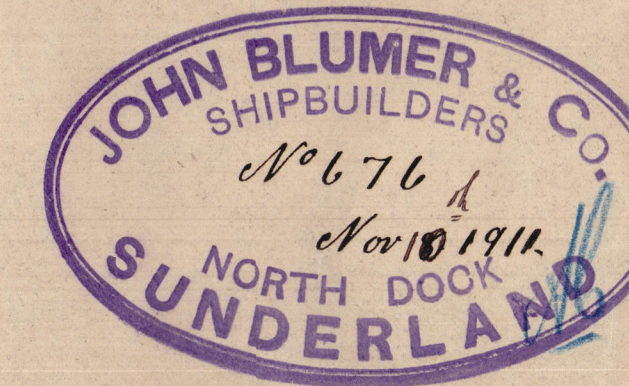


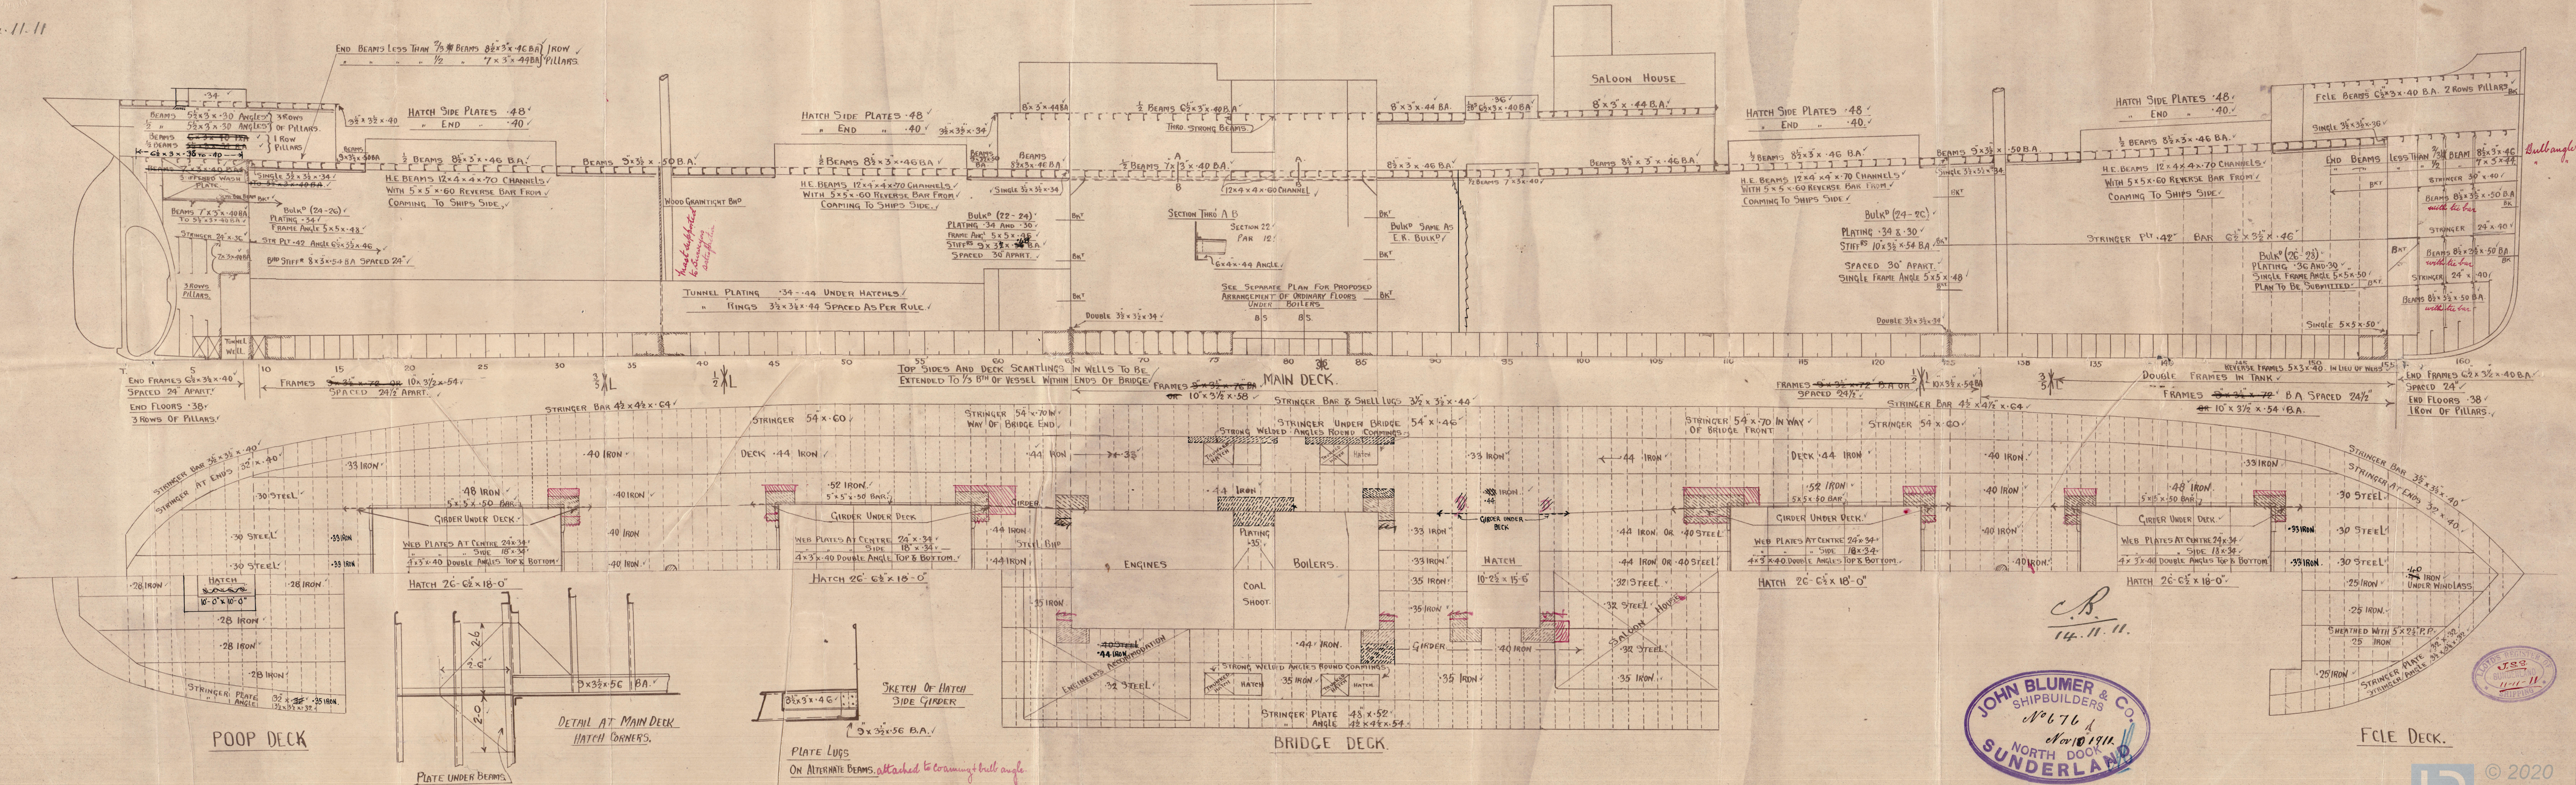


*St Wearwood.*  
*Sld. Rpt. No. 25282*  
*J Blumer & Co*

*No. 211*

*Further*

*Amended profile &*  
*decks*

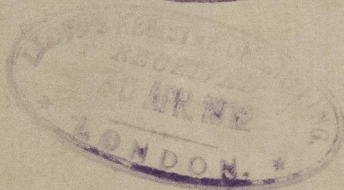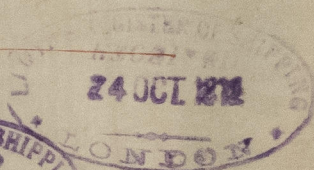

© 2020

Lloyd's Register  
Foundation

009074-009082-0143