
 


TABLE

CONNECTIONS	SIZE OF RIVET	SIZE OF BRACING
QUADRUPLE BUTTLAP	1"	4"
DOUBLE	3/4"	3"
SINGLE	3/4"	3"
DOUBLE	3/4"	3"
SINGLE	3/4"	3"
MAIN DK. STRINGER ANG. 5" x 5"	3/4"	3/4"
BRIDGE DK. STRINGER CHANNEL	3/4"	3/4"
POOP & FORECASTLE DK. STRINGER	3/4"	3/4"
MAIN DK. BEAMS	3/4"	3/4"
POOP, BRIDGE & FORECASTLE DK. BEAMS	3/4"	3/4"

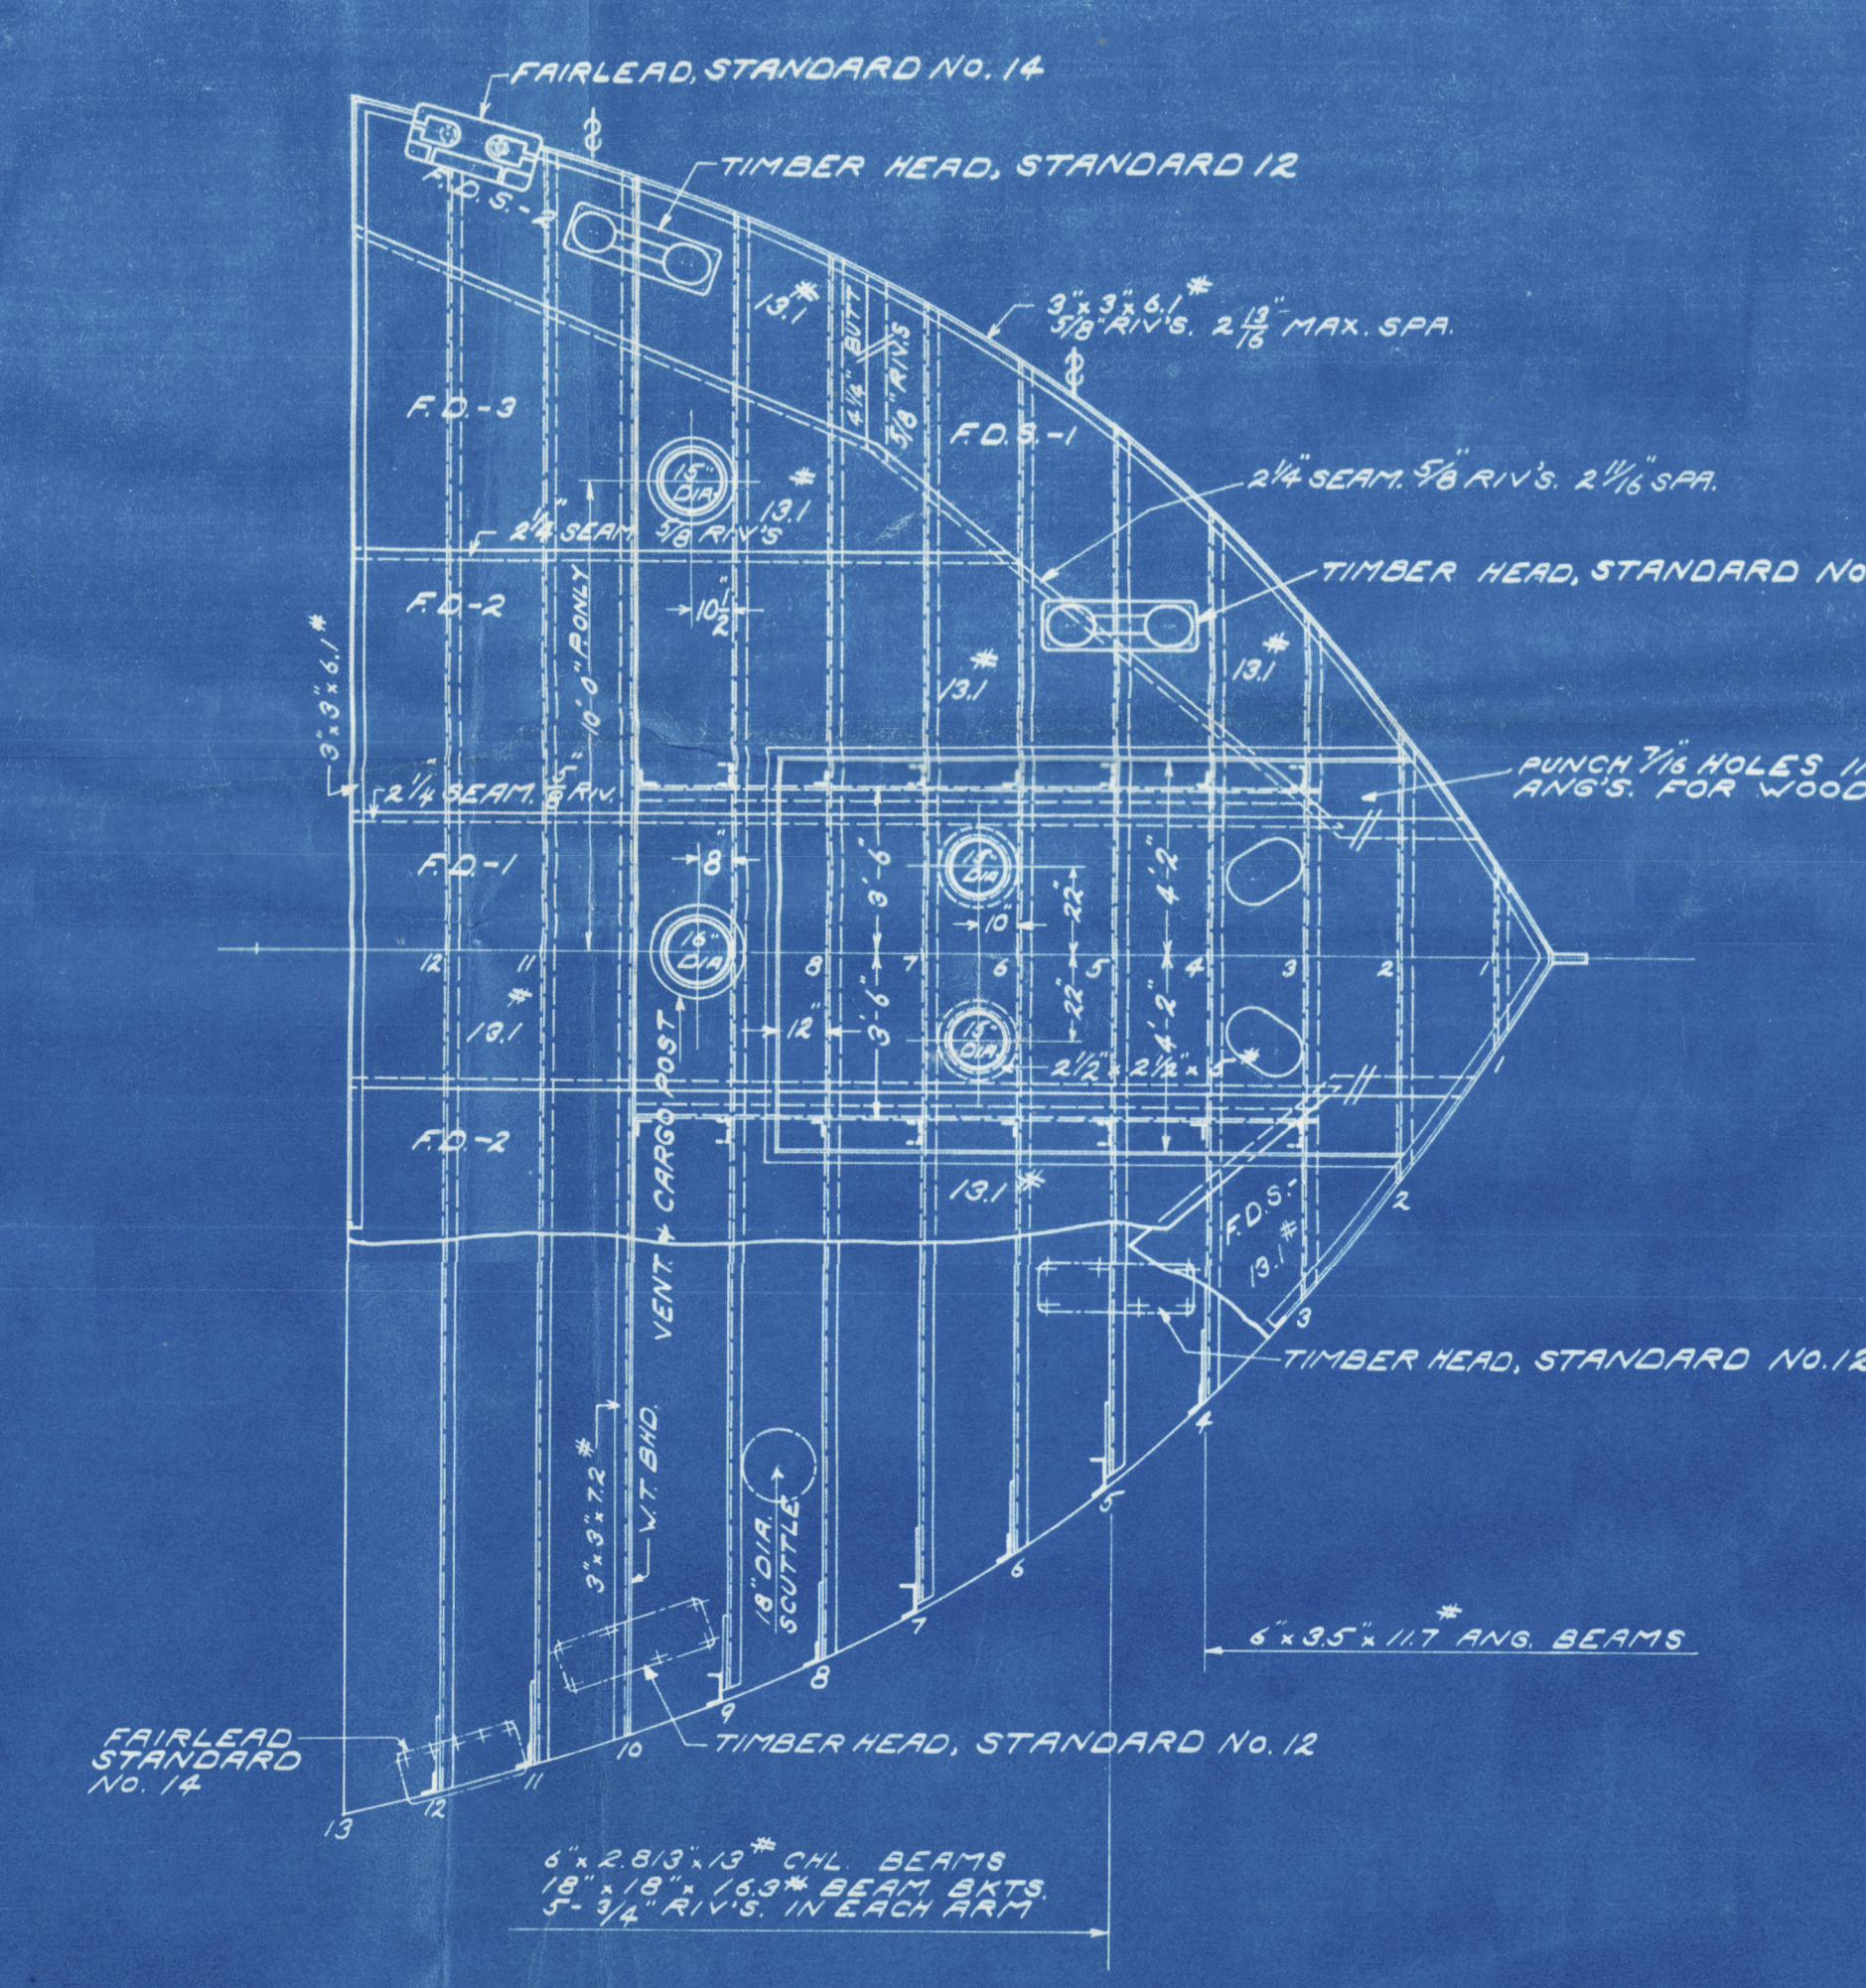

APPROVED  
NOV 14 1919  
J. Baccant


STR. N<sup>o</sup> 493  
DECK PLANS

PRINTED 3/14  
ISSUED NOV 11 1919  
SCALE 1/8" = 1' FOOT

AM. S. B. Co.  
Nov. 7, 1919

DRAWING NO. 10  
TRACING NO. 493-10



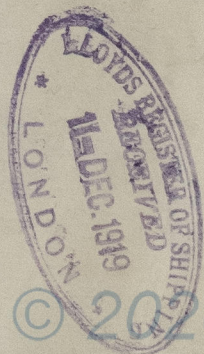

© 2020

Lloyd's Register  
Foundation

009034-009082-0197