


Asano Sdy Co.

NOS 38-39. *Gen Box 2424*


RUDDER, STERN FRAME & SHAFT BRACKET.

SCALE 1/2 TO ONE FOOT.

*L. J. Gings manu
y/ka 2881*

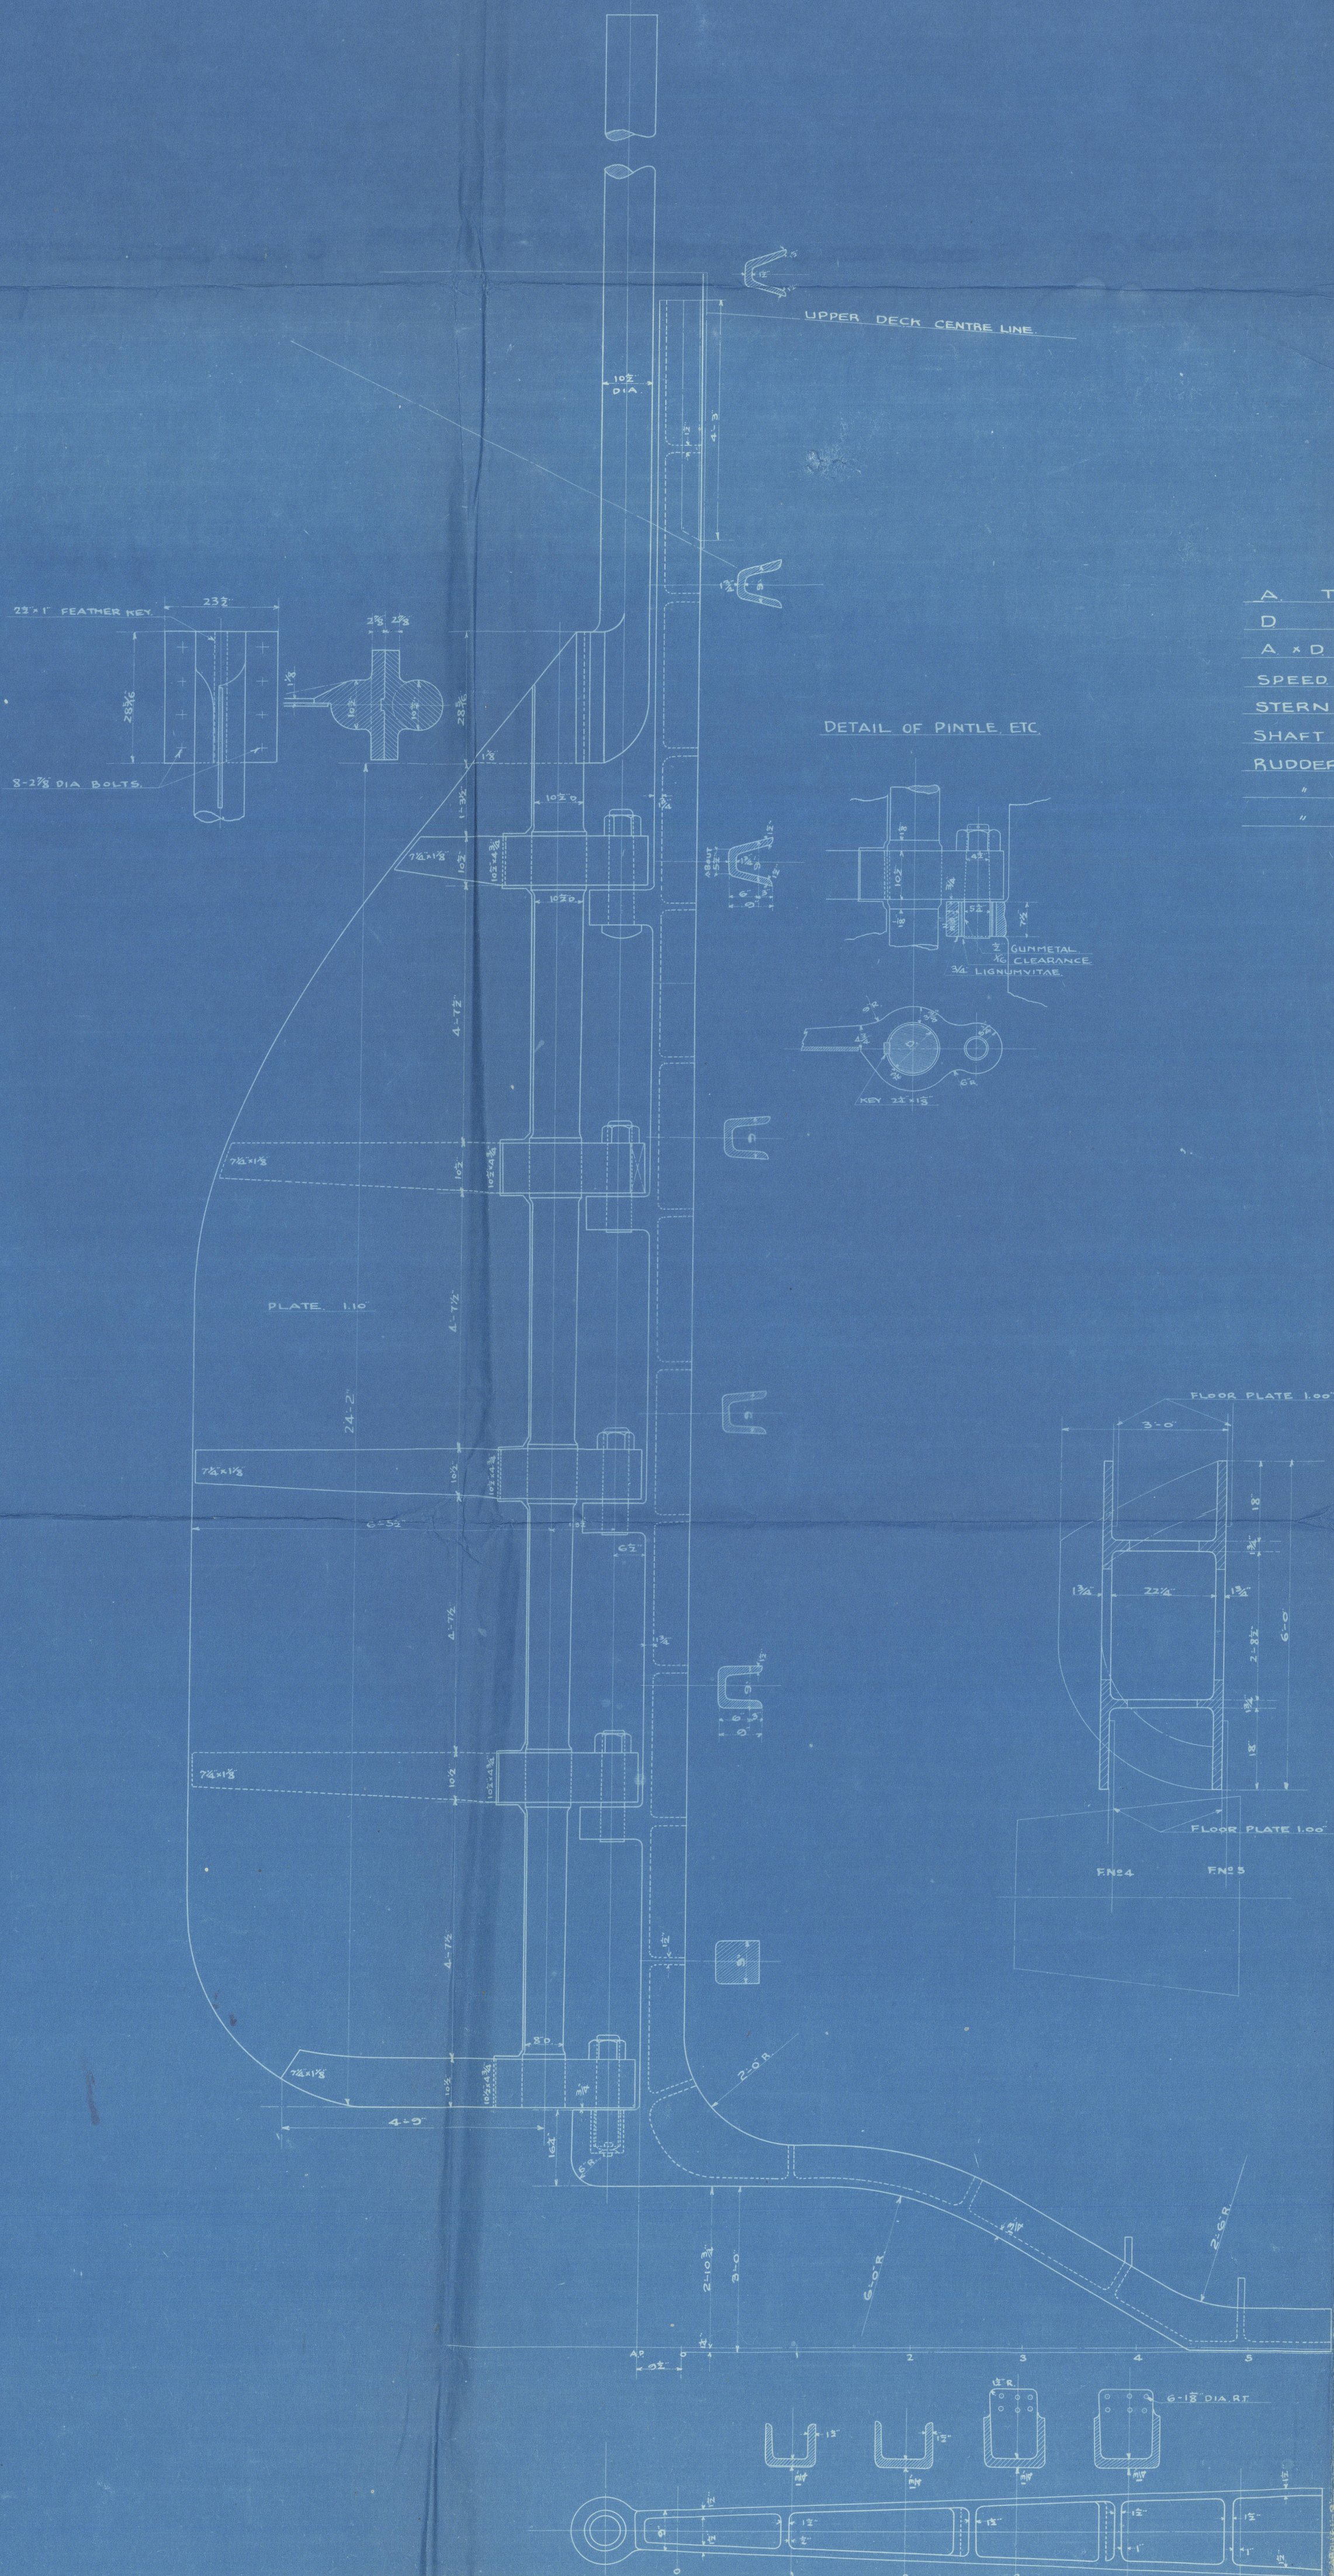

PARTICULARS	
A TOTAL	151.28 SQ. FT.
D	3.76 FT.
A x D	568.81
SPEED	12.0 KNOTS
STERN FRAME	CAST STEEL
SHAFT BRACKET	DO
RUDDER STOCK	FORGED STEEL
FRAME	DO
PINTLE	DO

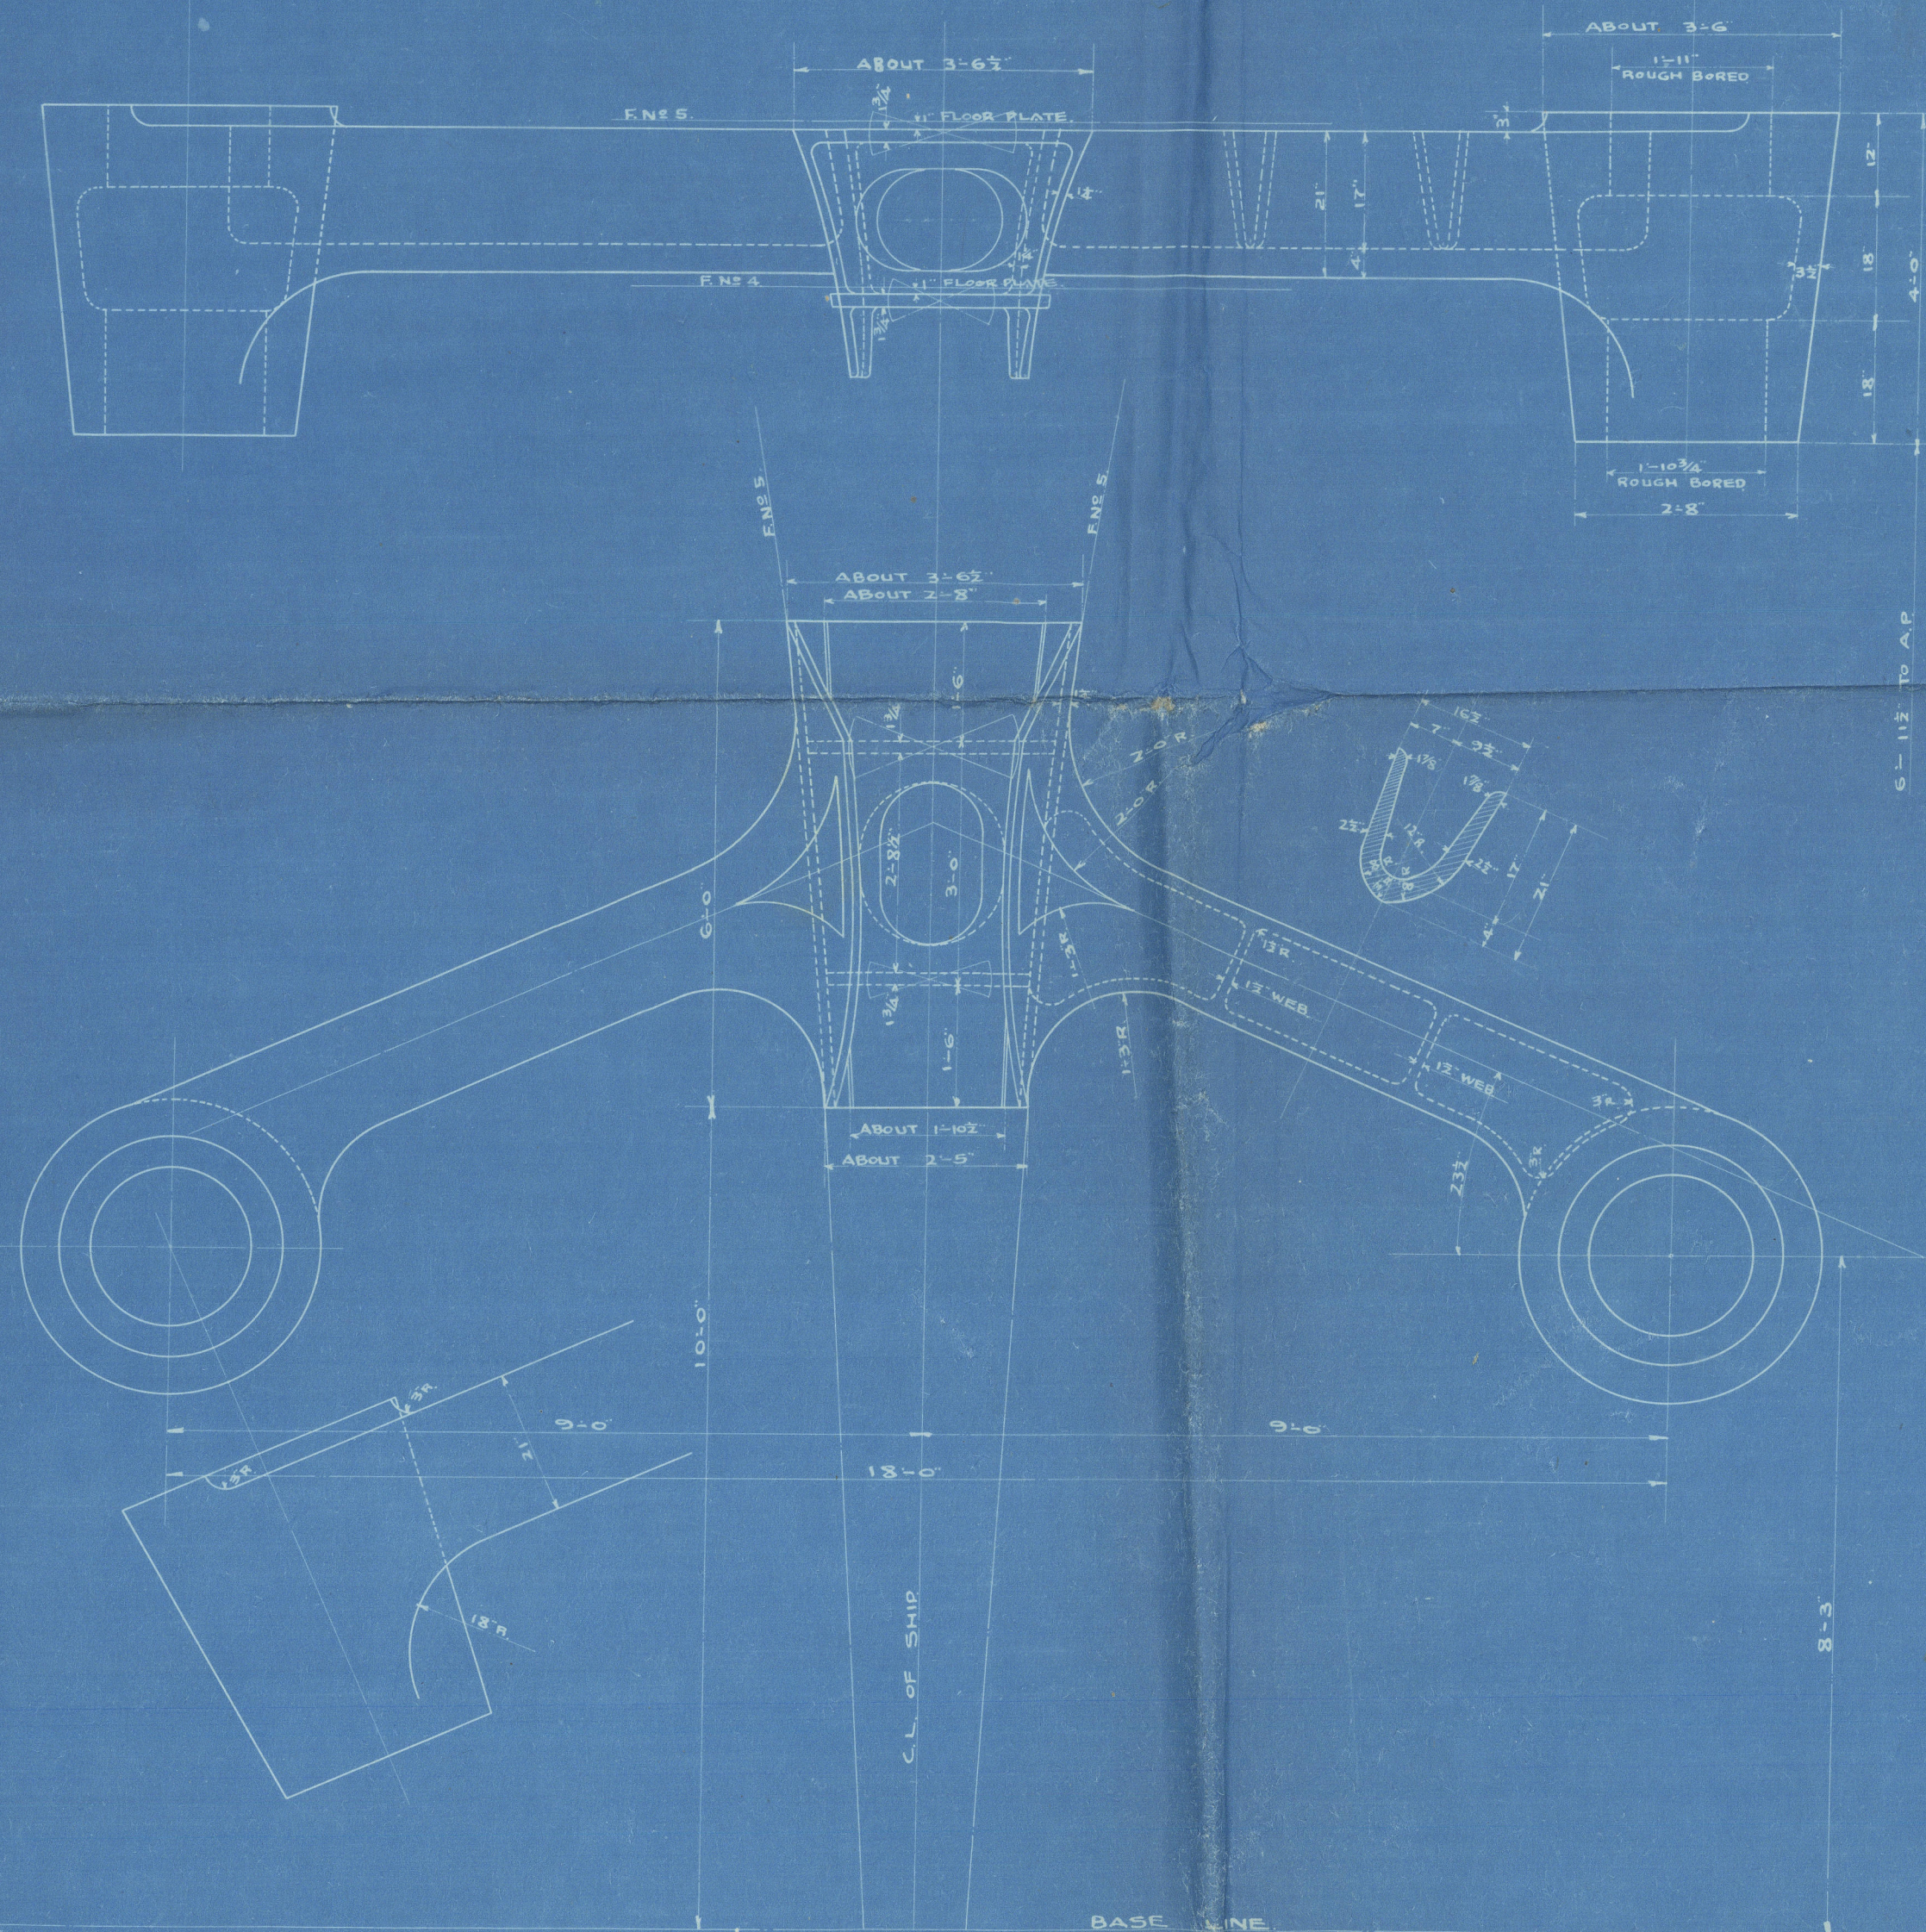


Landon
APPROVED
LLOYD'S REGISTER OF SHIPPING
NOV 10 1919
J. French

ESURUMI NEAR YOKOHAMA
SEP. 27 1919



Ship's Name or No.	NOS. 38 & 39.
Name of Drawing	RUDDER, STERN FRAME & SHAFT BRACKET.
P. No.	Sending No. 10907

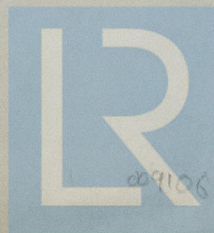

© 2021


Lloyd's Register
Foundation

009106-009115-0217

7120-511600-0217



089106-009115-0217

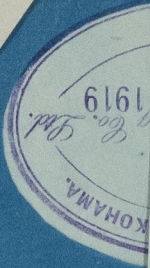

Wm



Wm



© 2021

Lloyd's Register
Foundation

5-4.



© 2021

Lloyd's Register
Foundation