


# T. S. S. HAKOZAKI MARU.

## STERN FRAME & SHAFT BRACKET.

SCALE  $\frac{1}{2}$  INCH TO ONE FOOT.

MATERIAL: DUCTILE CAST STEEL.

## DETAILS

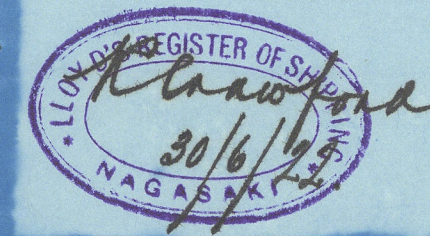

MITSUBISHI  
 ZOSEN KAISHA, LTD.  
 NAGASAKI WORKS.  
 SHIPDESIGNERS' OFFICE. A.

DRAWN BY  
TRACED BY  
CHECKED BY  
APPROVED BY  
DESIGNERS OFFICE NO.  
DATE JUN 9 1922



Sterngram - Shop bracket.

No. 348.

Mitsubishi Zosen Kaisha


"Hakozaki Maru"



© 2021

Lloyd's Register  
Foundation

009116 - 009121 - 0151