

BAAT N° 290, 293, 297, 298.

MIDTSKIBSSEKTION

KLASSE 1. A. 1. STAAL HVAL FANGER, NORSK VERITAS

SKALA: $1/2" = 1'-0"$

UTRUSTNING:

1 ANKER . 6 CWT. EXCL. STOKK

1 " 5 1/2 " " "


1 " 2 3/4 " " "

180 FAUNER 1 1/16" KJETTING KORTLENKET


60 " 6" HAMP PERTLINE

60 " $4\frac{1}{2}$ " " "

See endorsement.

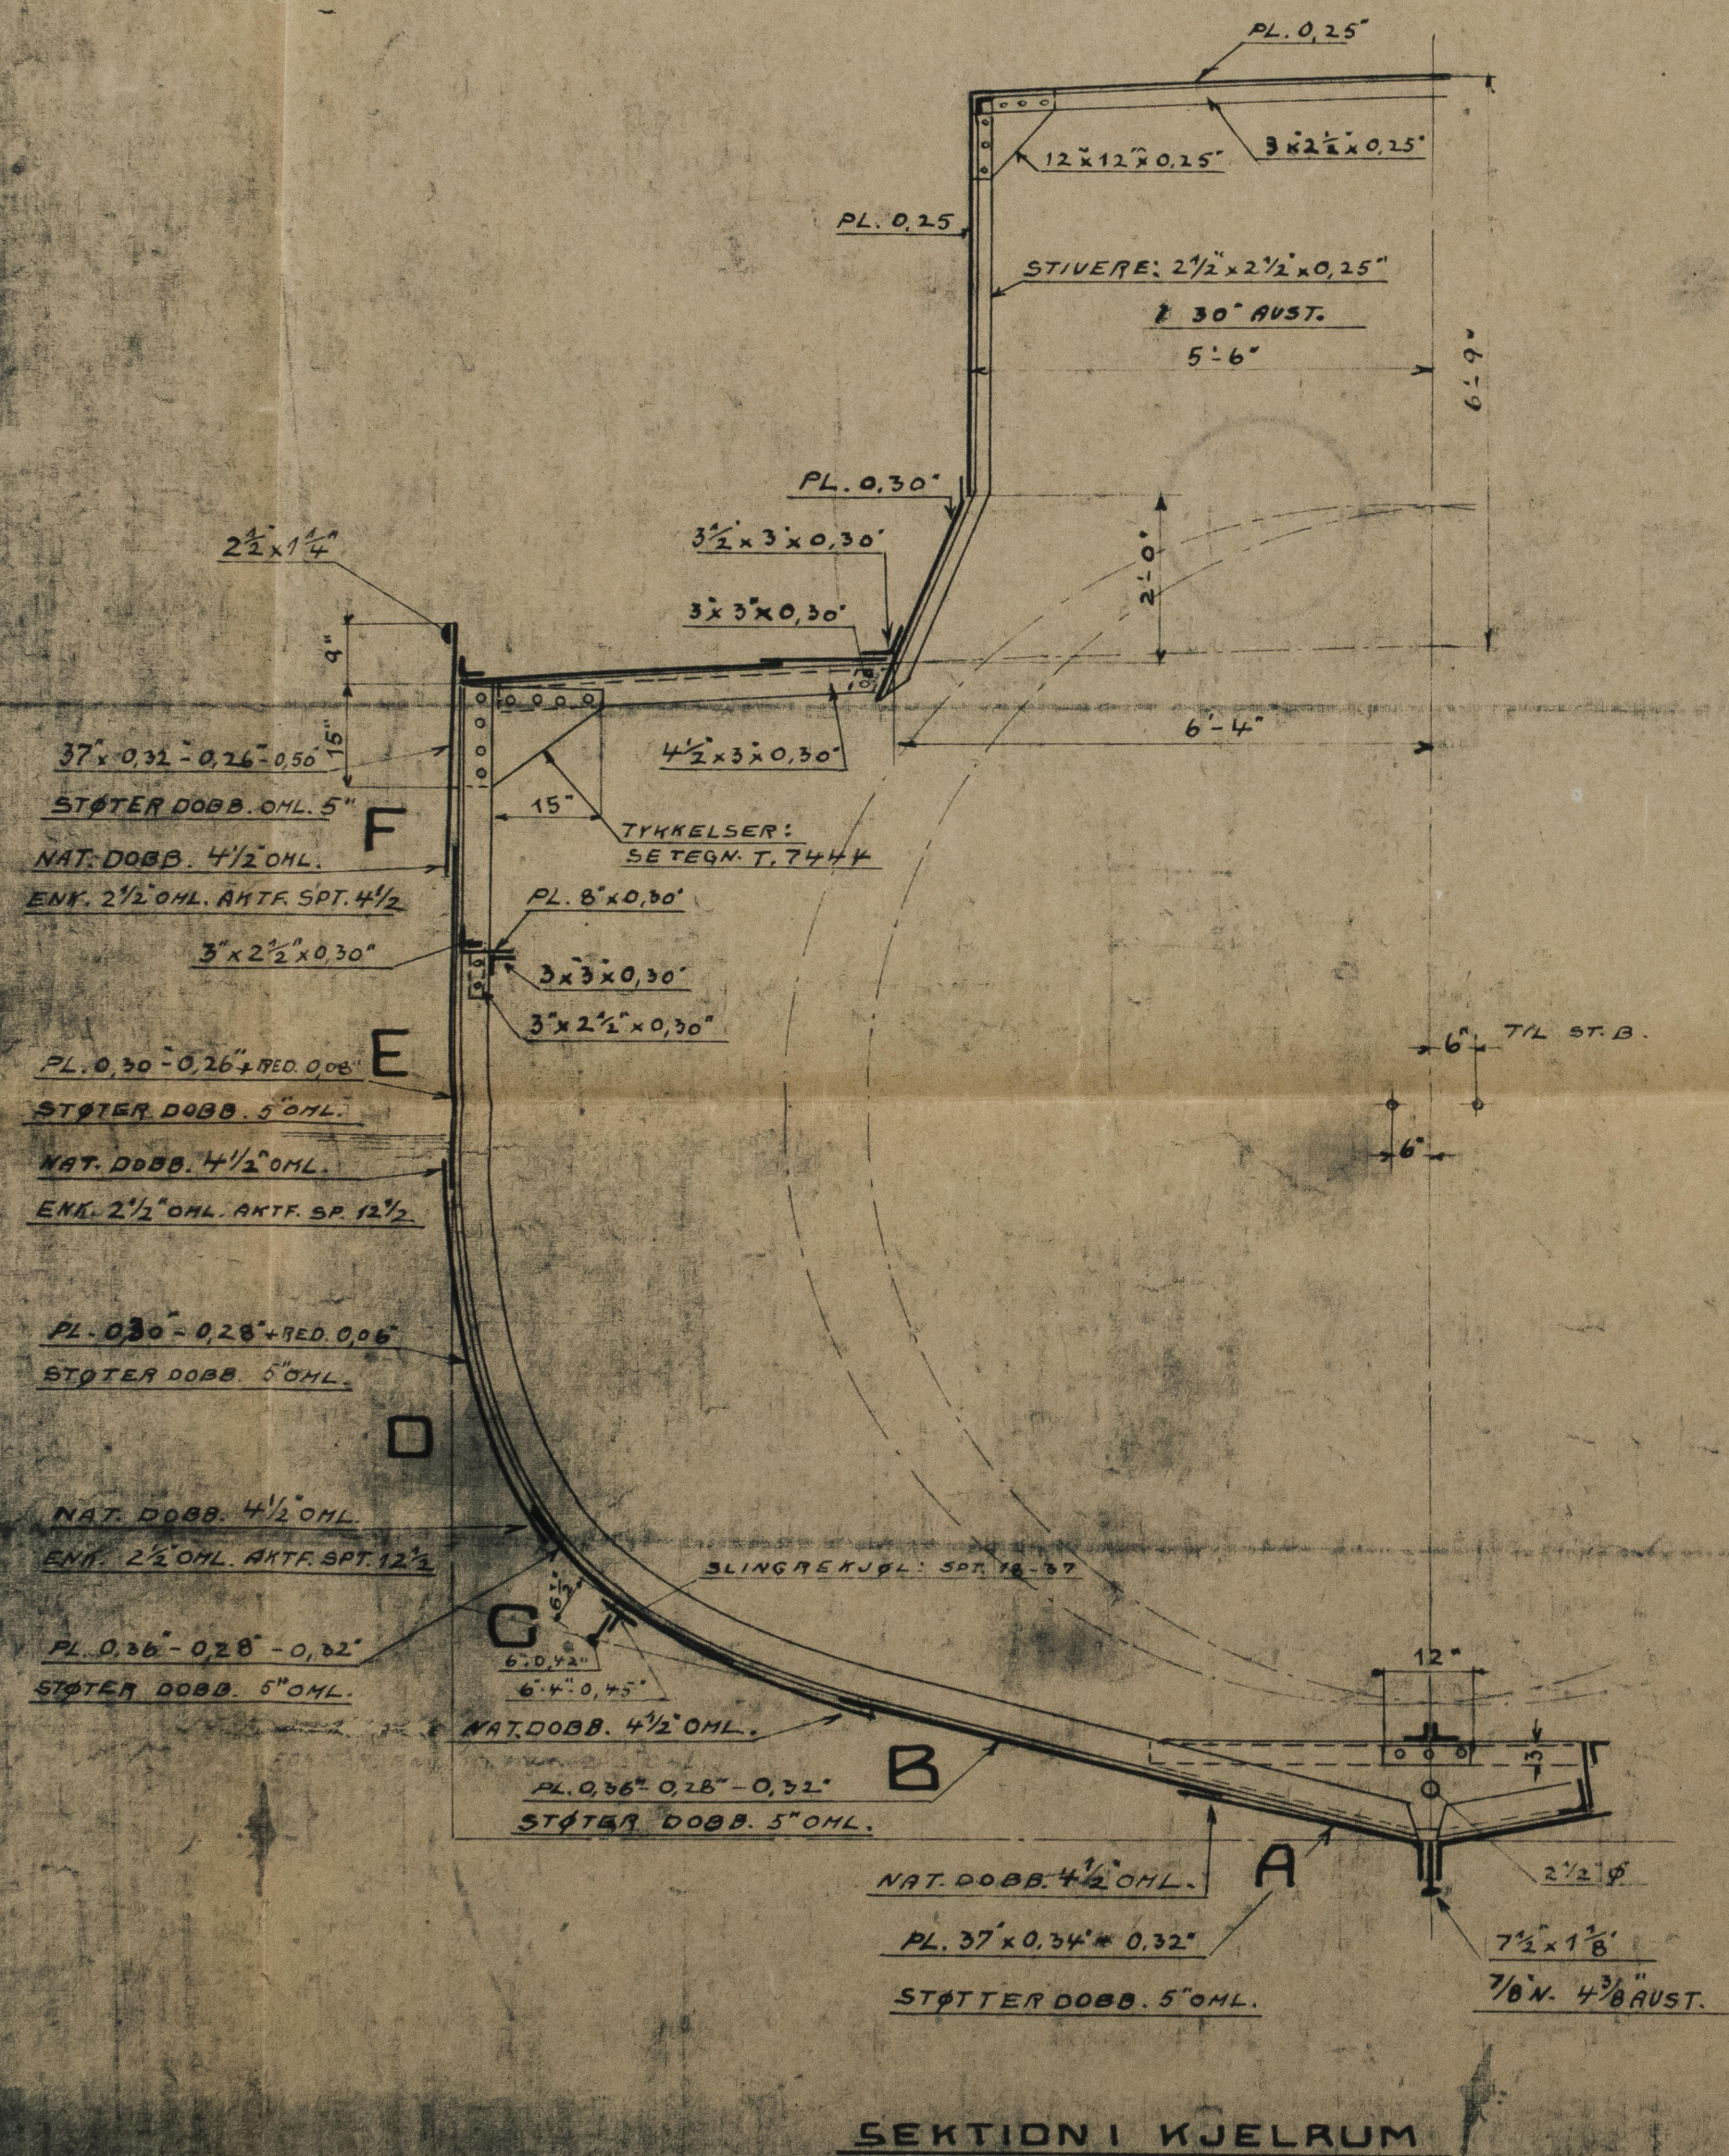

SEKTION I KJELRUM

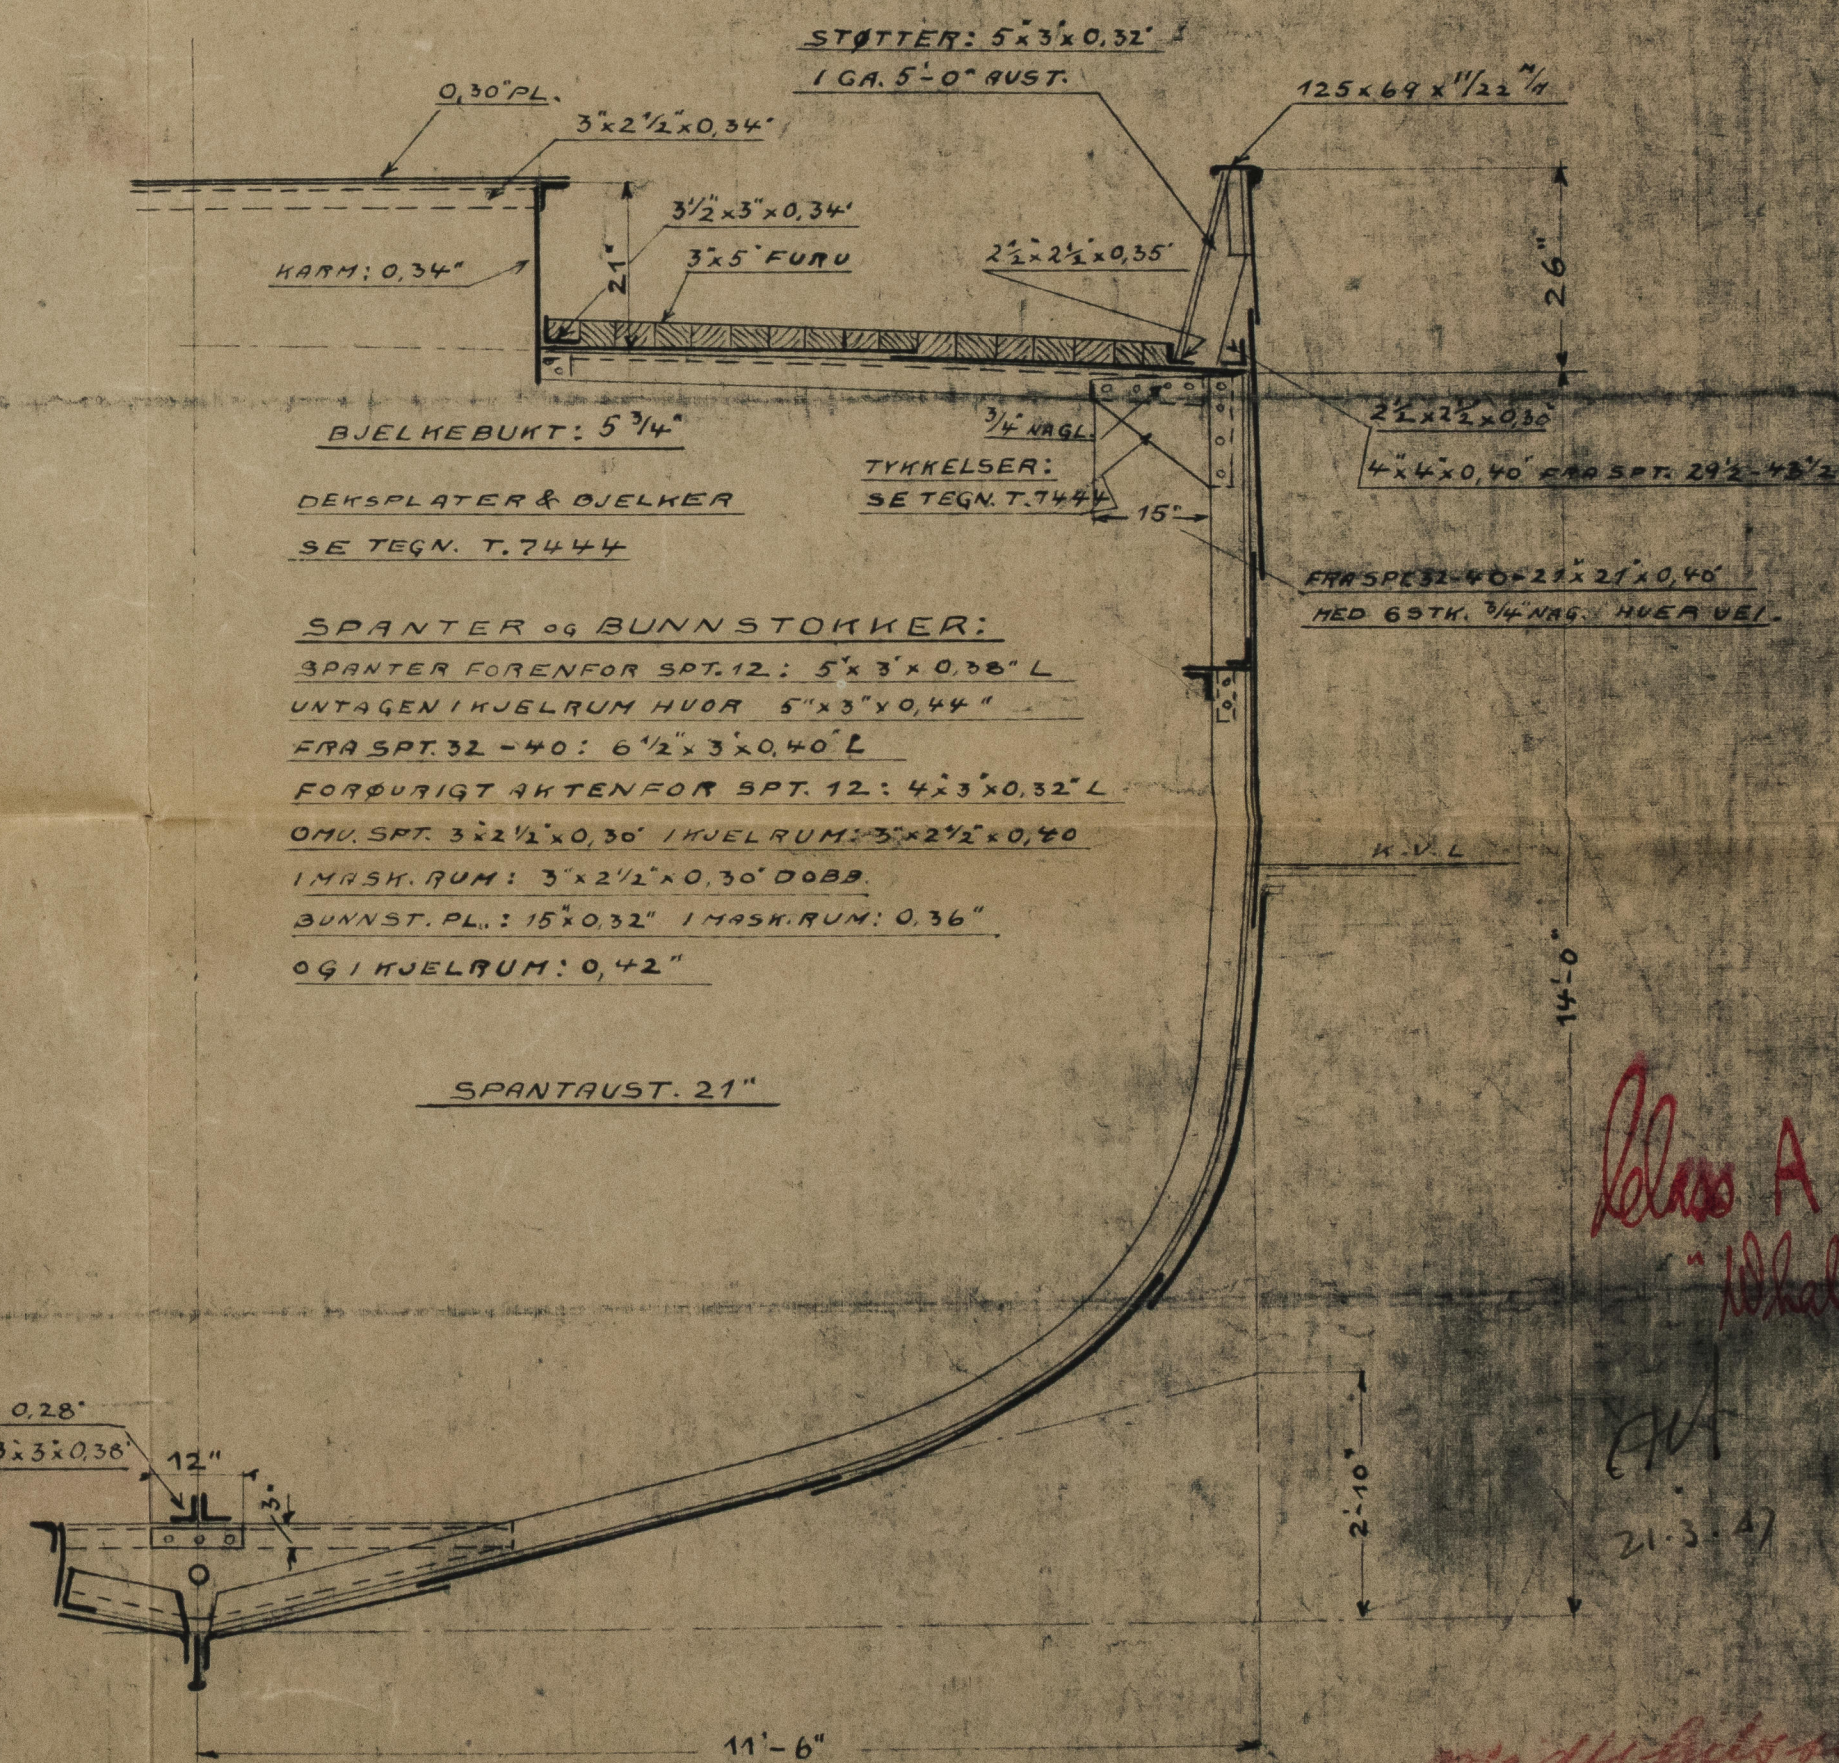

SEKTION I LASTERUM

Class A -
"Whaler"

21.3.47



Lloyd's Rec

Foundation

"INDUS 6" *

midship section

2

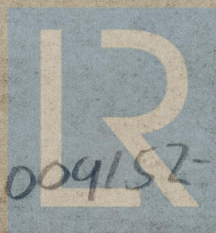

© 2021

Lloyd's Register
Foundation