

29.5.06

PROFILE

SCALE $\frac{1}{8}'' = 1 \text{ FOOT}$


Beams marked H. Buets $10 \times \frac{10}{20}$ Single Angle $6 \times 4 \times \frac{10}{20}$ ✓
 , , B. " $\frac{1}{2} \times \frac{1}{20}$ 2 Angs $3 \times 3 \times \frac{6}{20}$ or $8 \times 3 \times \frac{10}{20}$ Buets Angle

Bridge Deck & Beams. $6 \times 3 \times \frac{8}{10}$ Angles
" " $5 \frac{1}{2} \times 3 \times \frac{7}{10}$ "

Midship Beams	Butt Angles	$4 \times 3 \frac{1}{2}$	✓
Stair	"	$6 \times 3 \frac{1}{2}$	✓
End	$2 \frac{1}{3} L$	$6 \times 3 \frac{1}{2}$	✓
End Beams in Piers	"	$5 \frac{1}{2} \times 3 \frac{1}{2}$	✓
Bridge Space Beams	"	$4 \frac{1}{2} \times 3 \frac{1}{2}$	✓
"	$\frac{1}{2}$	$6 \times 3 \frac{1}{2}$	✓

9th Deck Beams $4\frac{1}{2} \times \frac{1}{2}$ Bulbs, 2 ang's $3 \times 3 \times \frac{6}{10}$
 End Beams $\frac{3}{3} L. 4 \times \frac{6}{10}$ " 2, $3 \times 3 \frac{1}{2} \times \frac{6}{10}$

Alternate Rev. Bros
to Forecastle Deck.

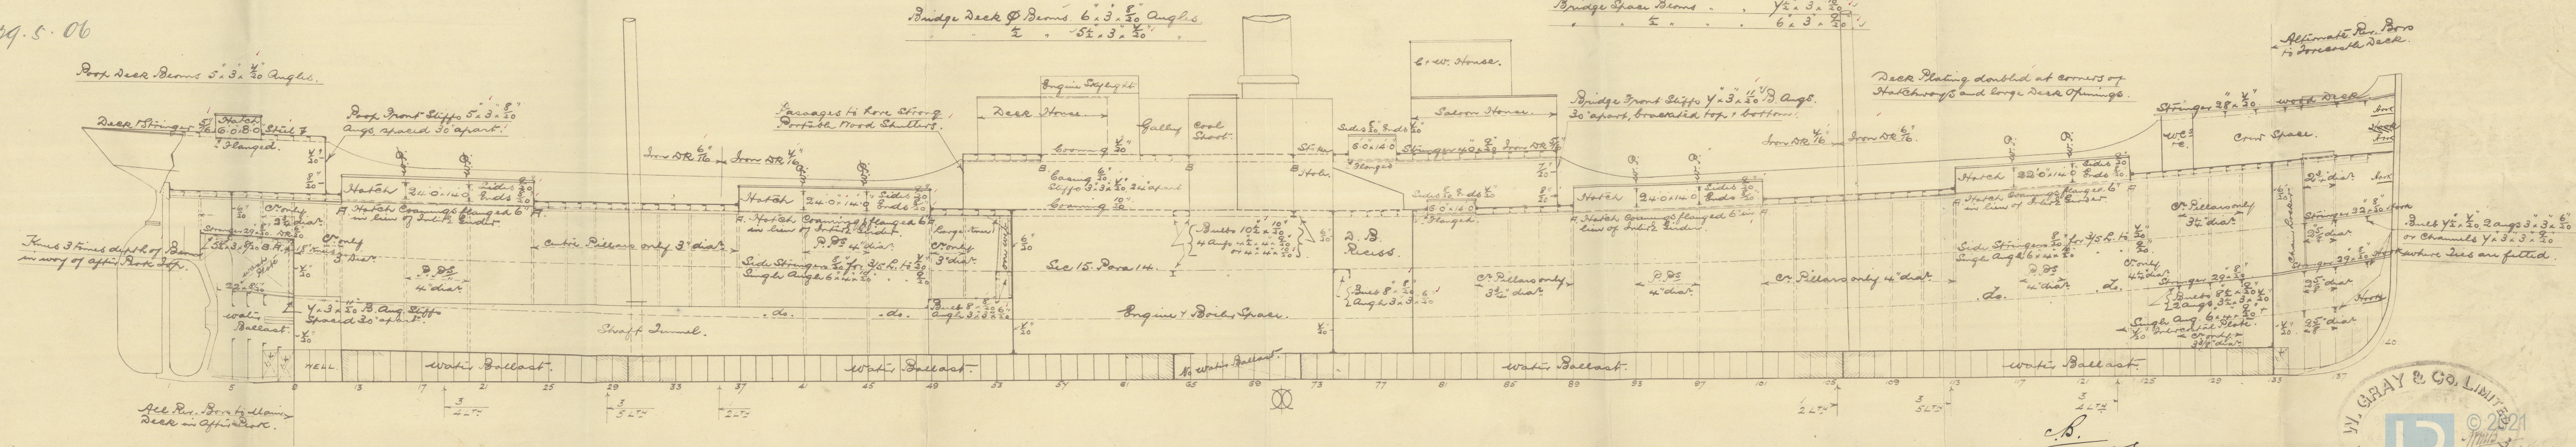


739.

739.

Profile

W. par 76°.

418. 739.

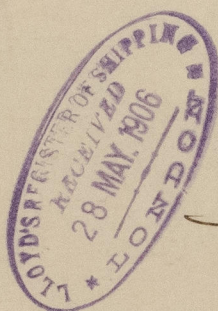

ss. Verastou.

Spec Report N° 13097

VOSELLA



© 2021

Lloyd's Register
Foundation

009152-009160-0084