


73.11.05

S.S. 214.

Profile.


Length between Pers. = 420.0"
 Breadth moulded = 55.0"
 Depth moulded to Spardeck = 31.2"
 Depth moulded to Maindeck = 23.0"
 Class: Lloyd's 100 A 1 Steel, Spardeck rule.
 $\frac{1}{2}$ Girth = 47.00
 $\frac{1}{2}$ Breadth = 27.50
 Depth = 24.16
 $98.66 =$ Number for frames.
 $98.66 \times 420 = 41437 =$ Number for plating.
 $L:B = 7.63$
 $L:D = 17.38$ to Main Deck.
 " 12.99 to Spar Deck.
 Scale $\frac{1}{8}" = 1$ Foot.

 

648

23/11/05

Profile

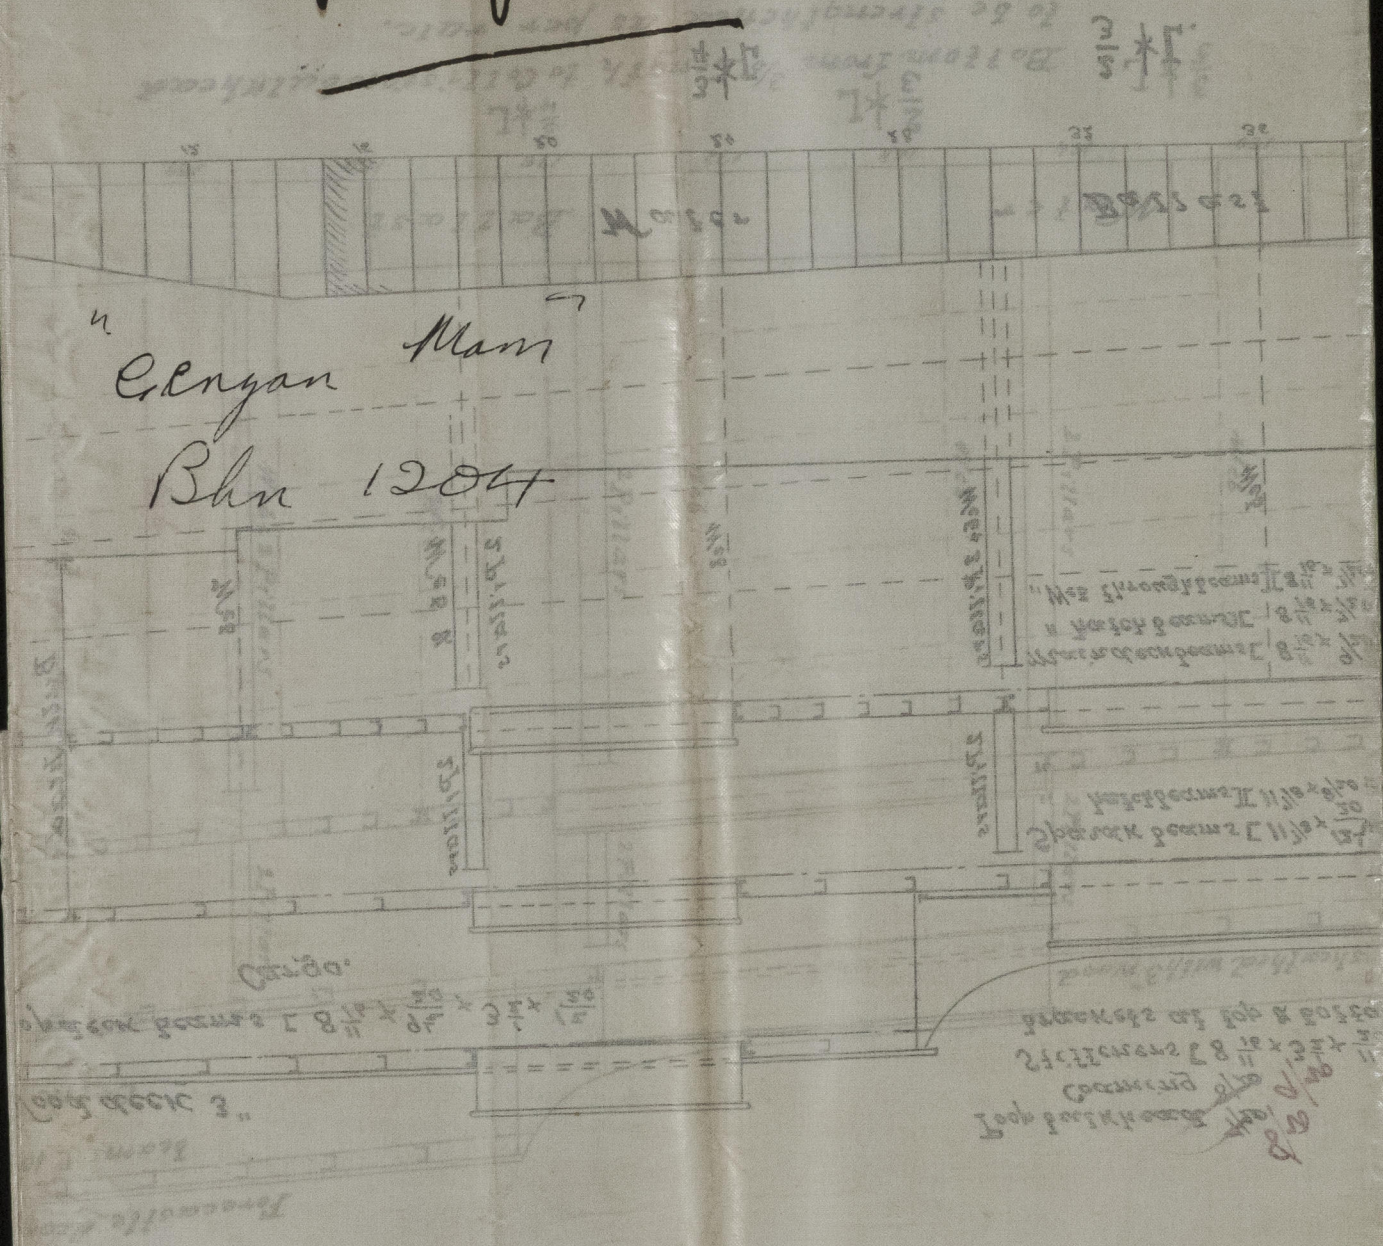

J. H. Tuller

Jan 2/4



© 2021

Lloyd's Register Foundation