



73.11.05


Side View of Coupling.

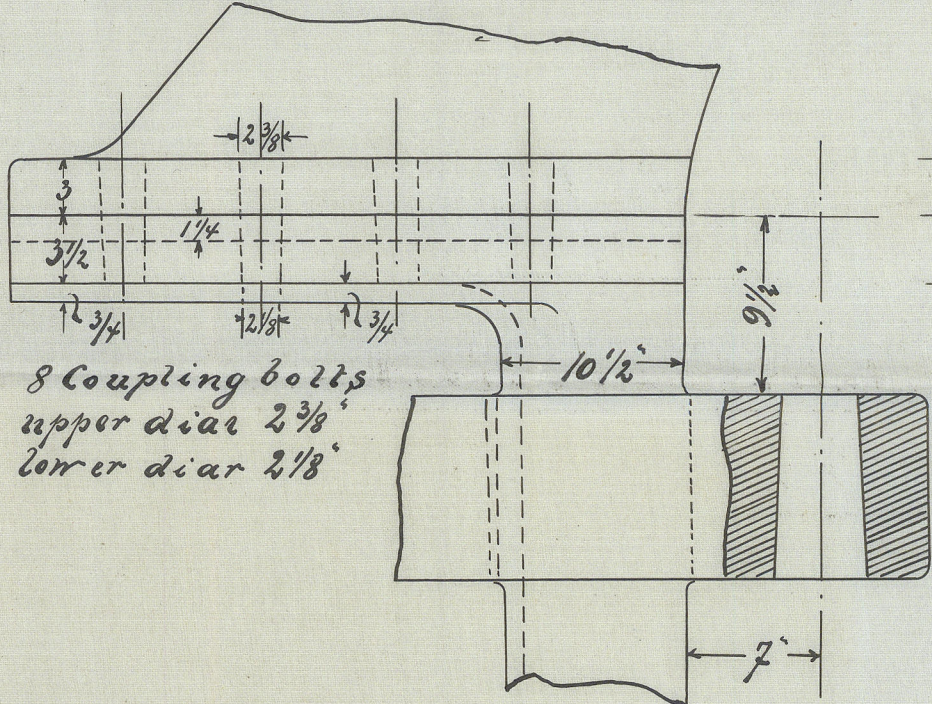

Back View of Coupling.

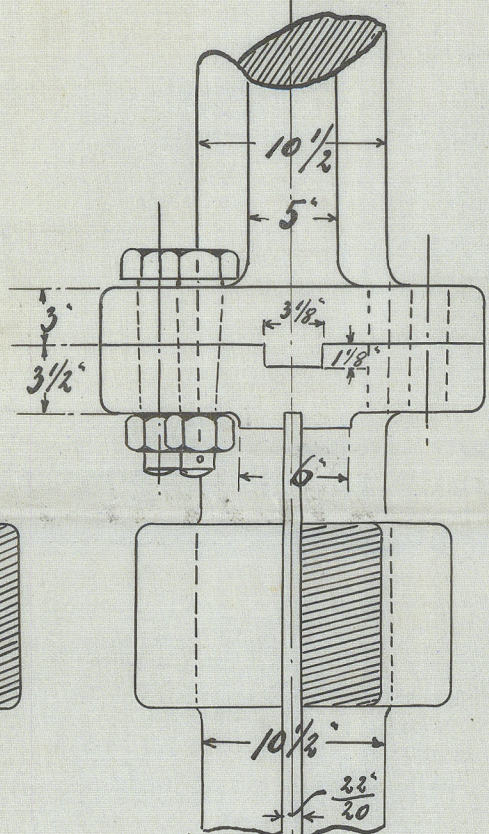


Top View of Coupling.

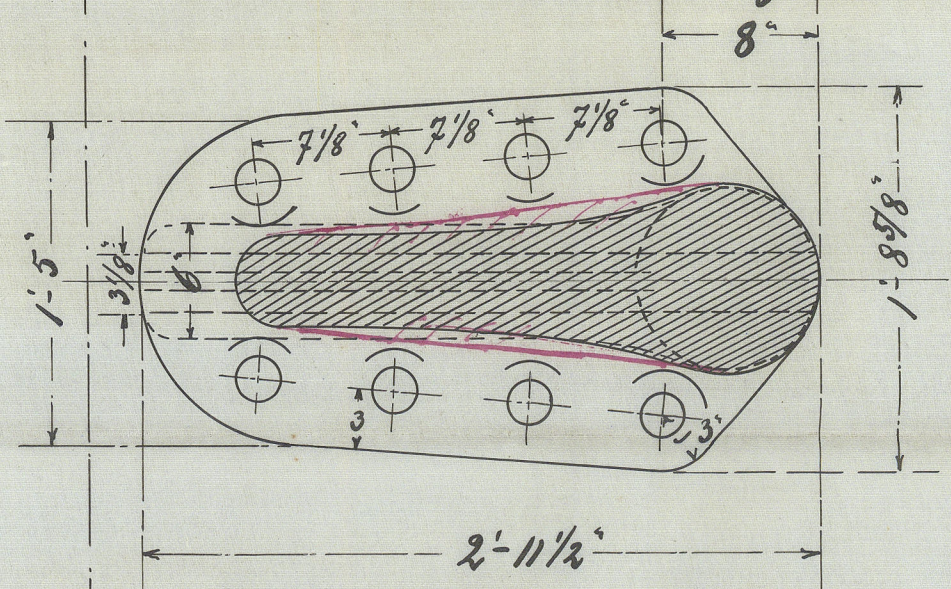

S. S. 214. Screw frame & Rudder. 1/25.

Screw frame to be made of Cast steel

Section thro' Pintles.

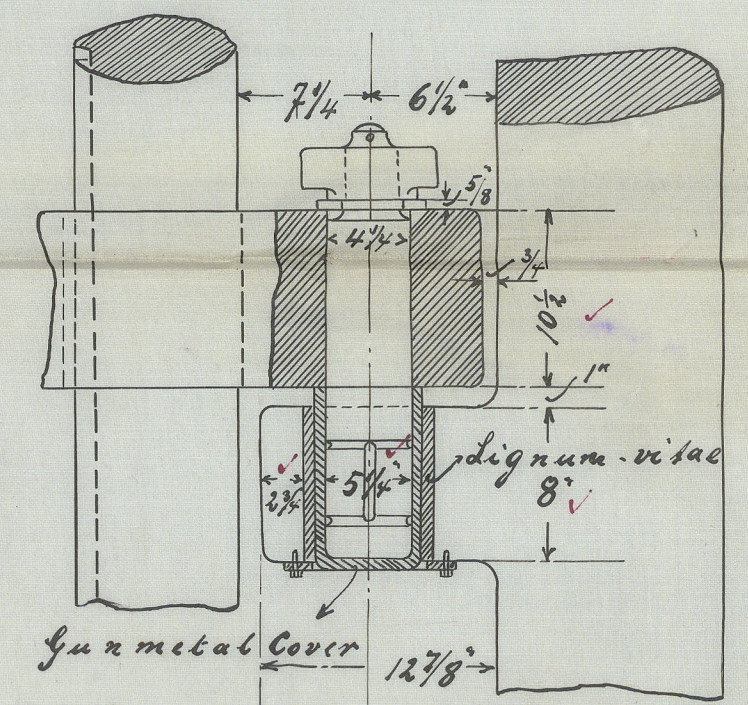

Rudder to be made of malleable steel.
The arms to each pintle, to be keyed to main-
piece. And pintles to be covered with
gun metal.

26.10.07
JOU. C. TECKLEBORG A.-G.
SCHIFFSWERFT und MASCHINENFABRIK
BREITENBURG-CESTOMUNDE
16.11.05

"Genzan Maru"

Bkn 1205



Reader.

