

23.10.14
2.11.14
17.11.14

MIDSHIP SECTION

STEEL SCREW TRAWLER

No 652


133' 4" B.P. x 23' 6" EX x 13' 6" MLD

TO CLASS 100.A.I. STEAM TRAWLER

DECK PLATED OVER IN WAY OF MACHINERY SPACE
ENGINE AND BOILER CASING AS PREVIOUSLY APPROVED

PLAN No. 4866
FOR ENCLOSURE TO
MESSRS LLOYD'S SURVEYOR
HULL FROM
C. & S. S. LTD.
SHIPBUILDERS, SELBY
DATE 29/10/14

SCALE 1/2 IN = 1 FOOT

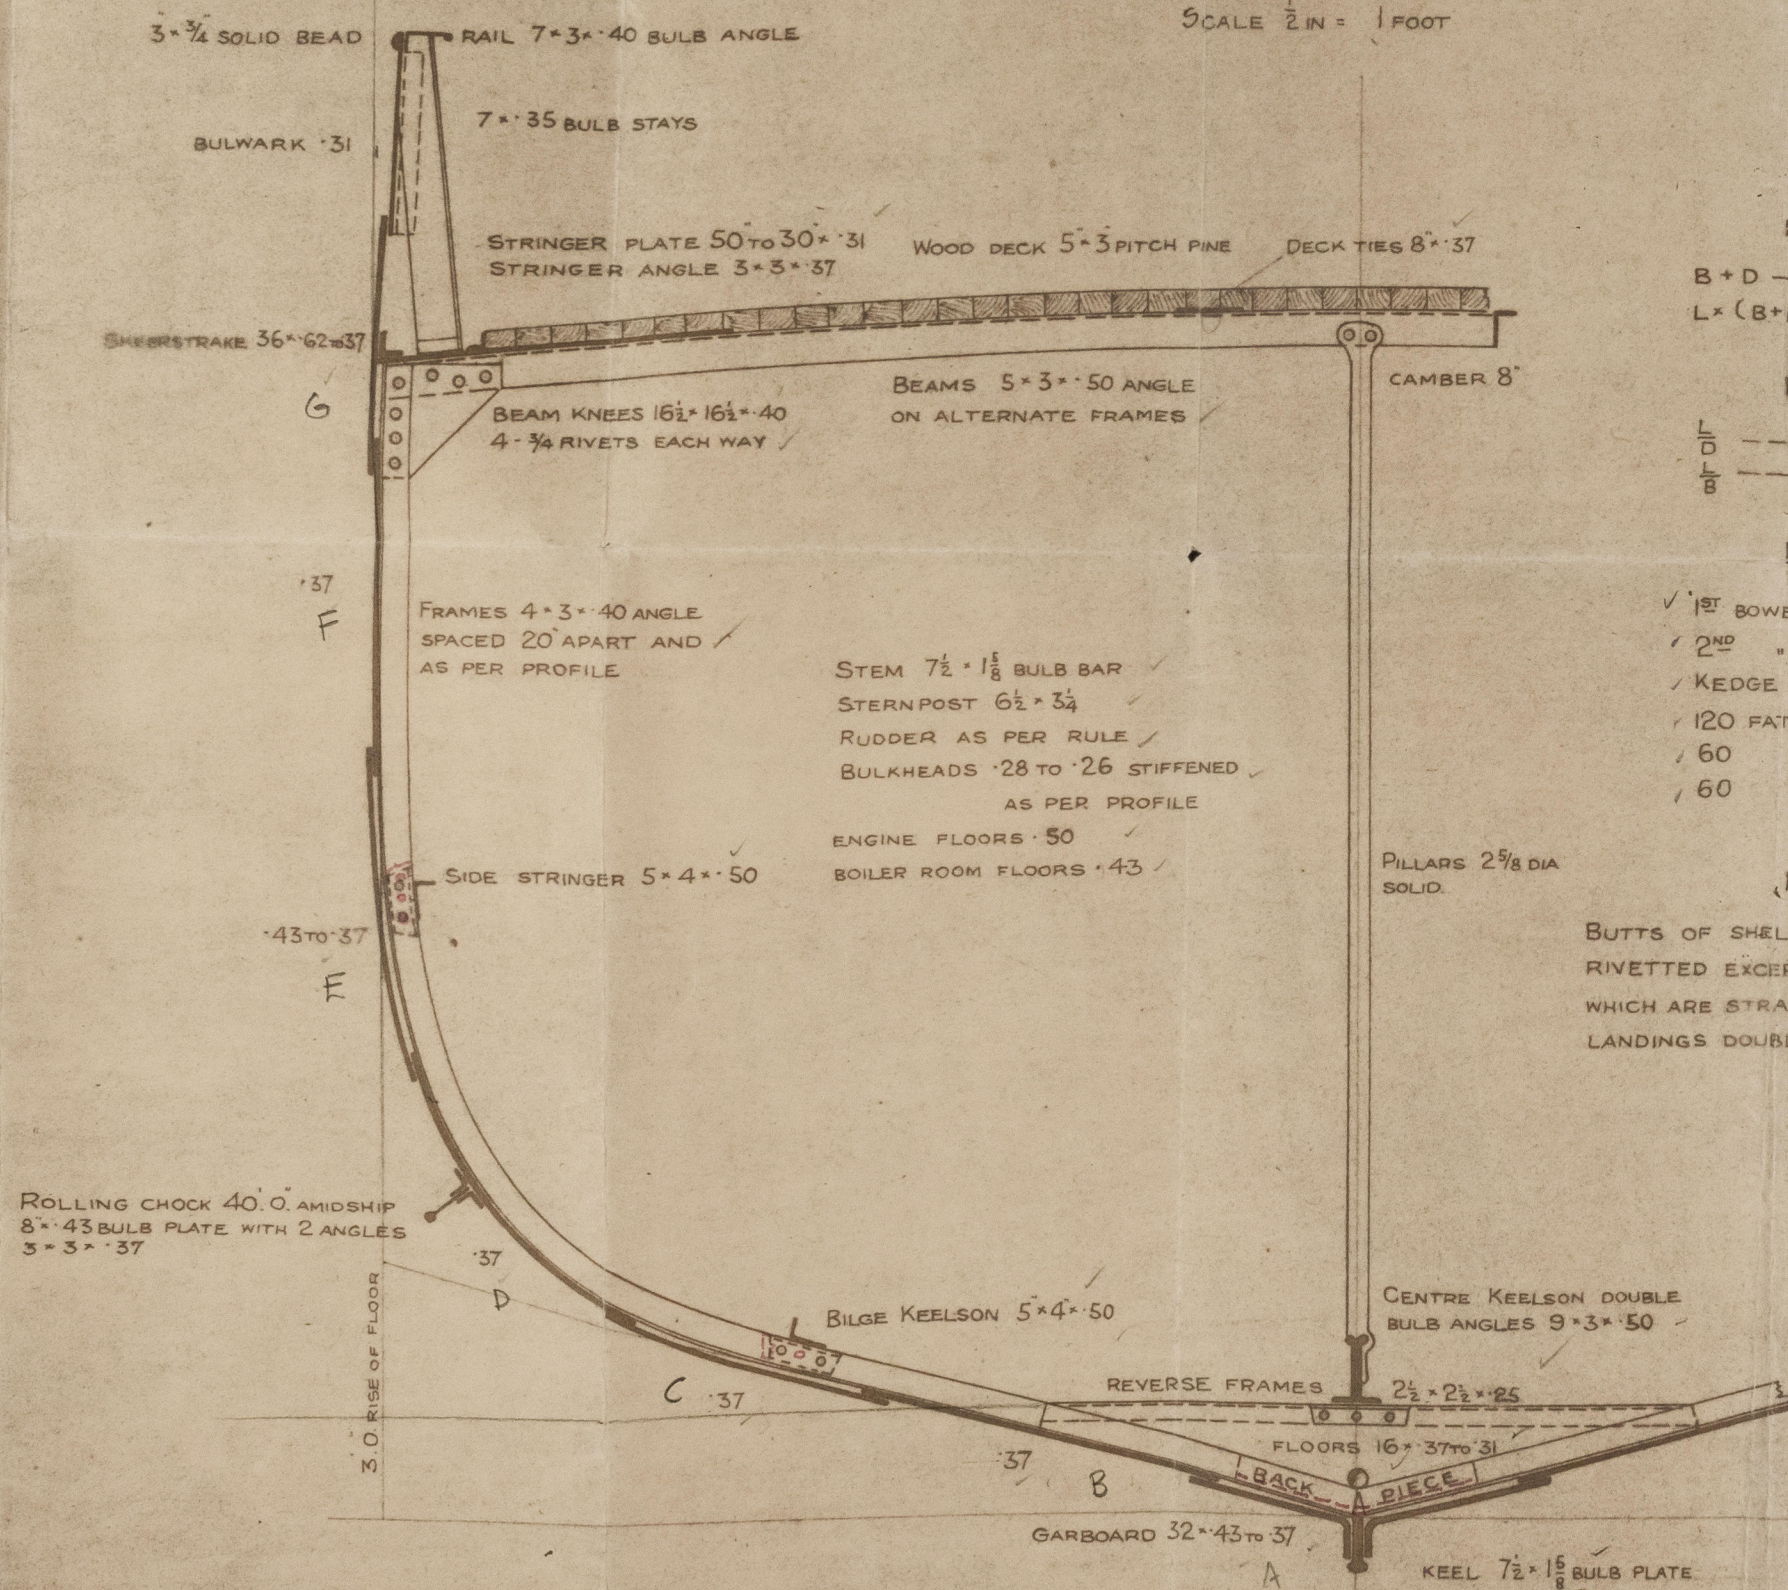

NUMERALS

B + D ----- 36.88
L x (B + D) ----- 4915.88

PROPORTIONS

L/D ----- 9.87
L/B ----- 5.70

EQUIPMENT

- ✓ 1st BOWER ANCHOR 7 1/2 CWTs STOCKLESS
- ✓ 2nd " 7 " "
- ✓ KEDGE " 3 CWTs EX STOCK
- ✓ 120 FATHOMS 1 1/8" STUD LINK CABLE
- ✓ 60 " 6 HAWSER
- ✓ 60 " 5 WARP


RIVETTING

BUTTS OF SHELL PLATING LAPPED AND DOUBLE RIVETTED EXCEPT GARBOARD AND SHEERSTRAKE WHICH ARE STRAPPED AND DOUBLE RIVETTED LANDINGS DOUBLE RIVETTED - BULWARKS SINGLE RIVETTED


C2.
23.10.14

Cochrane 652

Midship Section

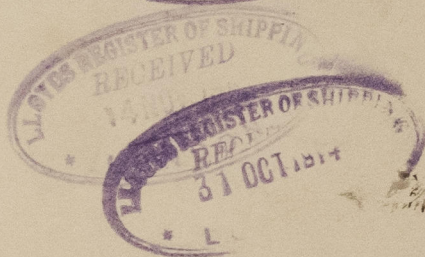

S/S. "Collera" Hull Rept No. 28528

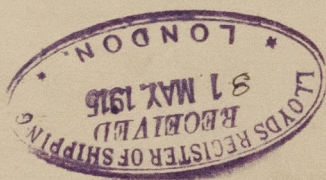

© 2021

Lloyd's Register
Foundation

009170-009181-0079