


FLOORS, ANGLES KEELSONS ETC. UNDER BOILERS 1/2"
GARBOARD, SHEER & STRAKE BELOW SHEER 1/20"
MAIN DECK PLATING 25% THROUGHOUT
BRIDGE DECK PLATING OVER BUNKER & BOILER 25%
STERNPOST 10% SAY 6"x3"

FRAMES TO SHELL IN FORE & AFT PEAKS	5/8" DIA. 2 3/4" PITCH
" " " ELSEWHERE	5/8" " 4 1/2" "
BEAMS TO DECK PLATING	5/8" " 4 1/2" "
SHELL PLATING BUTTS 2R-1R.	5/8" " 2 1/4" "
" " LANDINGS 1R.	5/8" " 2 3/4" "
REVERSE FRAMES TO FLOORS ^{Section in ES}	5/8" " 4 1/2" "
BULKHEAD FRAMES TO BULKHEAD	5/8" " 2 3/4" "
" " " SHELL	5/8" " 3/8" "
" SEAMS & BUTTS	5/8" " 2 3/4" "
STRINGER PLATE BUTTS 2R-1R	5/8" " 2 1/4" "
FRAMES TO FLOORS	5/8" " 4 1/2" "

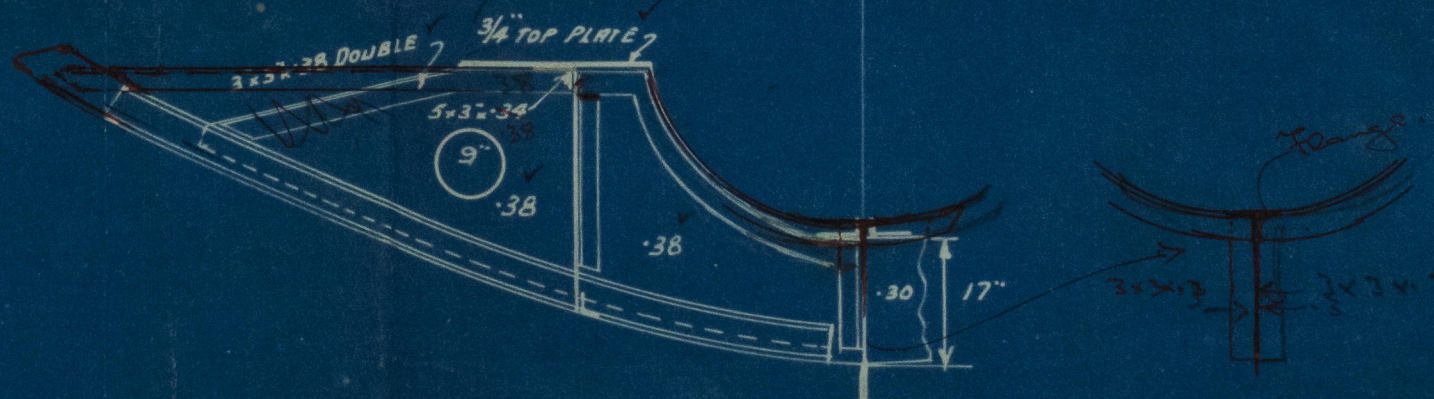

1
Midship Section.


Mr J. Inglis. Ltd.

No 919.

T. C. 6. 6. 34.

15. 2. 24.

"FLYING FALCON"

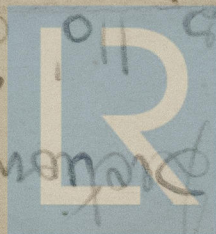

Lloyd's Register
Foundation