




DETAIL OF QUADRANT

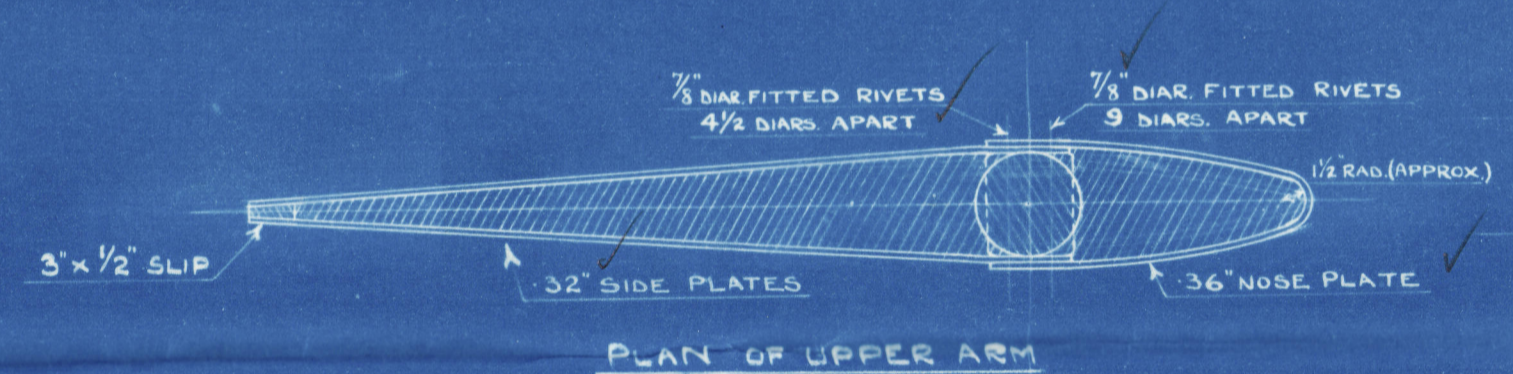



PLAN OF UPPER ARM

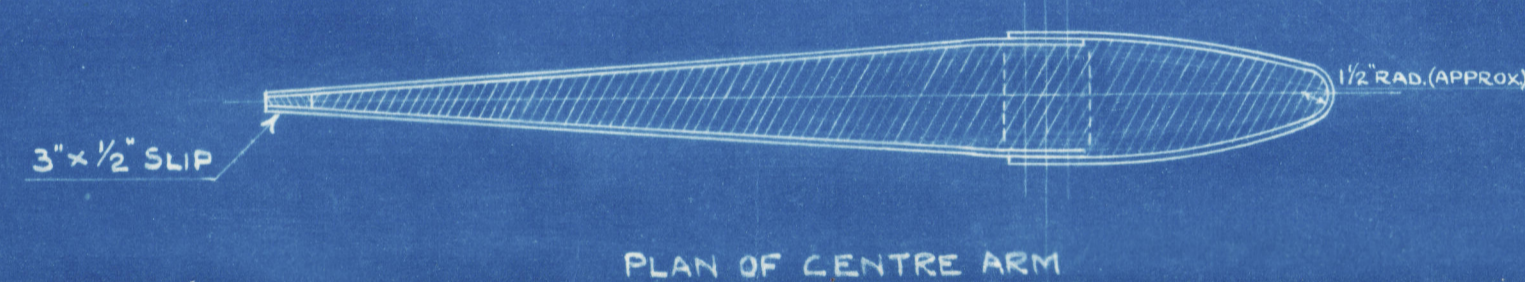


PLAN OF CENTRE ARM

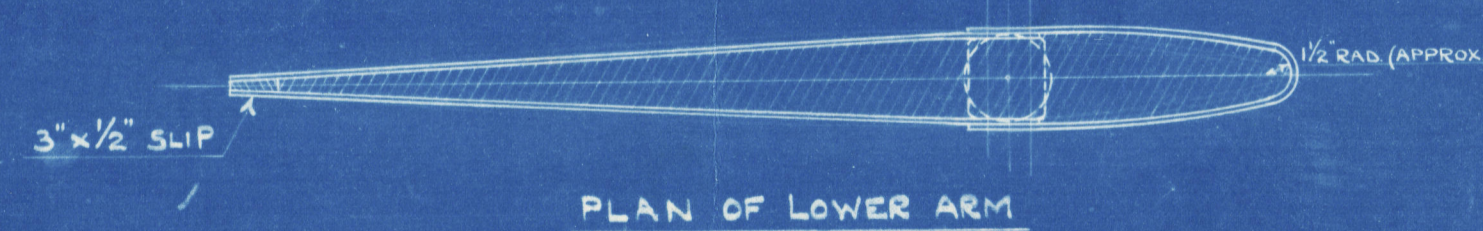


PLAN OF LOWER ARM

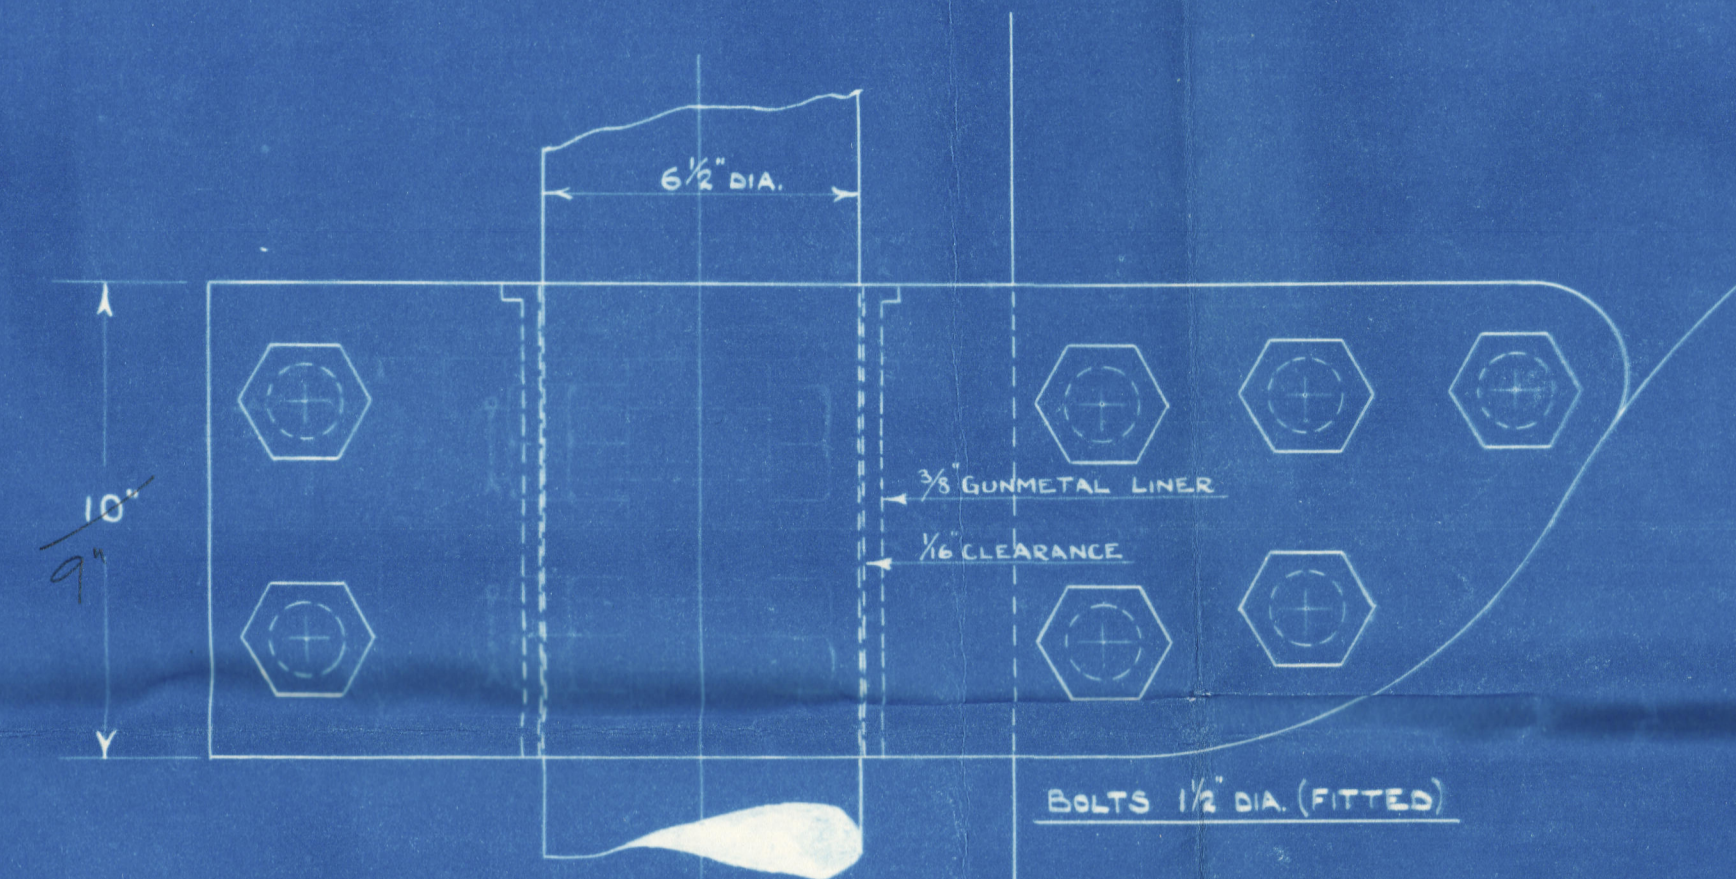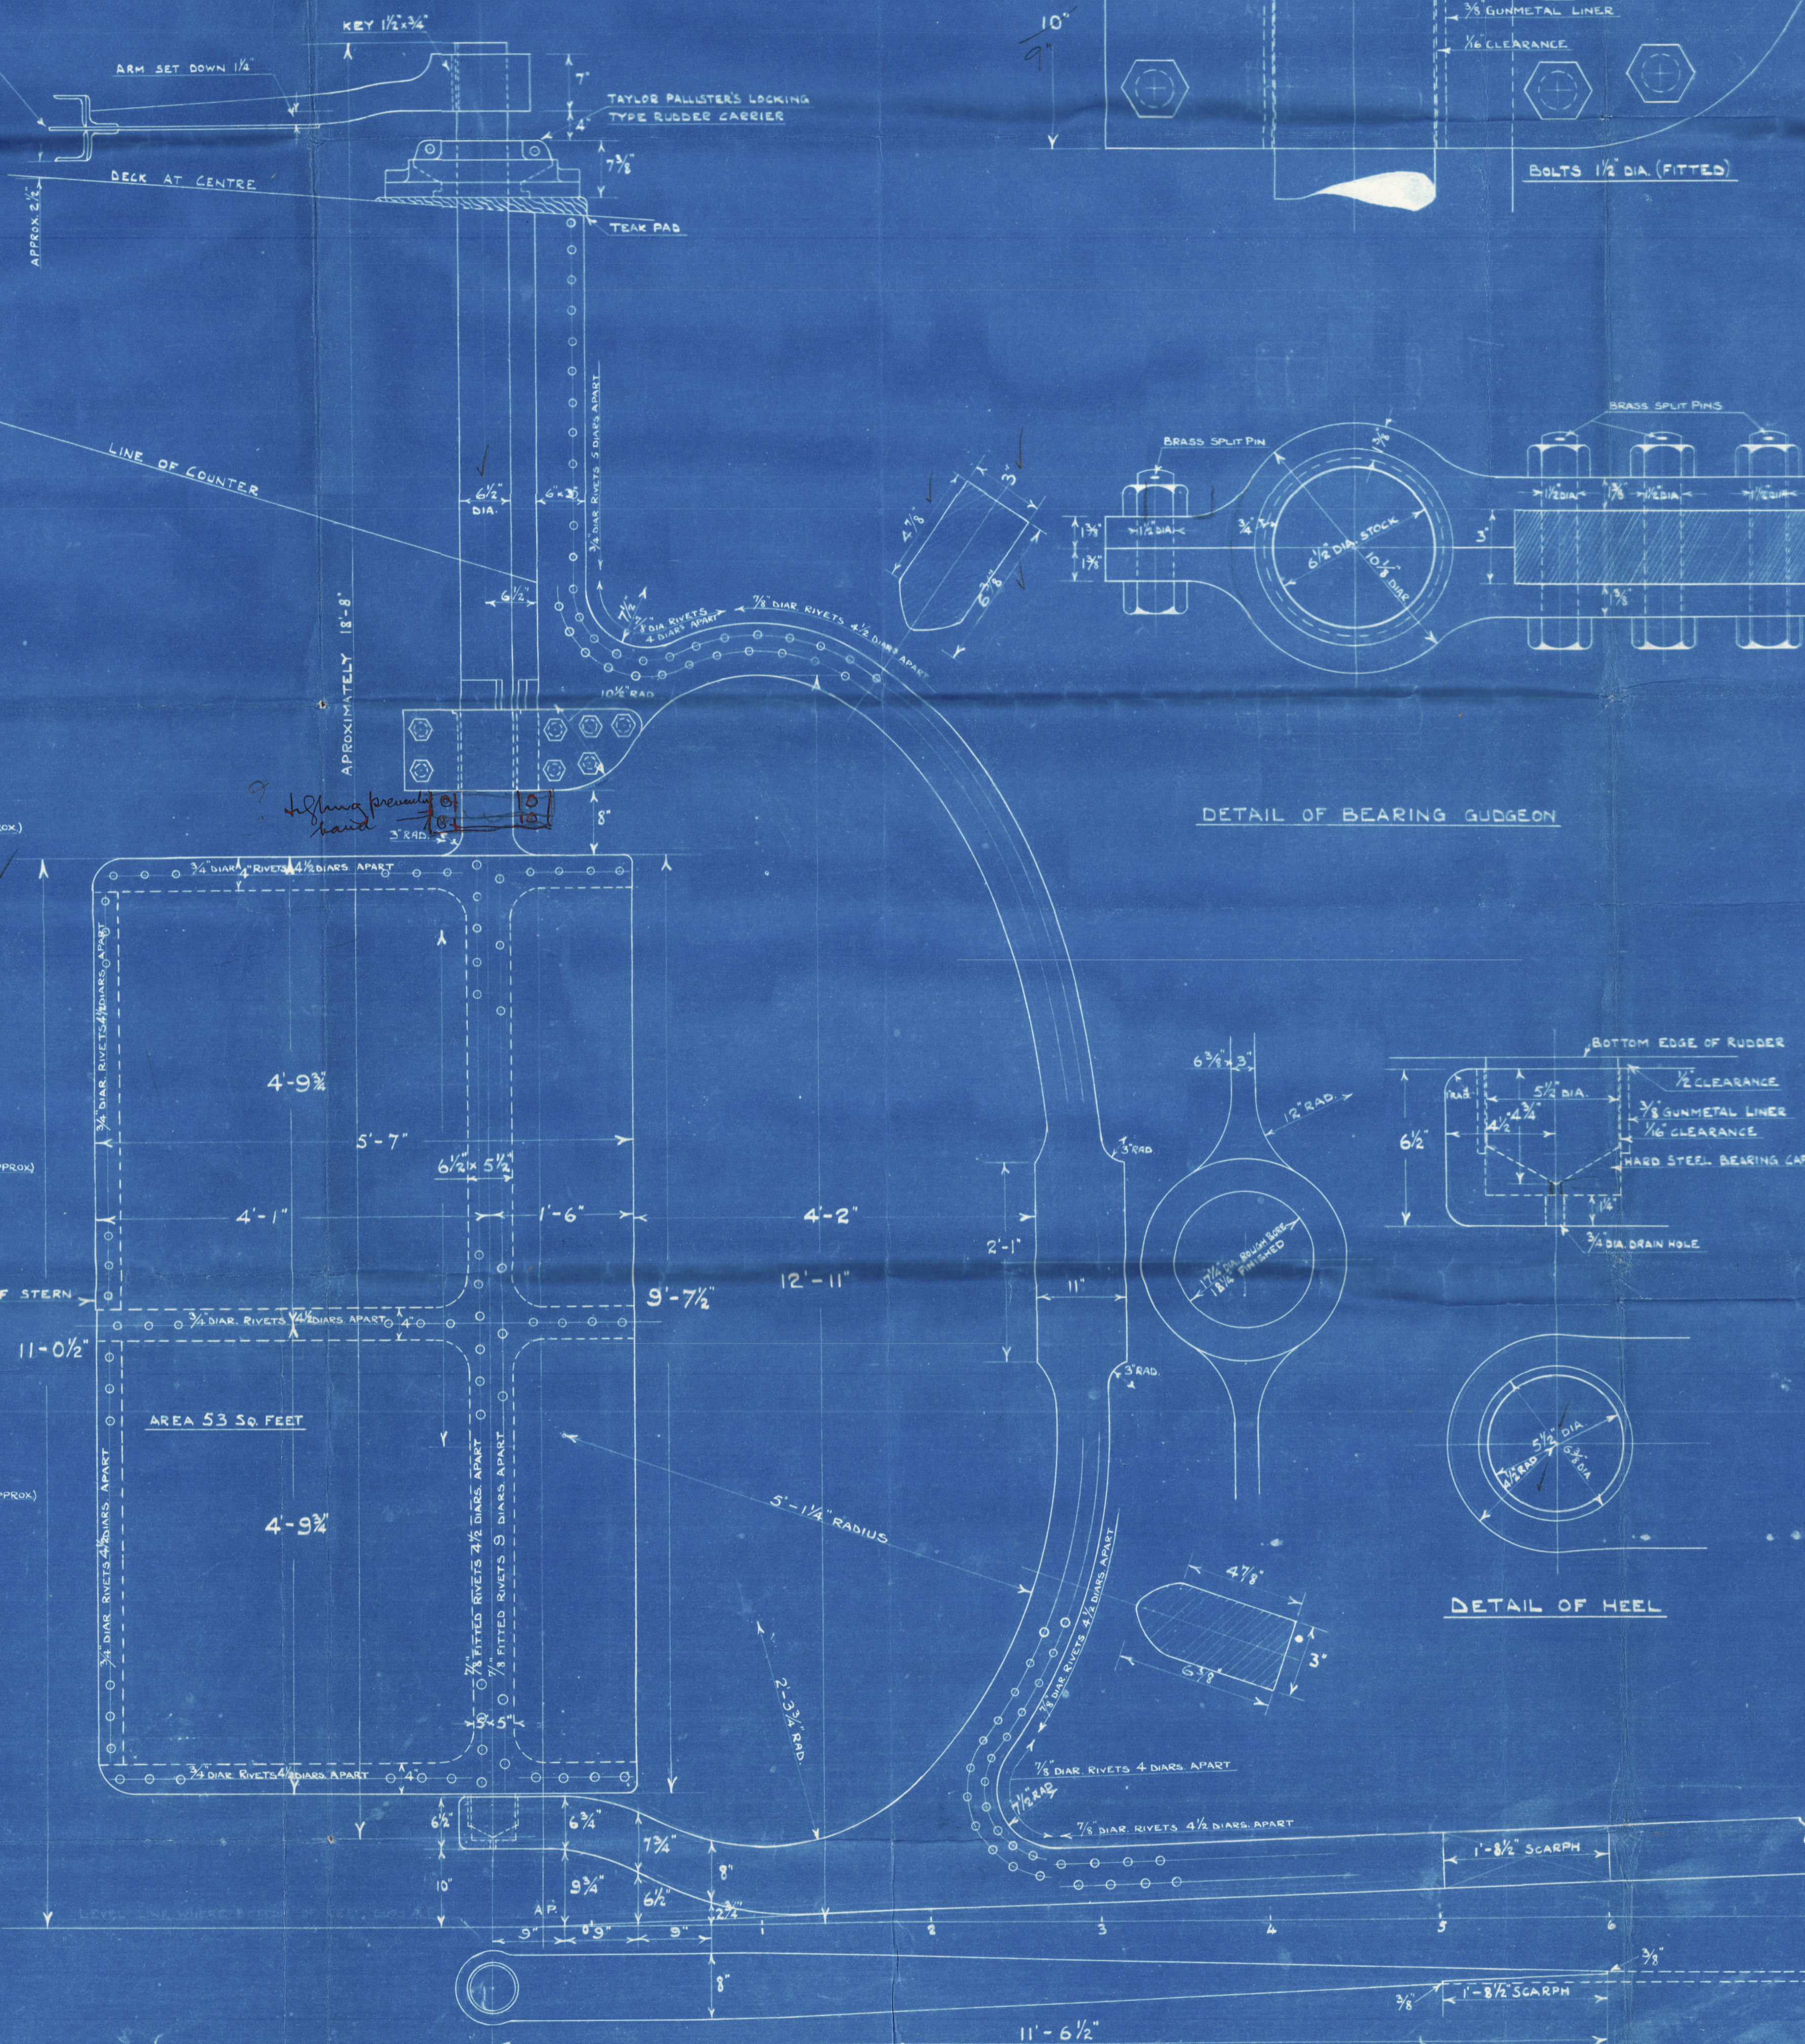

DETAIL OF BEARING GUDEON

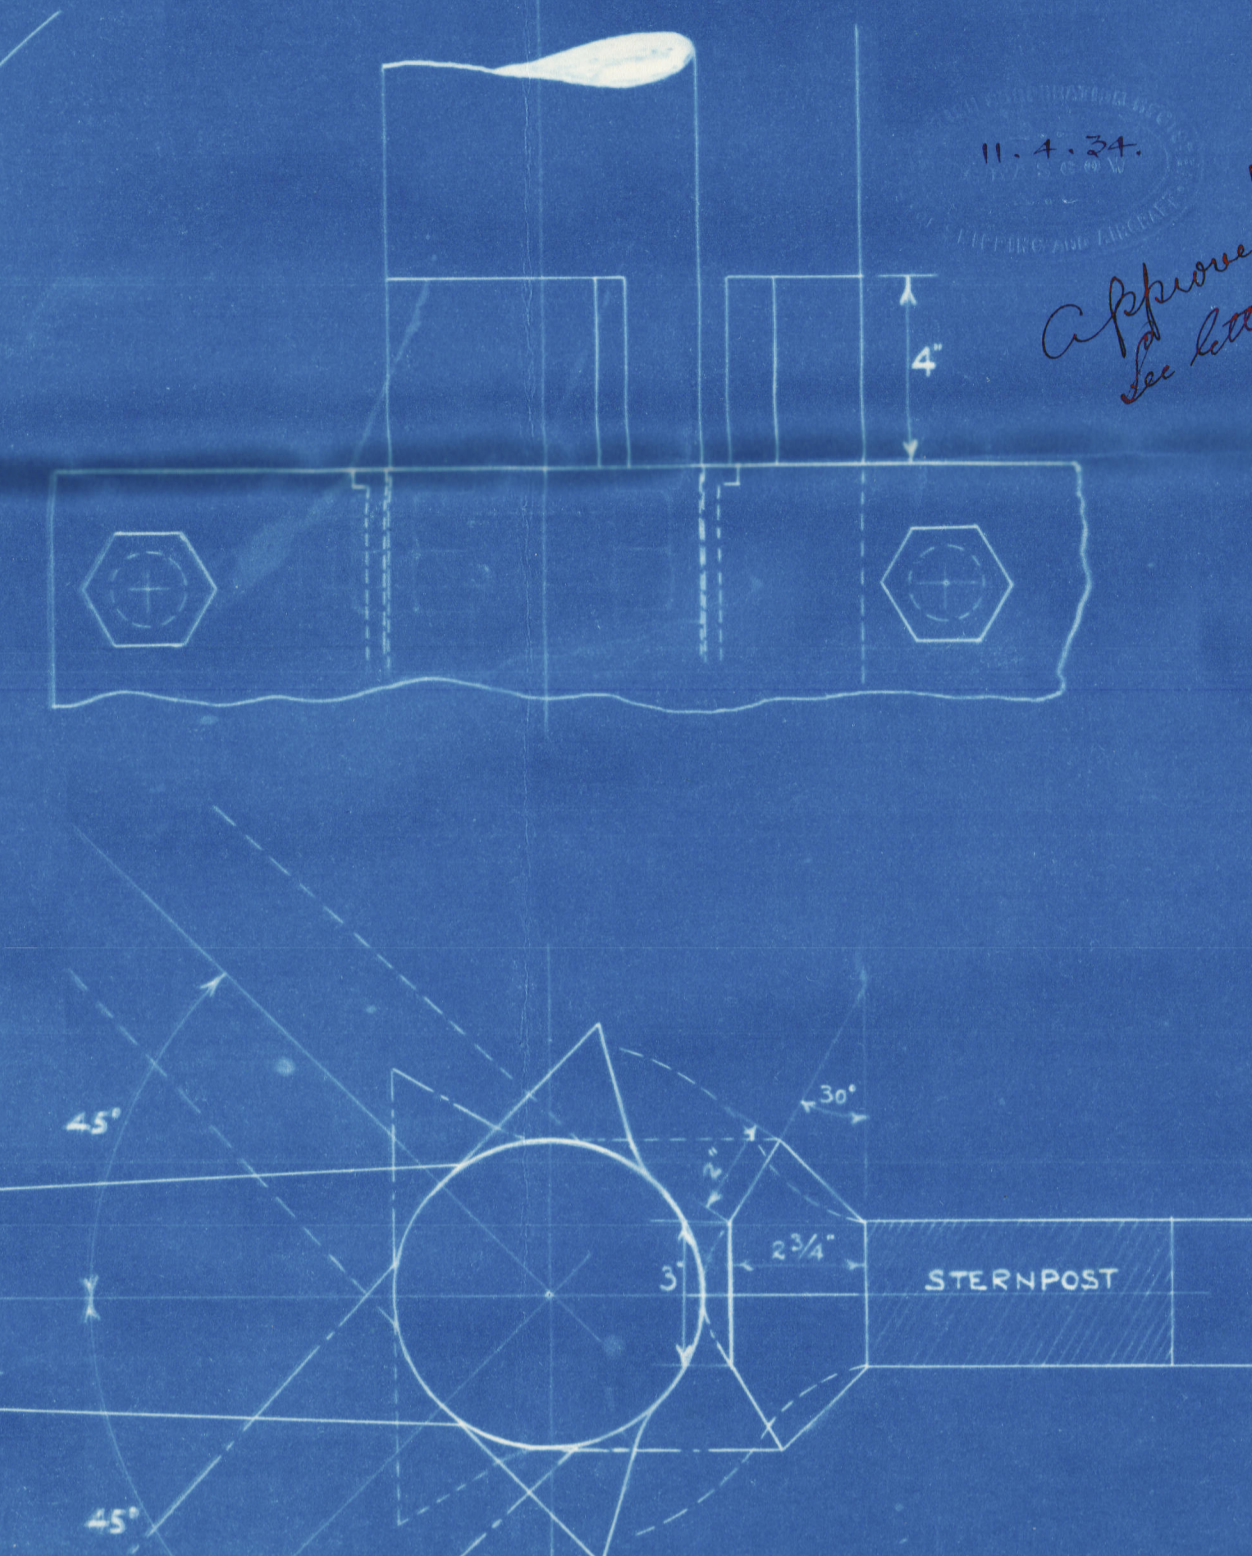

DETAIL OF STOPPER

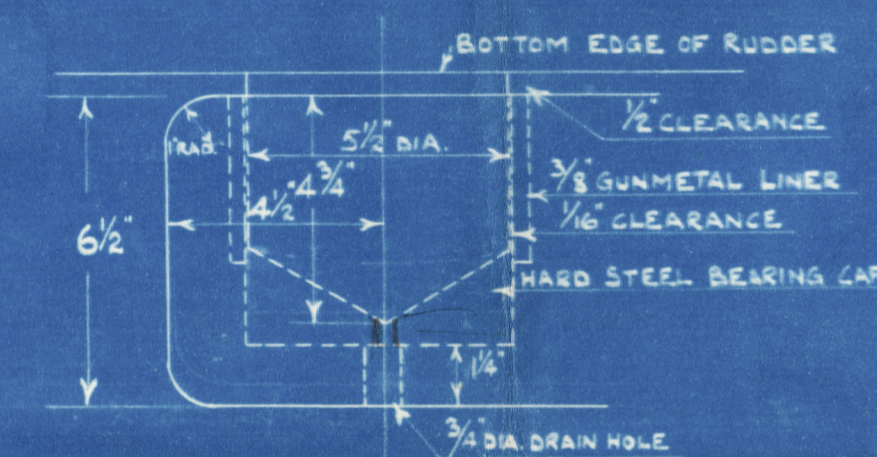


DETAIL OF HEEL

S.S. TUG

STERNFRAME & RUDDER

SCALE: 1\"/>

SPEED 12 KNOTS

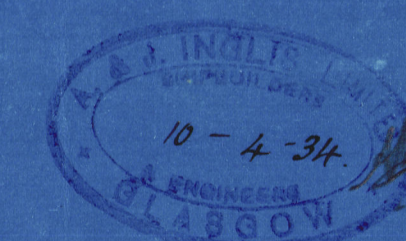

*Approved by Adam  
see letter 12.11.34*

5

And. Rudder & Sternpost.


No 949.

12. 11. 31.

"FLYING FALCON"

boy

- 646 -





© 2020

Lloyd's Register  
Foundation

009192 - 009199 - 0129