



16 DEC 1926

Approved *[Signature]*
14.12.26


BUILDING N^o 185-86.

STERNFRAME AND RUDDER.

SCALE $\frac{1}{2}$ " = 1 FOOT.

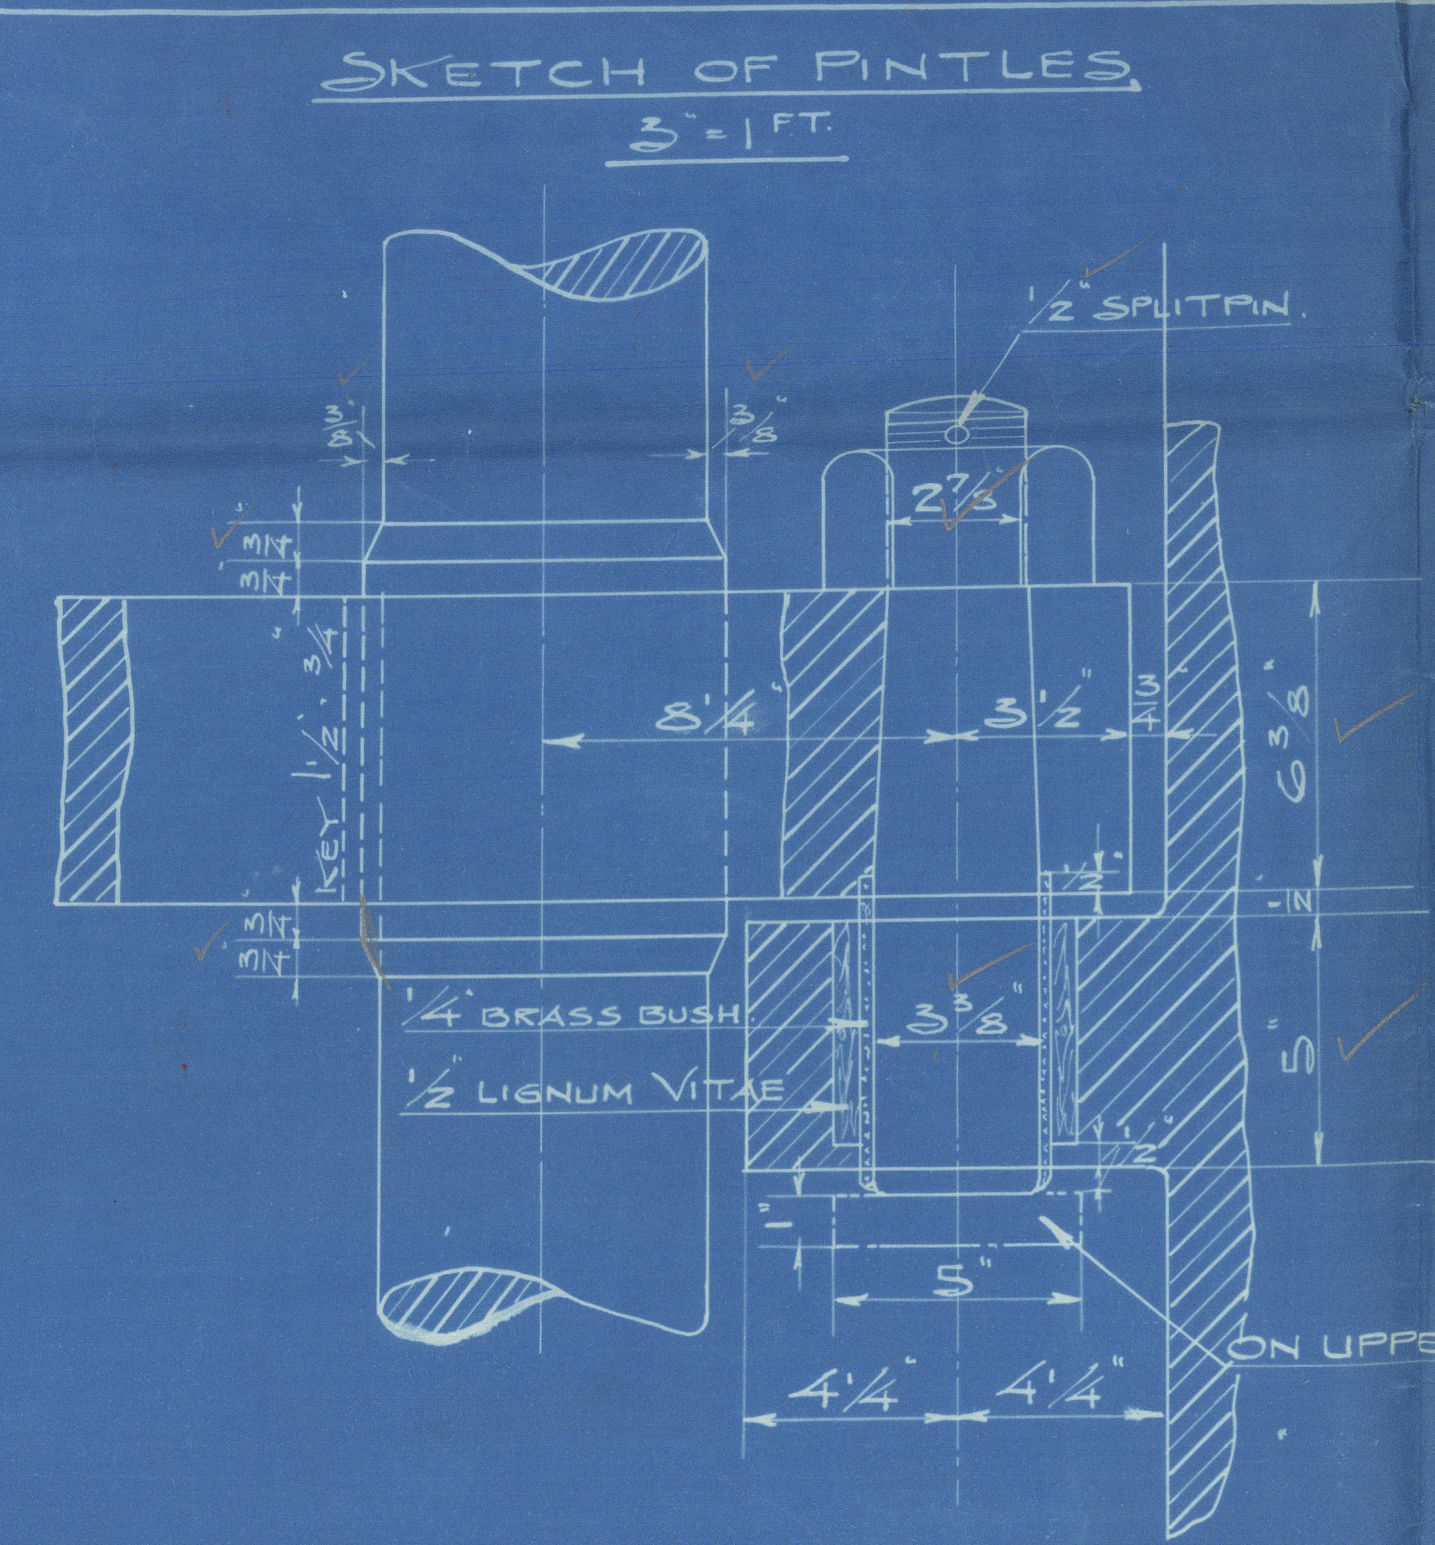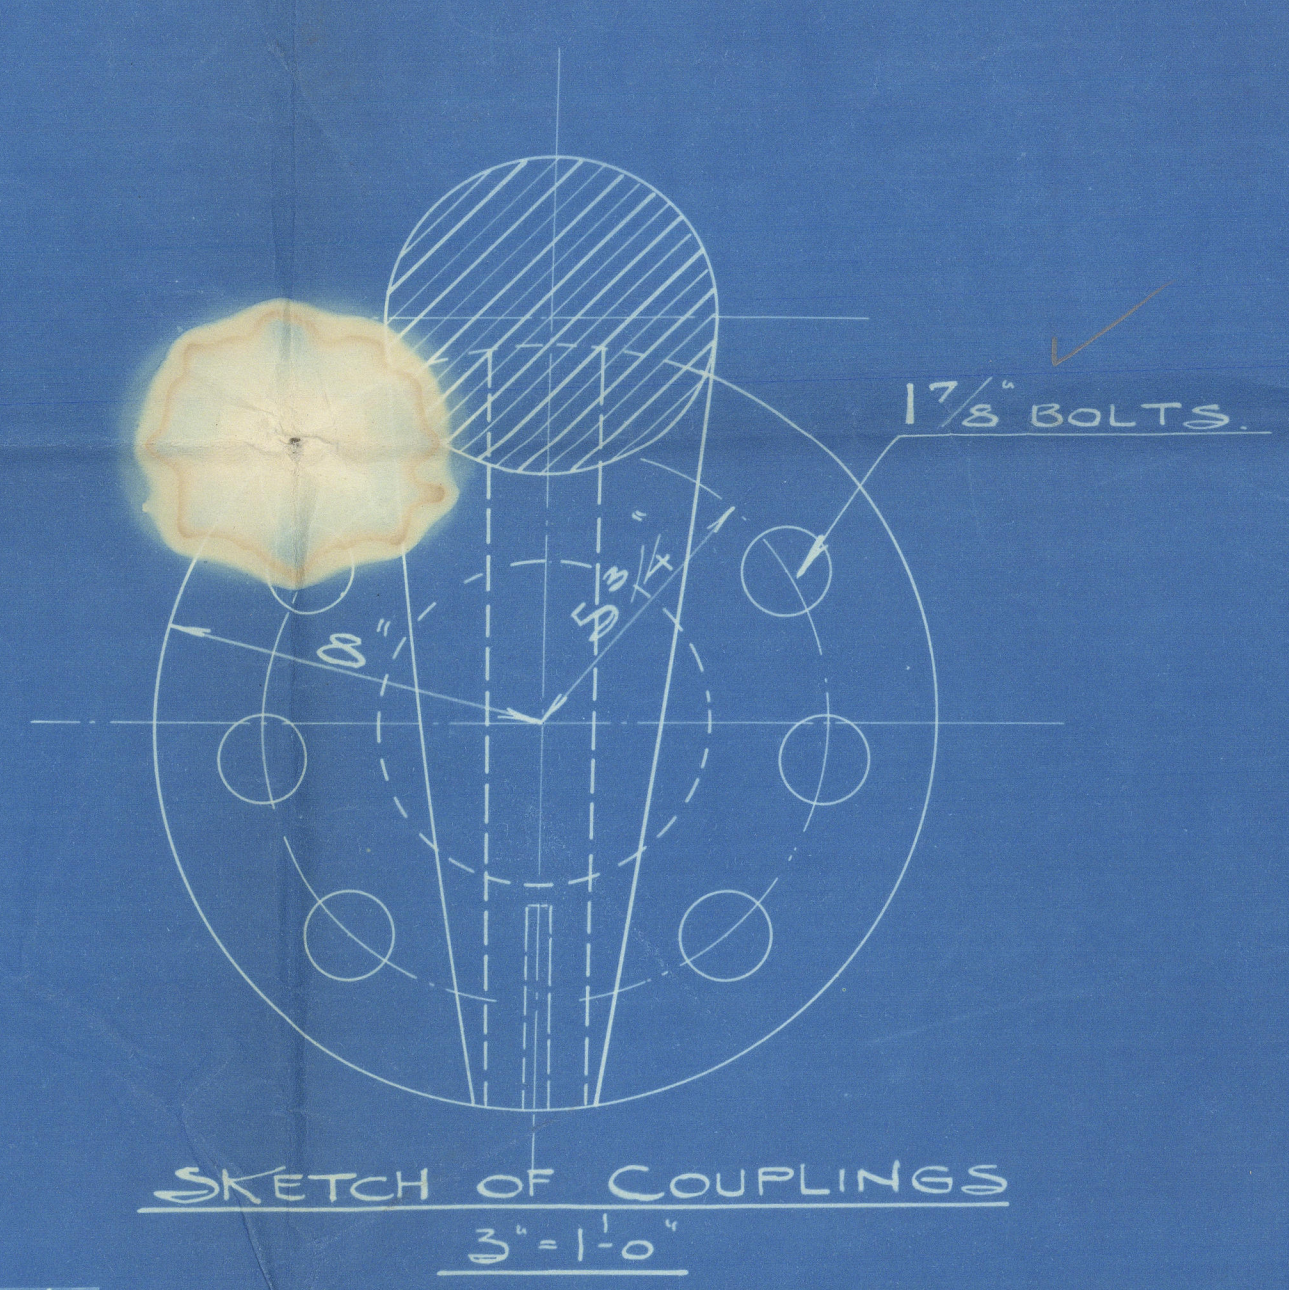

SKETCH OF RUDDER STOPPER.

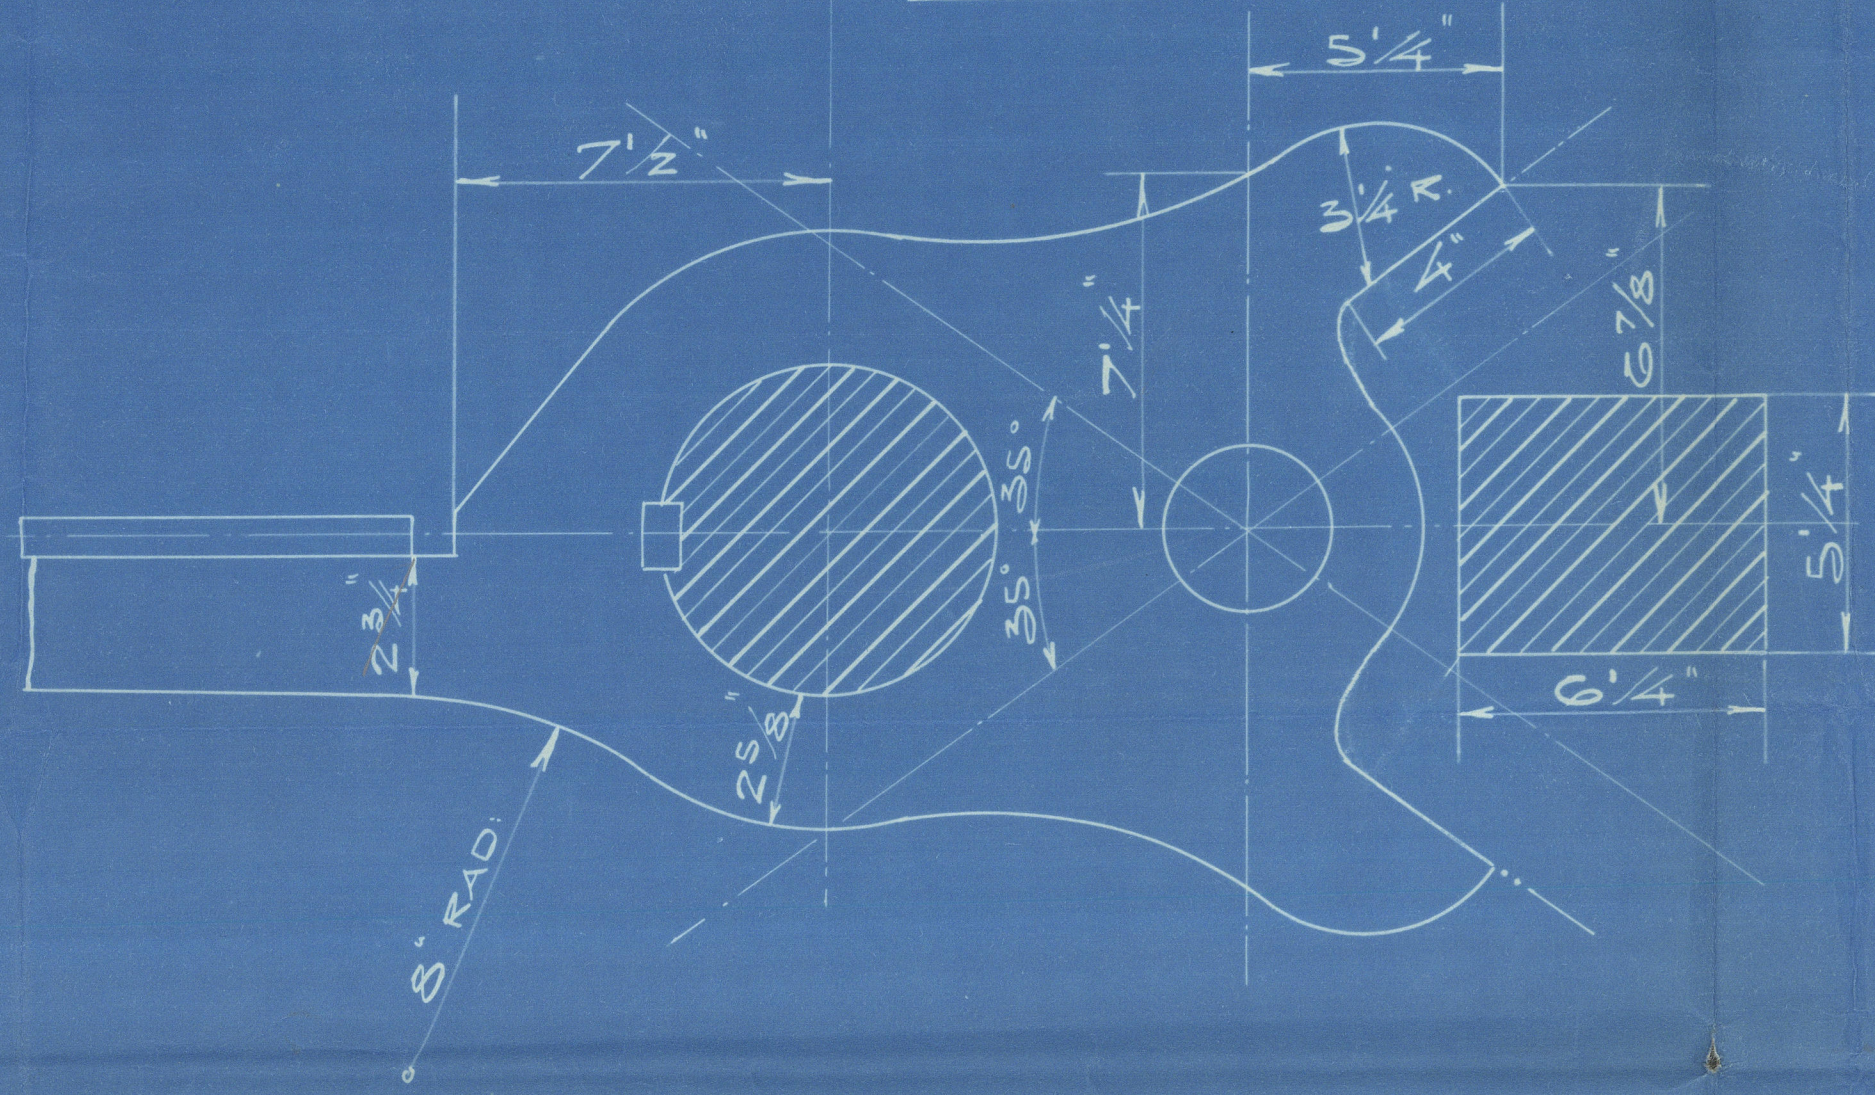


STERNFRAME OF FORGED STEEL
RUDDERHEAD AND MAINPIECE OF FORGED STEEL
RUDDERARMS OF FORGED STEEL
PINTLES " "
TILLER " "
BRITISH CORPORATION'S TEST.

STERNFRAME WITH LIGNUM VITAE
IN GUDGEONS
ALL HOLES TO BE DRILLED.


RUDDER WITH PINTLES, BRASS SLEEVES
NUTS AND SPLITPINS.
ALL HOLES TO BE DRILLED.

AREAL OF RUDDER -- 66 SQUARE FEET
CENTRE OF GRAVITY -- 2.25 AFT PINTLES.

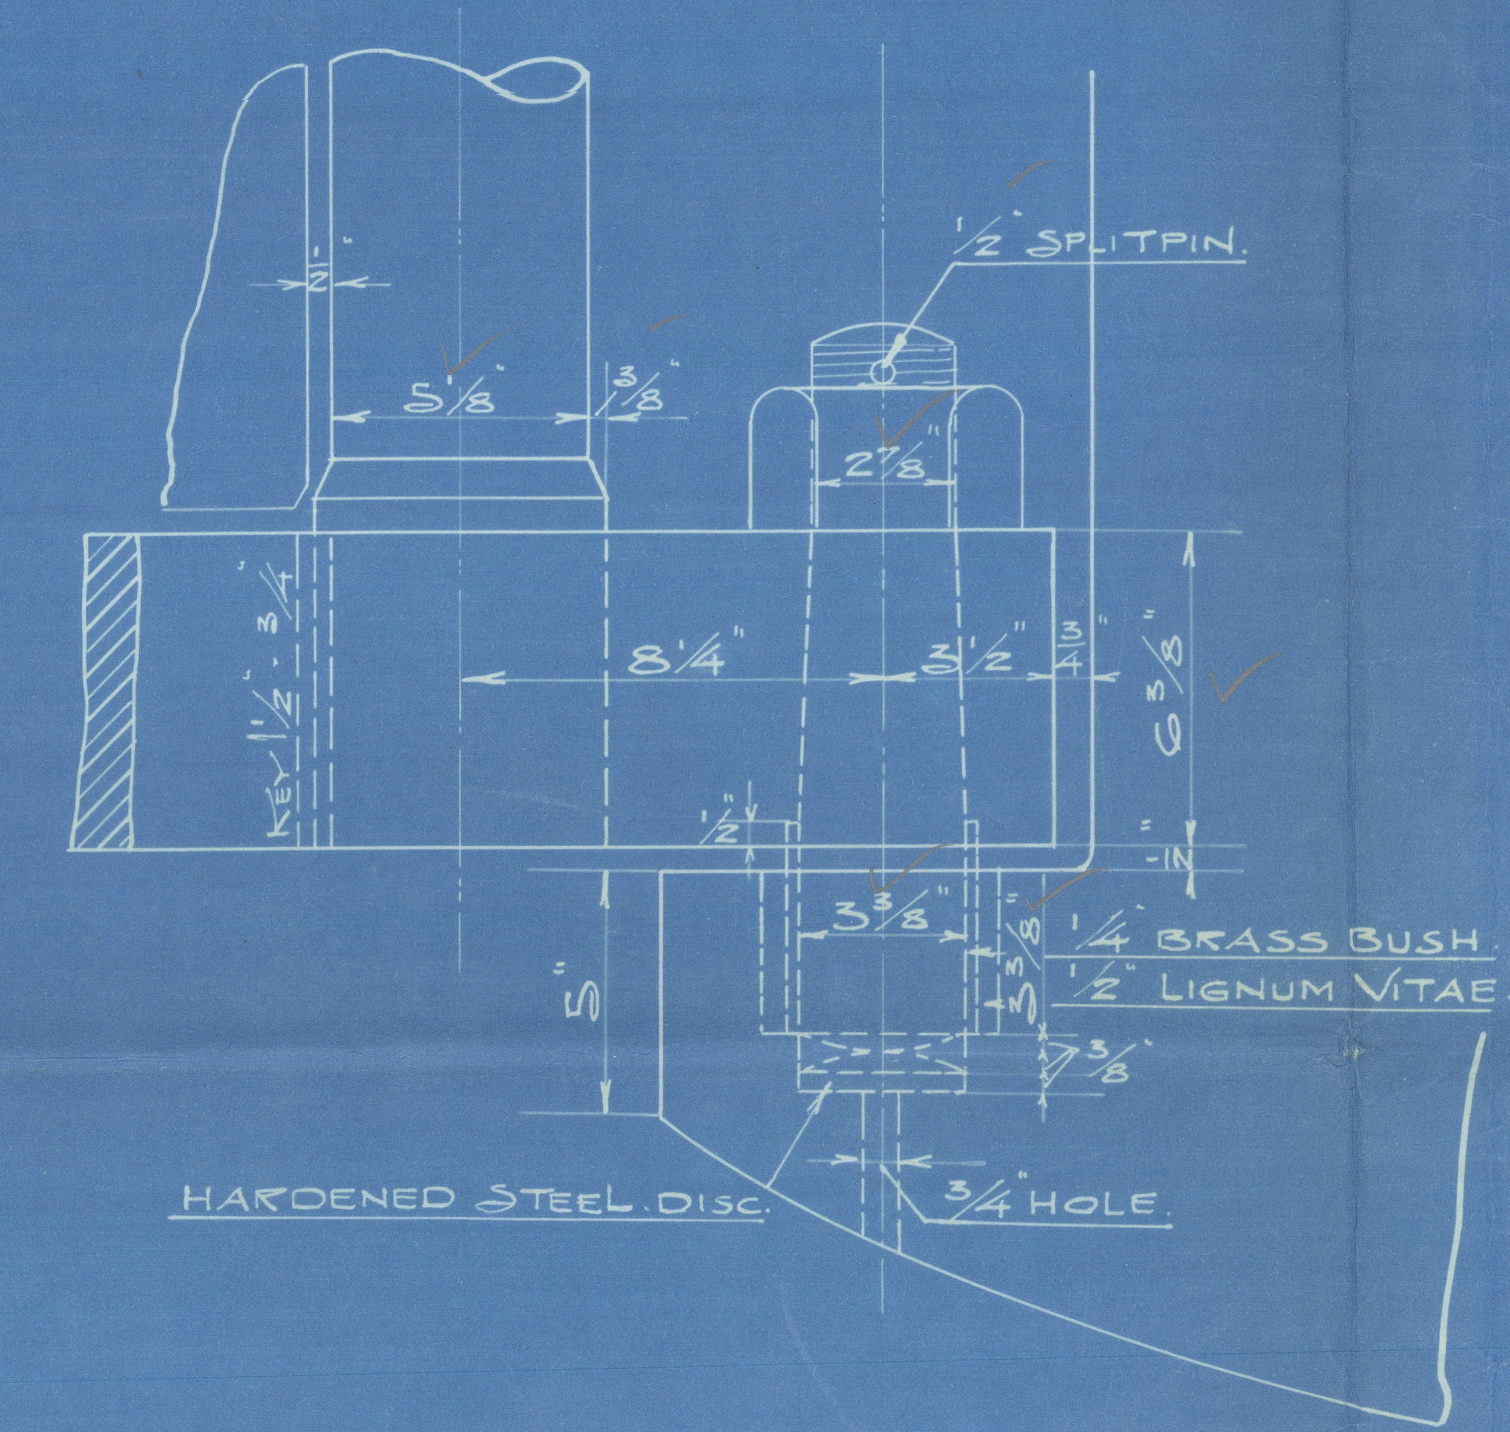



SKETCH OF HEEL PINTLE.

3'-1 FT.

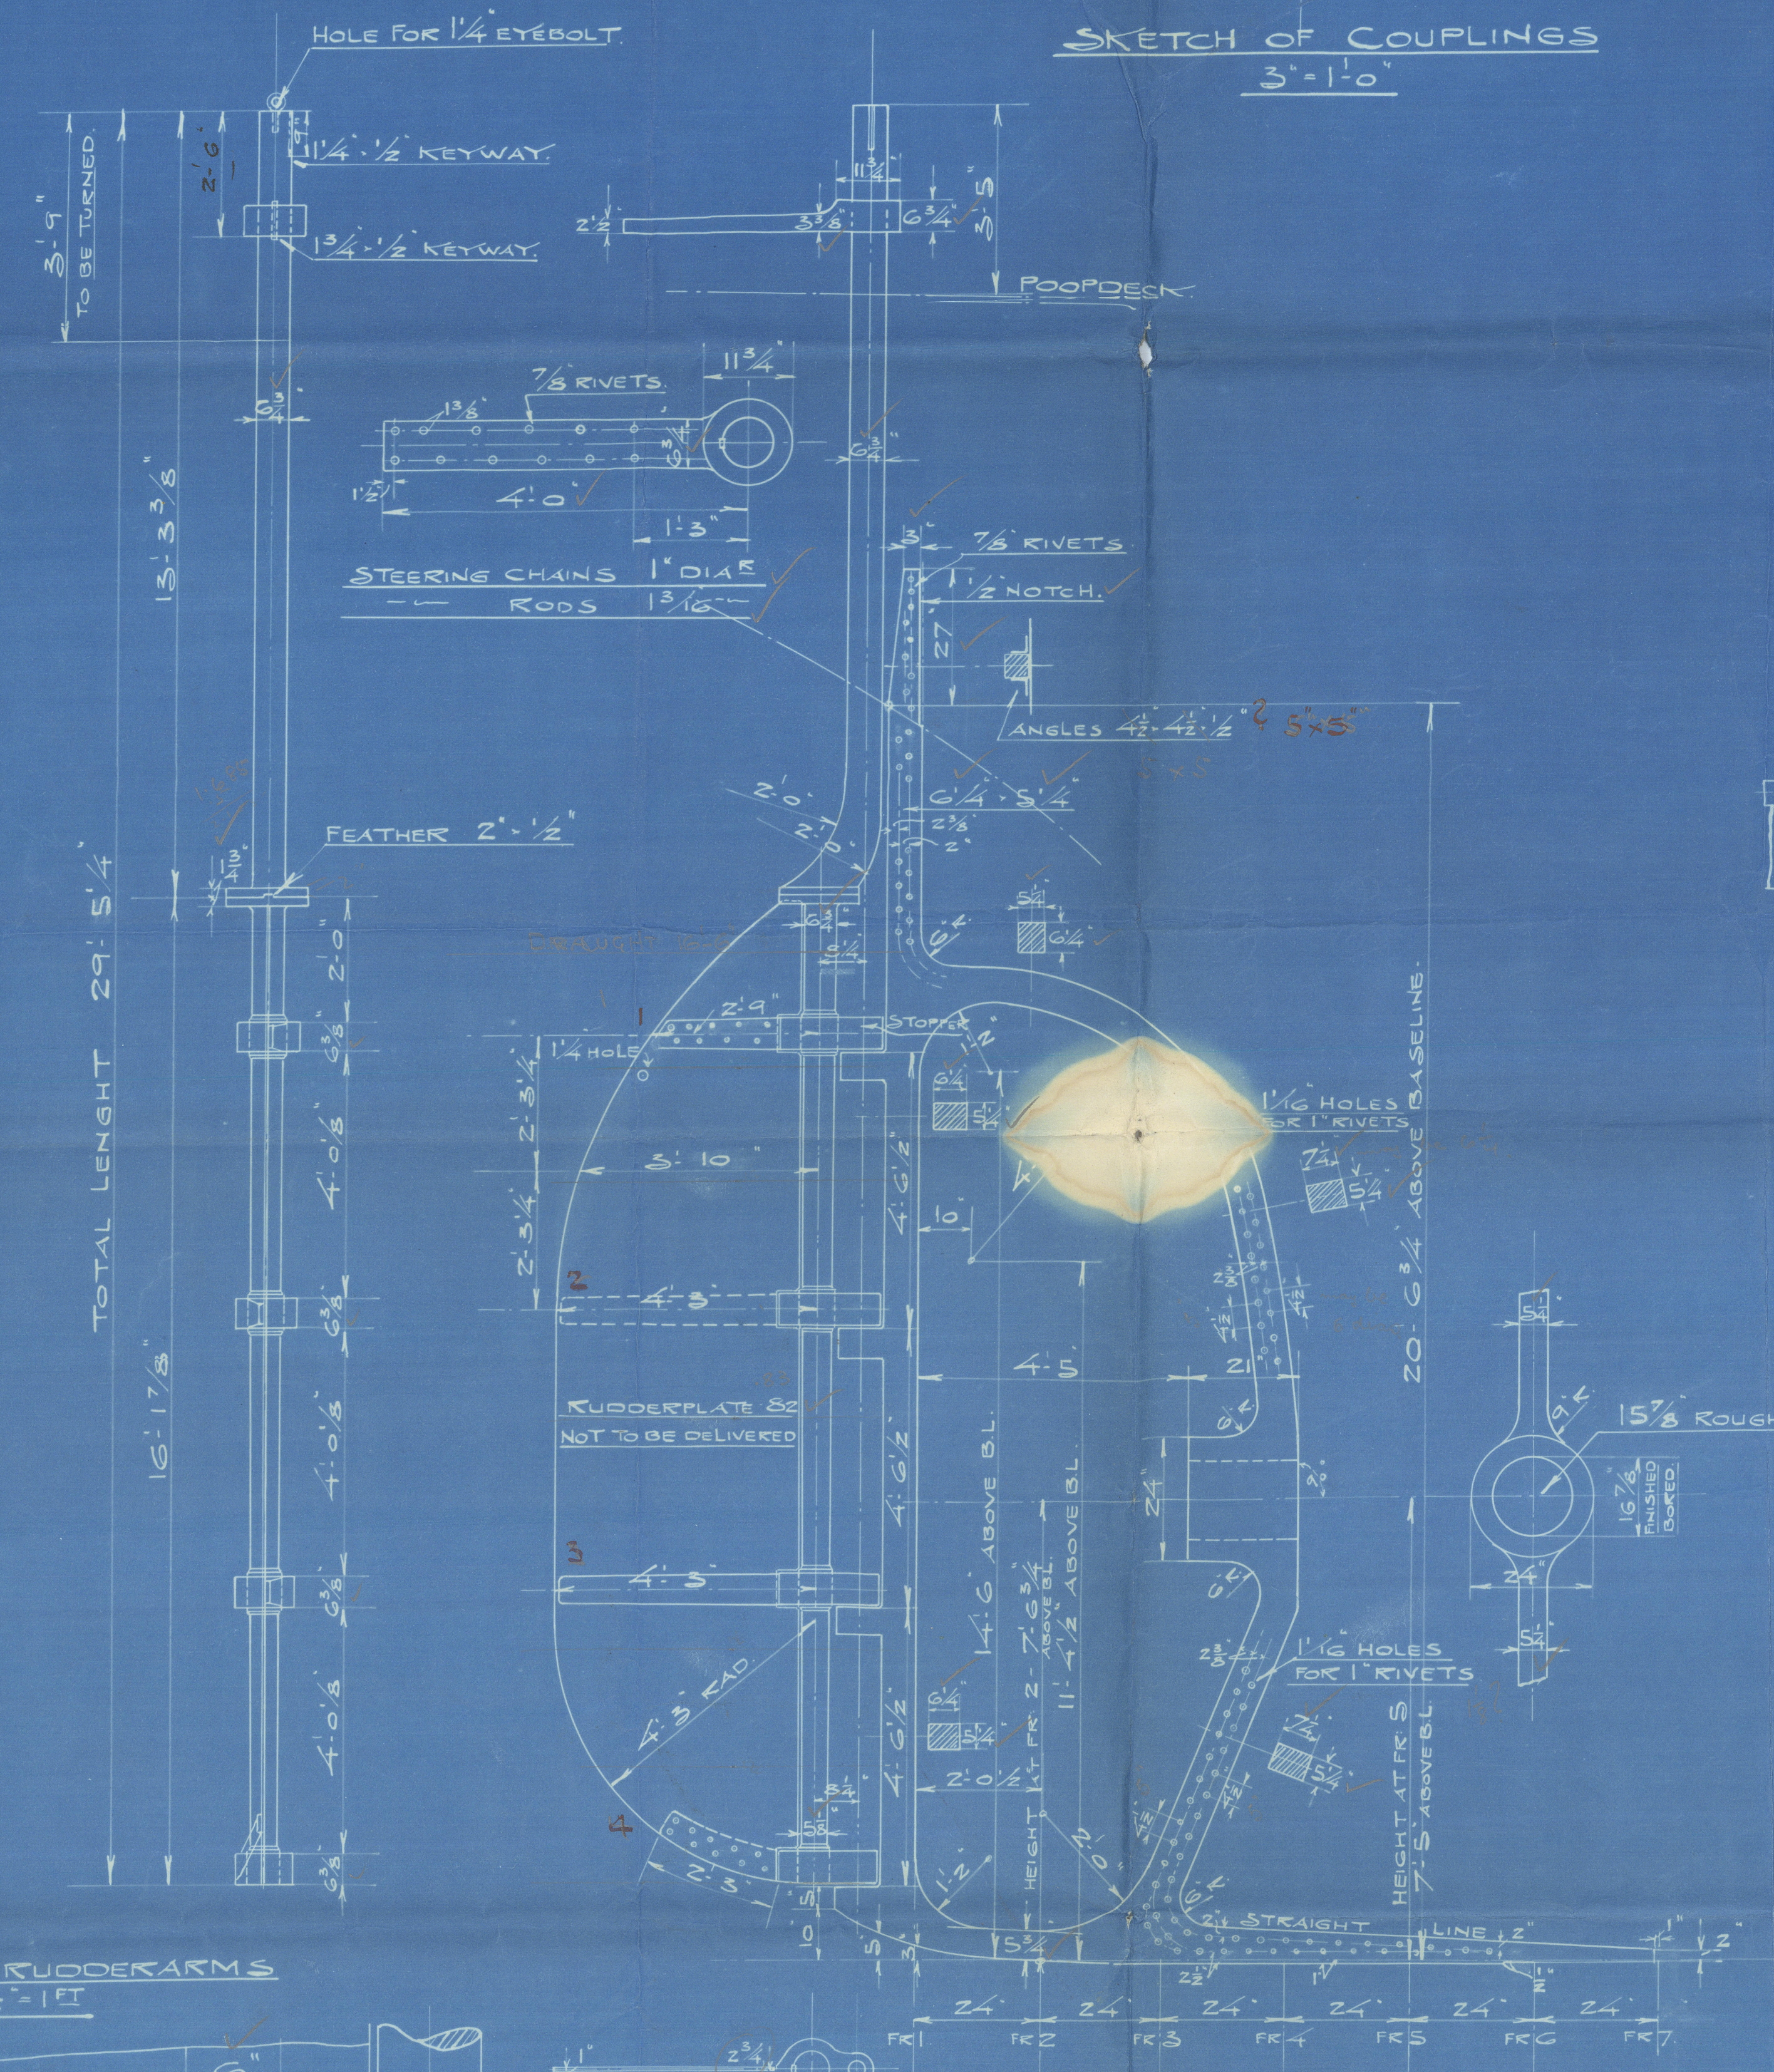

SKETCH OF RUDDERARMS

1 1/2" = 1 FT.

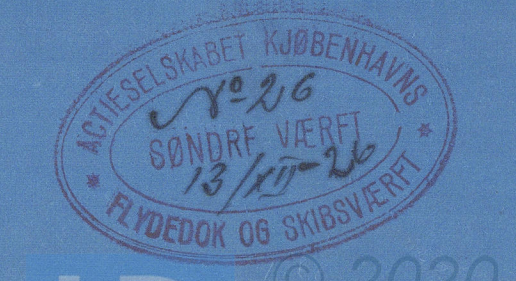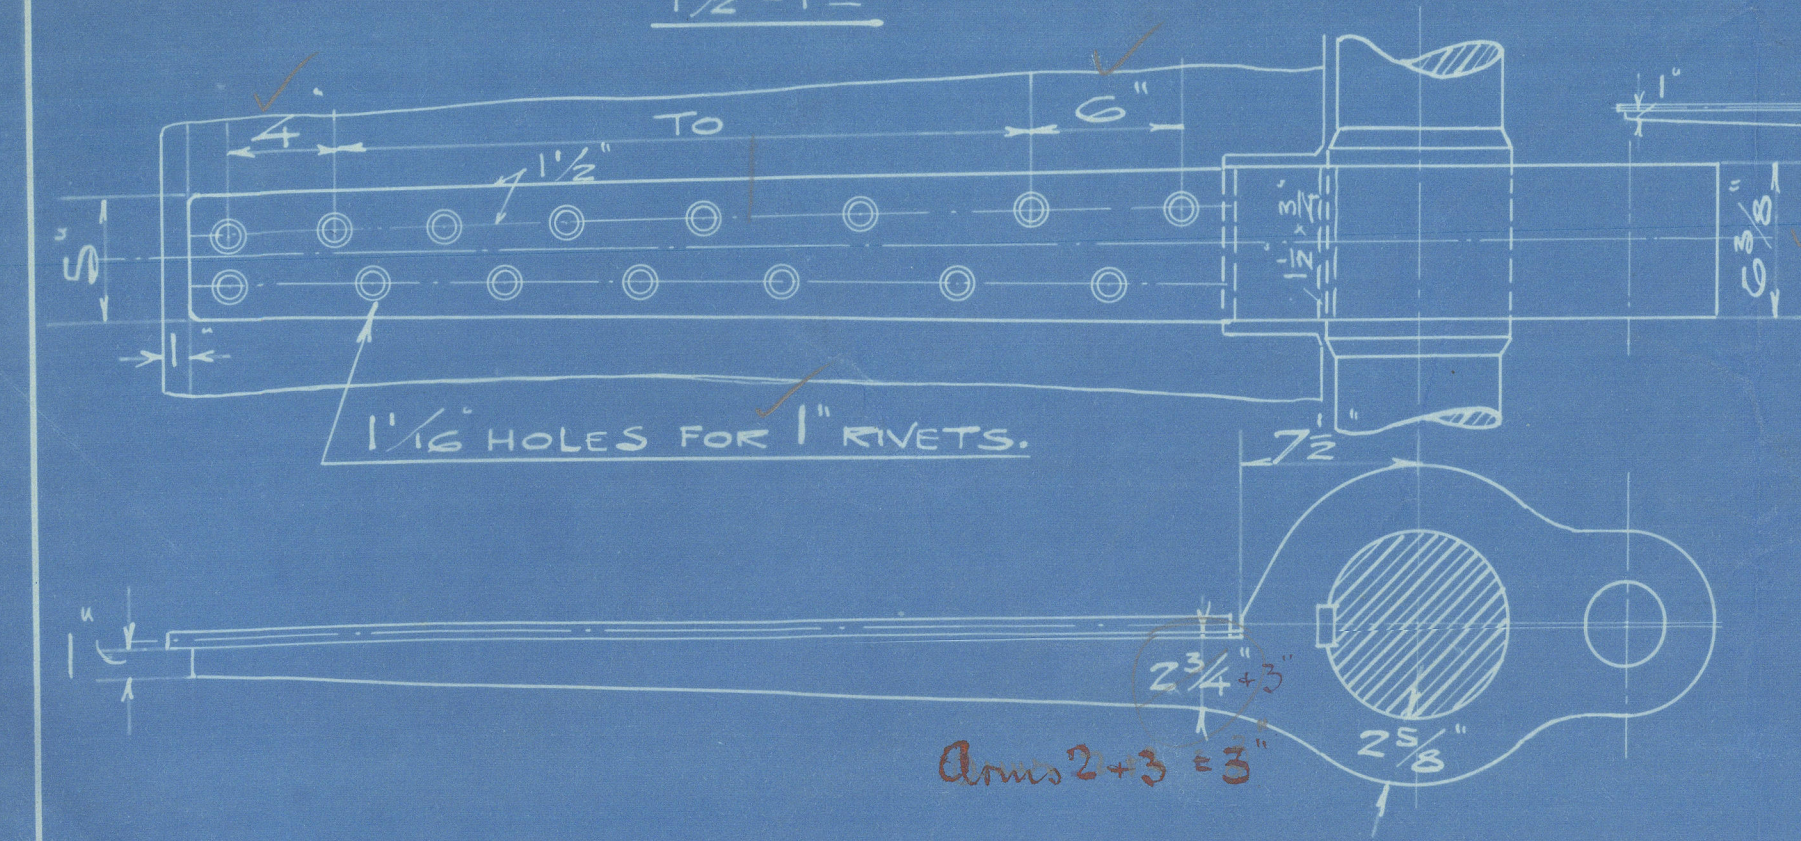

009200 - 009210 - 002600

H

Sternframe & Rudder.

Copenhagen D. D.

185 - 6.

17 - 12 - 26.

s/s "Aslaug"

s/s "Paris"

bag

64



© 2020

Lloyd's Register
Foundation

009200 - 009210 - 002600