


$$L = 121.92 + 5.5 = 127.42 \cdot 0.96 = 122.32 \text{ FOR CRUISER STERN}$$

18

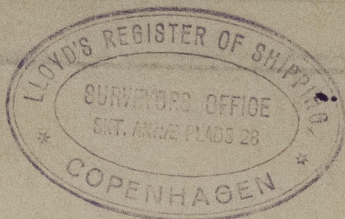

4/5 Nakslov Skibsværft. Yard. N° 78

M/V "Norden"

Midship Section

"as-built"

Gen. Rpt. N° 10240.

"FIRETHORN"

Rykt No

10240



© 2021

009222 009231 0058

Lloyd's Register
Foundation