

Lloyd's Register of Shipping.


SURVEYS FOR FREEBOARD.

(CONDITIONS OF ASSIGNMENT.)

26d 5397.

Ship's Name **"C.625"** Port of Survey **Northwich**
 Official Number **169831** Surveyor's Signature **W. Boylan**
 Nationality and Port of Registry **British London** Date of Survey **Whilst Building**

Disposition and dimensions of superstructures, trunks, deckhouses and machinery casings to be inserted in the diagrams and tabular statement:--

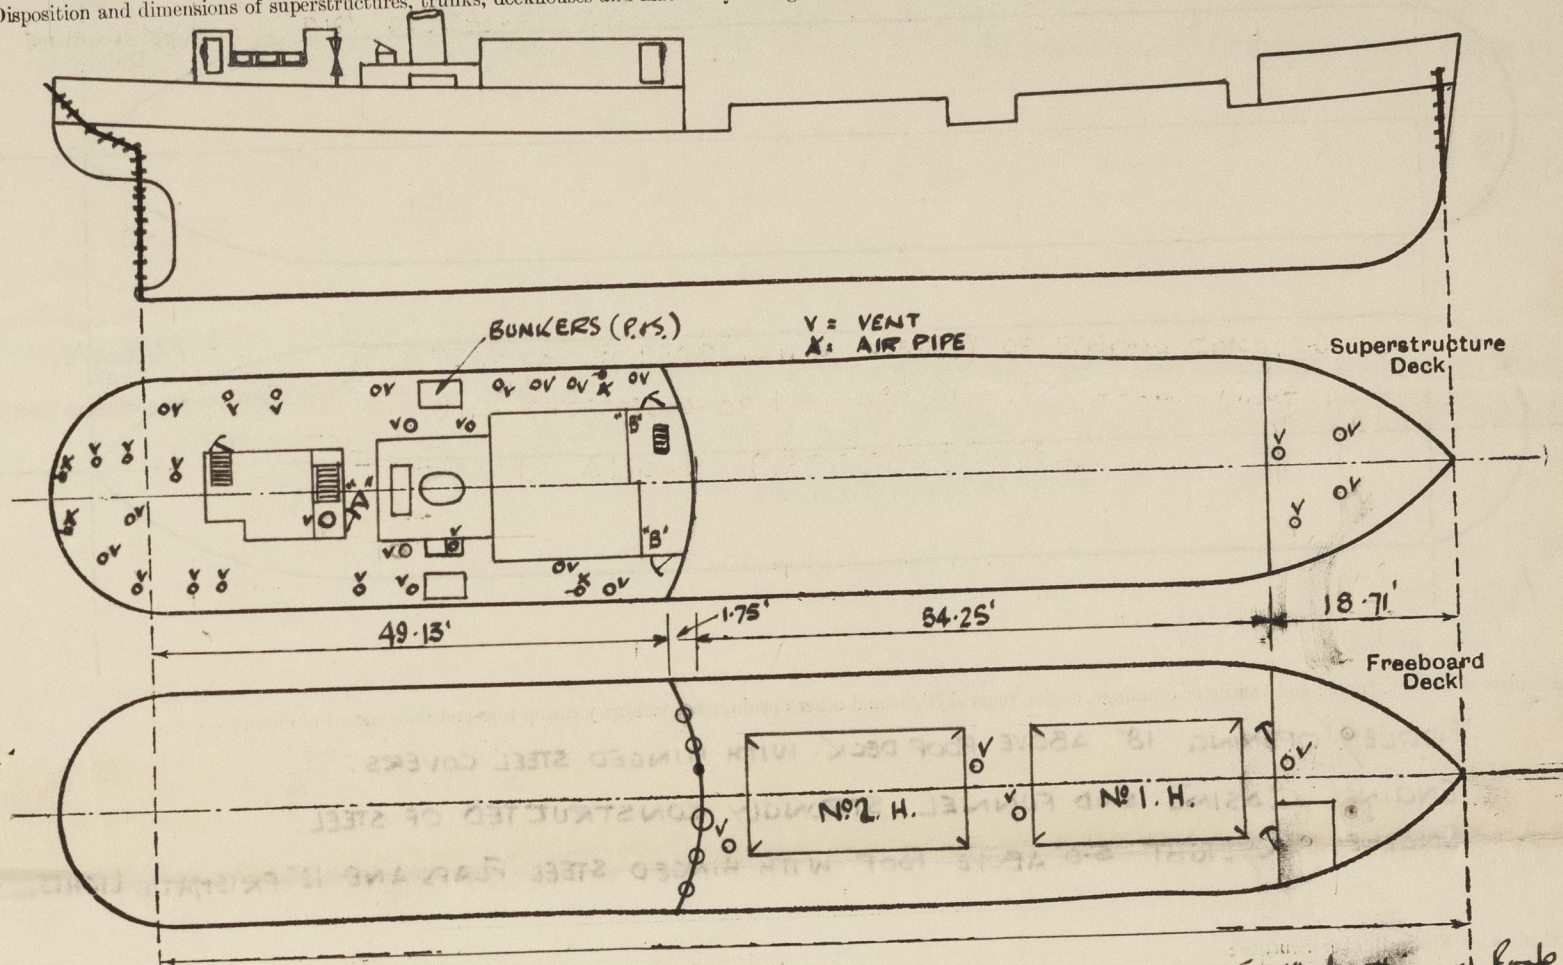


1" sheathing at Poop Deck
 omitted as was measure.

Particulars of Superstructures, Trunks, Casings, Deckhouses.								
	Coaming	Plating	Stiffeners	Spacing	End Attachments of Stiffeners	Size of Openings	Height of Sills	Height of Casings
Poop Bulkhead ...	32	32	5 x 2 1/2 x 35L	24" - 27"	E.M. AT BOTTOM BRIKE AT TOP	NONE	✓	6'-10" BEAMS
Raised Quarter Deck Bulkhead ...	✓							
Bridge, After Bulkhead ...	✓							
Bridge, Forward Bulkhead ...	✓							
Forecastle Bulkhead ...	30	25	2 1/2 x 2 1/2 x 25L	30	✓	{ 10 20' x 4'-6" x 18" 10 23' x 4'-6" x 24"		6'-6"
Trunk, Aft ...	✓							
Trunk, Forward ...	✓							
Exposed Machinery Casings on Freeboard or Raised Quarter Decks ...	✓							
Exposed Machinery Casings on Superstructure Decks ...	30	30	2 1/2 x 2 1/2 x 25L	30	BRIKE AT TOP	4'-0" x 2'-0"	24'	6'-3" AND 3'-0"
Machinery Casings within Superstructures not fitted with Class I Closing Appliances ...	✓							
Deckhouses on Flush Deck Ships ...	✓							

Particulars of Closing Appliances (state if capable of being manipulated from both sides).

Poop Bulkhead ...	NO OPENINGS
Raised Quarter Deck Bulkhead ...	✓
Bridge, After Bulkhead ...	✓
Bridge, Forward Bulkhead ...	✓
Forecastle Bulkhead ...	ONE HINGED STEEL DOOR & ONE HINGED TEAK DOOR, EACH MANIPULATED BOTH SIDES.
Exposed Machinery Casings on Freeboard or Raised Quarter Decks ...	✓
Exposed Machinery Casings on Superstructure Decks ...	ONE HINGED STEEL DOOR MANIPULATED BOTH SIDES
Machinery Casings within Superstructures not fitted with Class I Closing Appliances ...	✓
Deckhouses on Flush Deck Ships ...	✓

The following diagrams should be used to indicate the positions of cargo and coaling hatchways, gangway, cargo and coaling ports, ventilators, companionways, etc., which would affect the seaworthiness of the ship :—

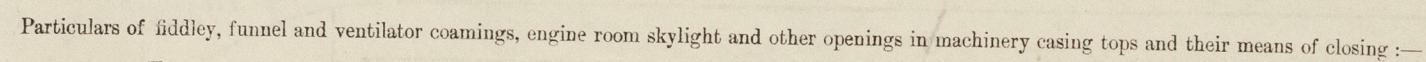

FIDDLEY OPENING 18" ABOVE POOP DECK WITH HINGED STEEL COVERS. ✓
ENGINE CASING AND FUNNEL STRONGLY CONSTRUCTED OF STEEL. ✓
ENGINE SKYLIGHT 3'-0" ABOVE POOP WITH HINGED STEEL FLAPS AND 12" PRISMATIC LIGHTS. ✓

NONE.

SEE SKETCH { "A" ON POOP AFT 2'-0" x 4'-6" STEEL DOOR MANIPULATED BOTH SIDES BUILT INTO STEEL STEEL HOUSE.
"B" " " FORD 22" x 4'-6" HARD WOOD DOOR " " (ONE EACH SIDE OF BRIDGE HOUSE)
Sizes as per load line requirements.

Particulars of Ventilators in exposed positions on freeboard and superstructure decks:—			
<u>FORECASTLE DK.</u>	3	IN NO 5½"	DIA. COWL VENTS. TO FO'C'LE SPACES.
	1	" " 6"	" MUSHROOM " " " "
<u>FREEBOARD DK.</u>	1	" " 11½"	" COWL VENT. TO NO 1 HOLD (COAMING THROUGH FO'C'LE).
	1	" " 11½"	" " " NO 1 " " "
	2	" " 11½"	" " " NO 2 " " "
<u>POOP DK.</u>	13	" " 6"	" MUSHROOM VENTS.
	1	" " 8"	" COWL VENT. (ON TOP OF GALLEY SKYLIGHT).
	8	" " 5½"	" " " " " " " "
	2	" " 18"	" " " WITH EXTENDED COAMINGS AND MECHANICALLY TURNED COWLS (TO STOVEHOLD).
	1	" " 8"	" " " (ON TOP OF AFTER COMPANIONWAY).

ALL VENTS OF OF STRONG STEEL CONSTRUCTION. HEIGHTS OF COAMINGS CONFORM WITH REQUIREMENTS.
EFFICIENT CLOSING APPLIANCES SUPPLIED. ✓

FORE PEAK TANK AIR PIPE LED ONTO FREEBOARD DK. (P.S.). JUST ABOVE DECK LEVEL. PIPE IN FORECASTLE FITTED WITH BEND 36" HIGH. ✓
BOILER FEED TANKS AIR PIPES CARRIED ABOVE POOP, 2" DIA. 36" TO OPENINGS (I.P.T.S.)
AFTER PEAK TANK AIR PIPES 2" DIA. 28" ABOVE POOP. (I.P. & I.S.)
EFFICIENT CLOSING APPLIANCES SUPPLIED. ✓

NONE

SCUPPERS FROM FBØ. AND POOP DKS. CUT IN GUNWALE ANGLES.
OFFICERS & CREWS W/C'S DIS. THROUGH 4" DIA. AUTOMATIC S.D.N.R. VALVE CONTROLLED FROM FBØ DK.
OFFICERS BATH & W/BASIN DIS. LED OVERBOARD THROUGH A COMMON 2" AUTOMATIC S.D.N.R. VALVE " " "
CREWS W/BASIN & SCUPPERS LED OVERBOARD THROUGH COMMON 2" " " " " " " (IFTS)
GALLEY SINK DIS. OVERBOARD ABOVE FBØ. DK. FITTED WITH LOCALLY CONTROLLED STOP VALVE (P.S.).

10' DIA. N.B. FRAMES & DEADLIGHTS (HINGED) OF STRONG CONSTRUCTION FITTED
THROUGHOUT WITH EXCEPTION OF 1 IN N° 15' DIA. "ESCAPE" LIGHT IN POOP FRONT(S.S.).
ALL ABOVE FREEBOARD DECK. ✓

Vertical distance of Sill of lowest Side Scuttle above top of keel

3'-0" STEEL STANCHIONS (2 BALL) SPACED 5'-0" APART, STEEL RAILS
18" APART FITTED ON FORECASTLE AND POOP DECKS. ✓


EFFICIENT LIFELINES FITTED BETWEEN POOP AND FORECASTLE BULKHEADS

Particulars of Freeing Arrangements.						
	Length of Bulwark	Height of Bulwark	Size of Freeing Ports	Number each side	Area each side	Rule area each side
After Well	56'-0"	3'-0"	10'-0" x .75'	3.	22.5 s.f.	12.1 s.f.
Forward Well	✓					

State position of each freeing port (After Well:— AFTER ENDS OF OPENINGS FROM POOP FRONT 5'-0", 19'-0", 29'-0"
(F. and A. position and height above deck edge) (Forward Well:— ✓

State whether the freeing ports are fitted with shutters, bars, or rails, and give particulars of such:— NONE.

Additional area where sheer is less than standard.



© 2021
Lloyd's Reg
Foundation

PARTICULARS OF PROTECTION TO OPENINGS, ETC.

HATCHWAYS ON FREEBOARD AND SUPERSTRUCTURE DECKS.									
← FREEBOARD DK. → POOP DK.									
Description of Hatchway	Nº 1.	Nº 2.	BUNKERS (12.15.)				
Dimensions of Hatchway	18' x 12'	18' x 12'	5'3" x 3'0"				
COAMINGS	{	Height above Deck	...	3'0"		1'6"			
		Thickness	{ Sides	...	40	30			
			{ Ends	...	40	30			
		Stiffeners	...	2 SIDES	7' x 3' x 40 B.A.	As Nº 1.			
Brackets, Stays	...								
HATCH BEAMS	{	Number	...	2					
		Spacing	...	6'0"					
		Scantling and Sketch	...						
			...						
FORE AND AFTERS	{	Number	...						
		Spacing	...						
		Unsupported Lengths	...						
		Scantling* and Sketch	...						
HATCH COVERS	{	Material	...	W.P.		W.P.			
		Thickness	...	2 3/4		2 1/2			
		How fitted	...	F. & A.		ATHWART			
		Bearing Surface	...	3'		2 1/2			
Spacing of Cleats	24.						
Number of Tarpaulins	2.						
<p>*Are wood fore and afters steel shod at all bearing surfaces? <i>yes</i></p> <p>Are battens and wedges efficient and in good condition? <i>yes</i></p> <p>Are tarpaulins in good condition and in accordance with rule requirements? <i>yes</i></p> <p>Are lashings provided in accordance with rule requirements? <i>yes</i></p>									

Particulars of any special features:—

GALLEY SKYLIGHT 19' x 18' x 2'0" STEEL COAMING AND HINGED STEEL W/T COVER ON POOP DK.

Endorsement at first survey and at surveys for renewal of Certificate:—

The fittings and appliances are in accordance with the particulars shown on this form (or as now modified) and are in good condition.



© 2021

Lloyd's Register Foundation