
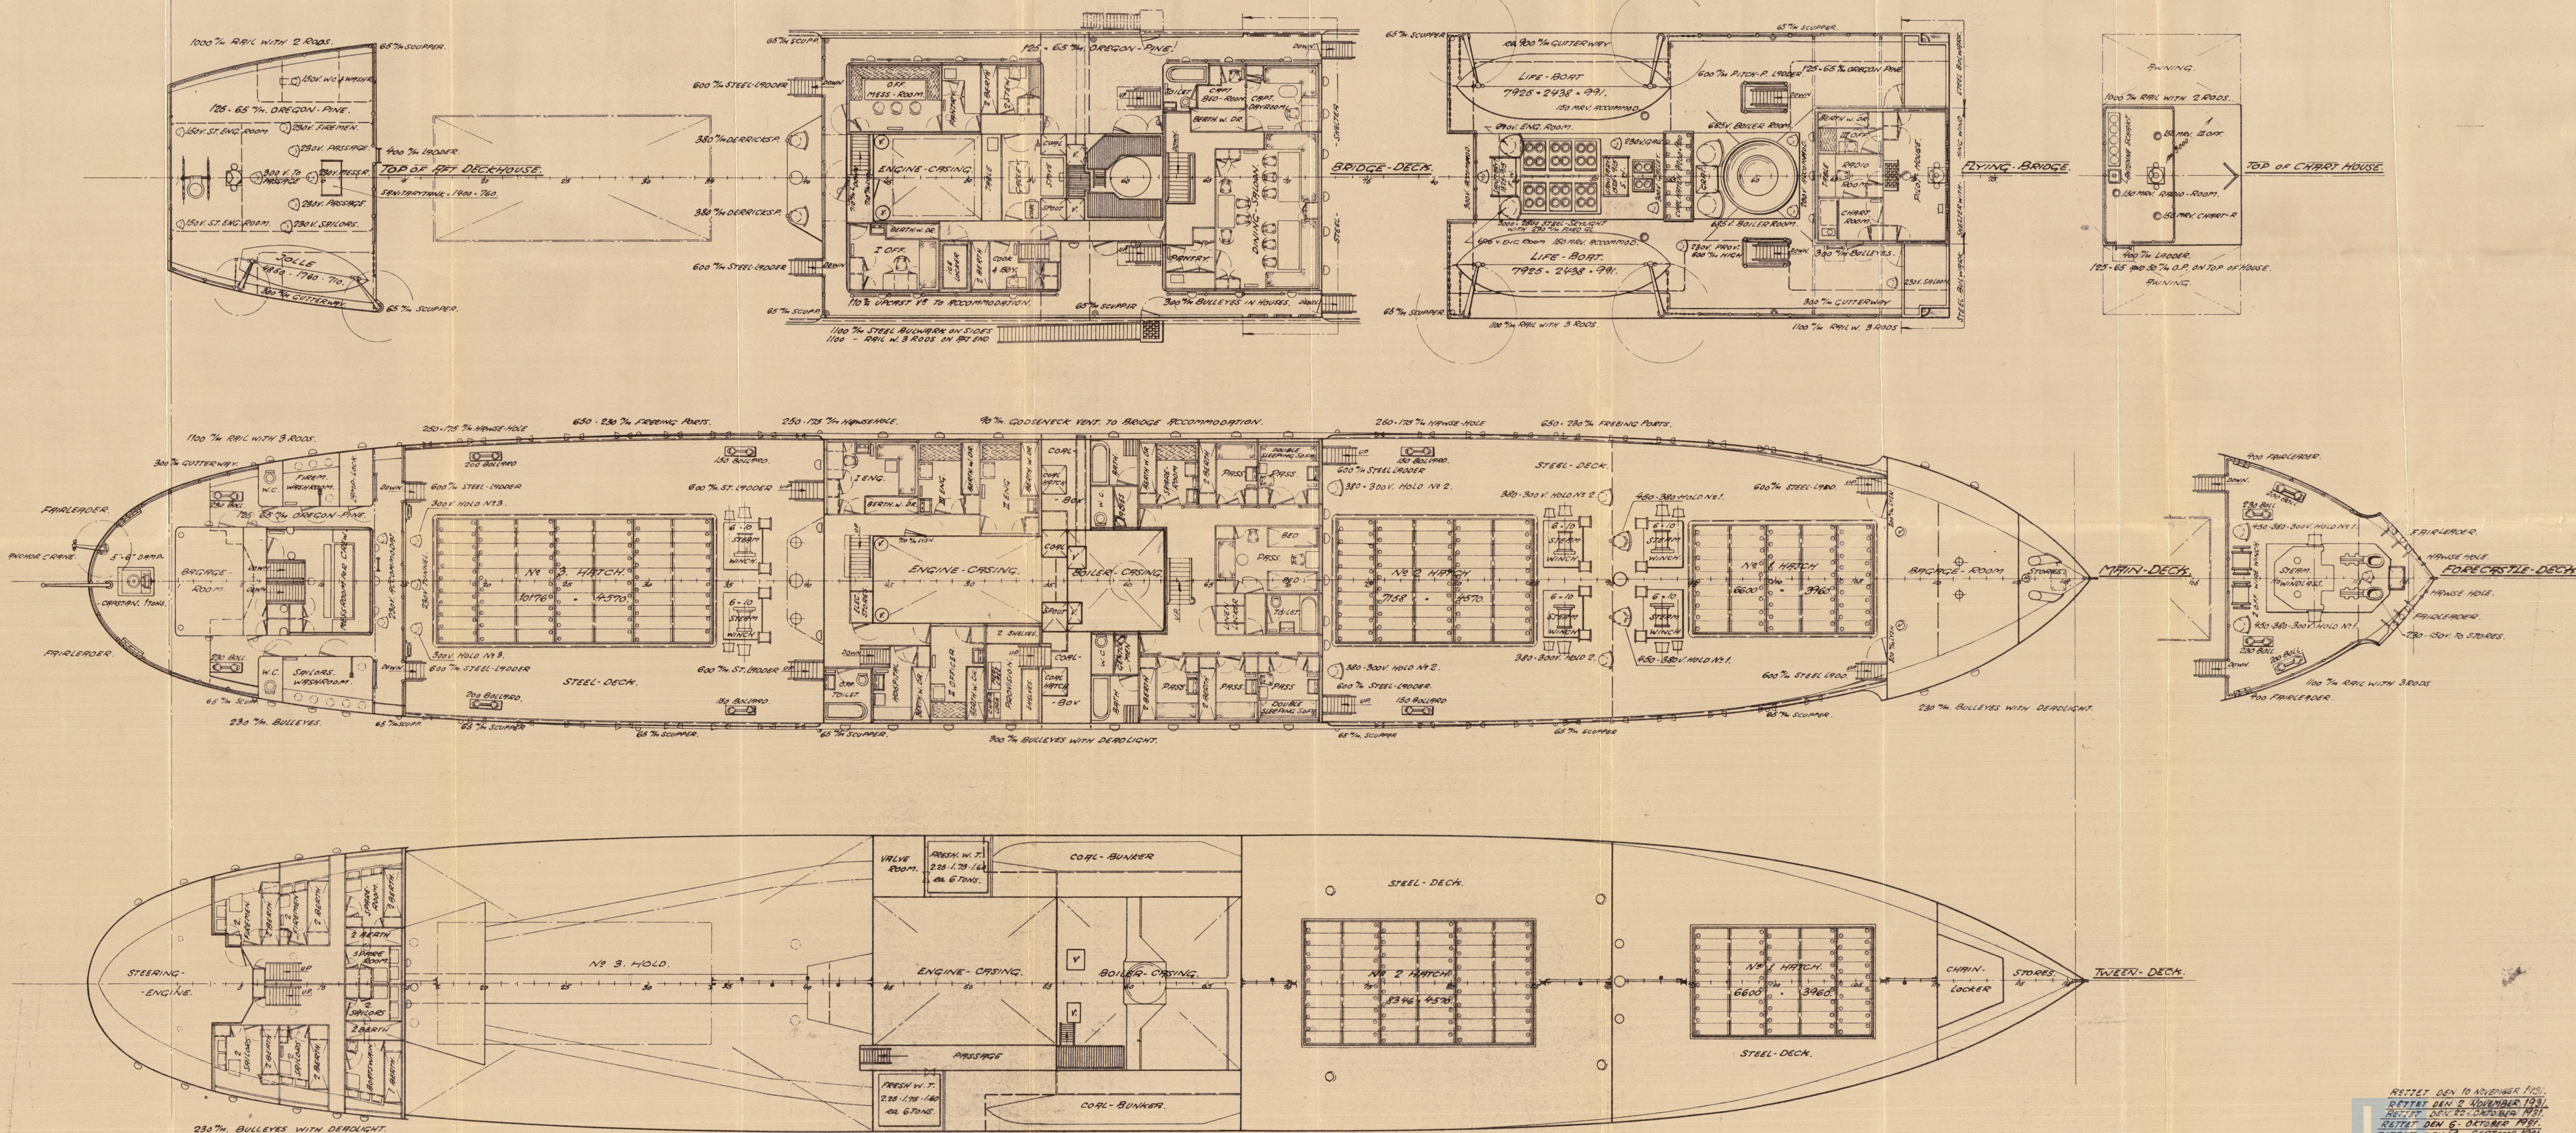


SLASK

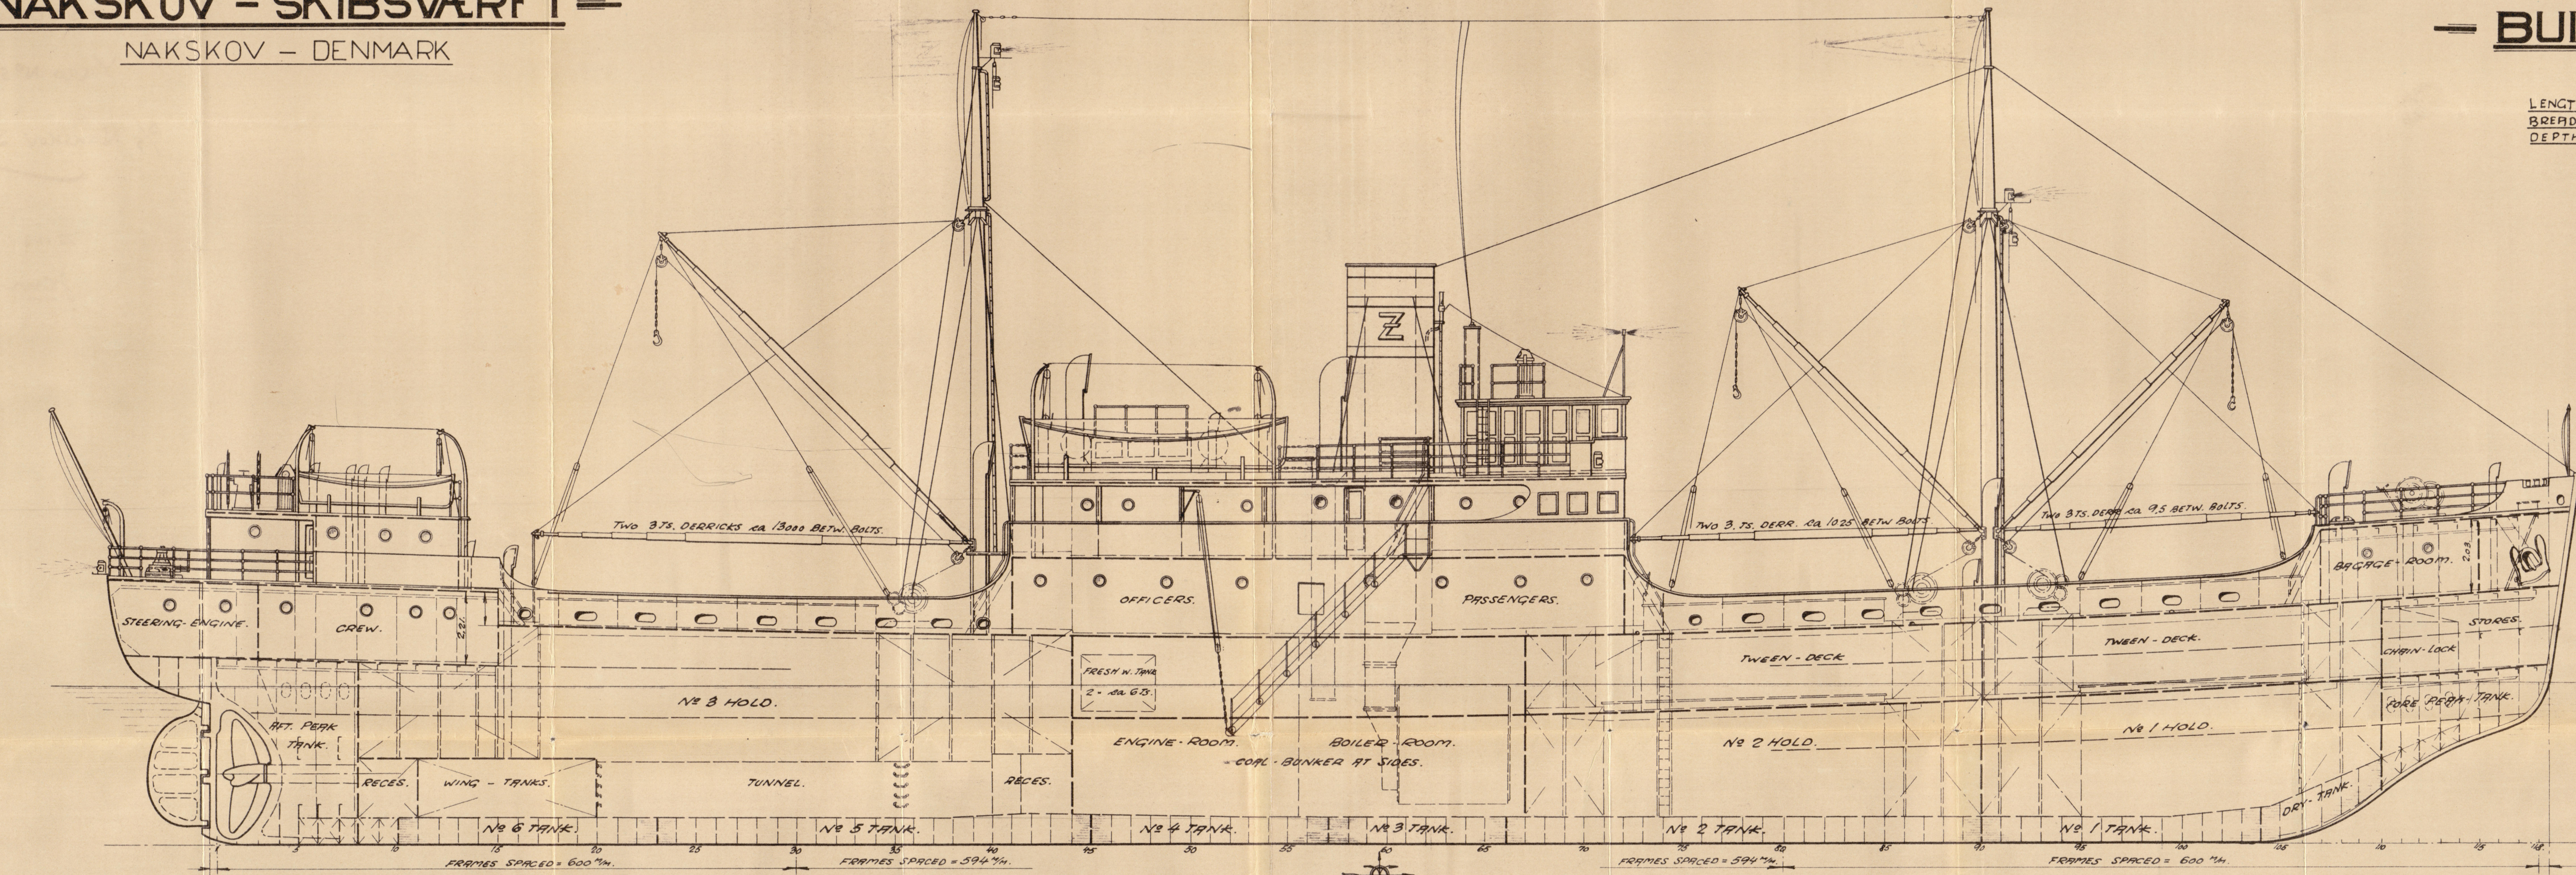


RETTET DEN 10. NOVEMBER 1931.
RETTET DEN 2. NOVEMBER 1931.
RETTET DEN 22. OKTOBER 1931.
RETTET DEN 6. OKTOBER 1931.
RETTET DEN 9. SEPTEMBER 1931.
RETTET DEN 27. AUGUST 1931.
RETTET DEN 8. AUGUST 1931.
P/S. NARSKOV - SKIBSVERFT.
— DEN 3. AUGUST 1931. —

GENERAL ARRANGEMENT (AS BUILT)

S.S. "SLAVIC".

YARD NO 51.

A/S NAKSKOV SKIBSVÆRFT.

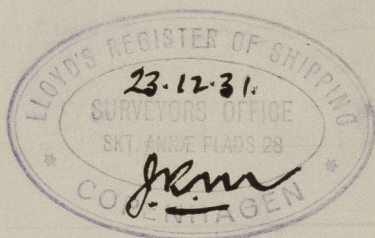

© 2020

Lloyd's Register
Foundation

609232 - 009234 - 0051