

SHIP NO. 387.


SEATINGS FOR DRYER FEET ON MEAT MEAL PLANT.

Scale: $\frac{1}{2}$ " = One Foot.

$35 \times 18 \times 18 = 810 \frac{1}{2}$
 0.15
 0.8
 $1074 \frac{1}{2}$
 $48 \frac{1}{2} \times 24 = 1152$
 $1074 \frac{1}{2} - 1152 = -77 \frac{1}{2}$
 430
 1340
 $18 \times 5 \times 18$
 1940
 2000
 12000


5 FEB. 1945

Approved
100.05
C.H.

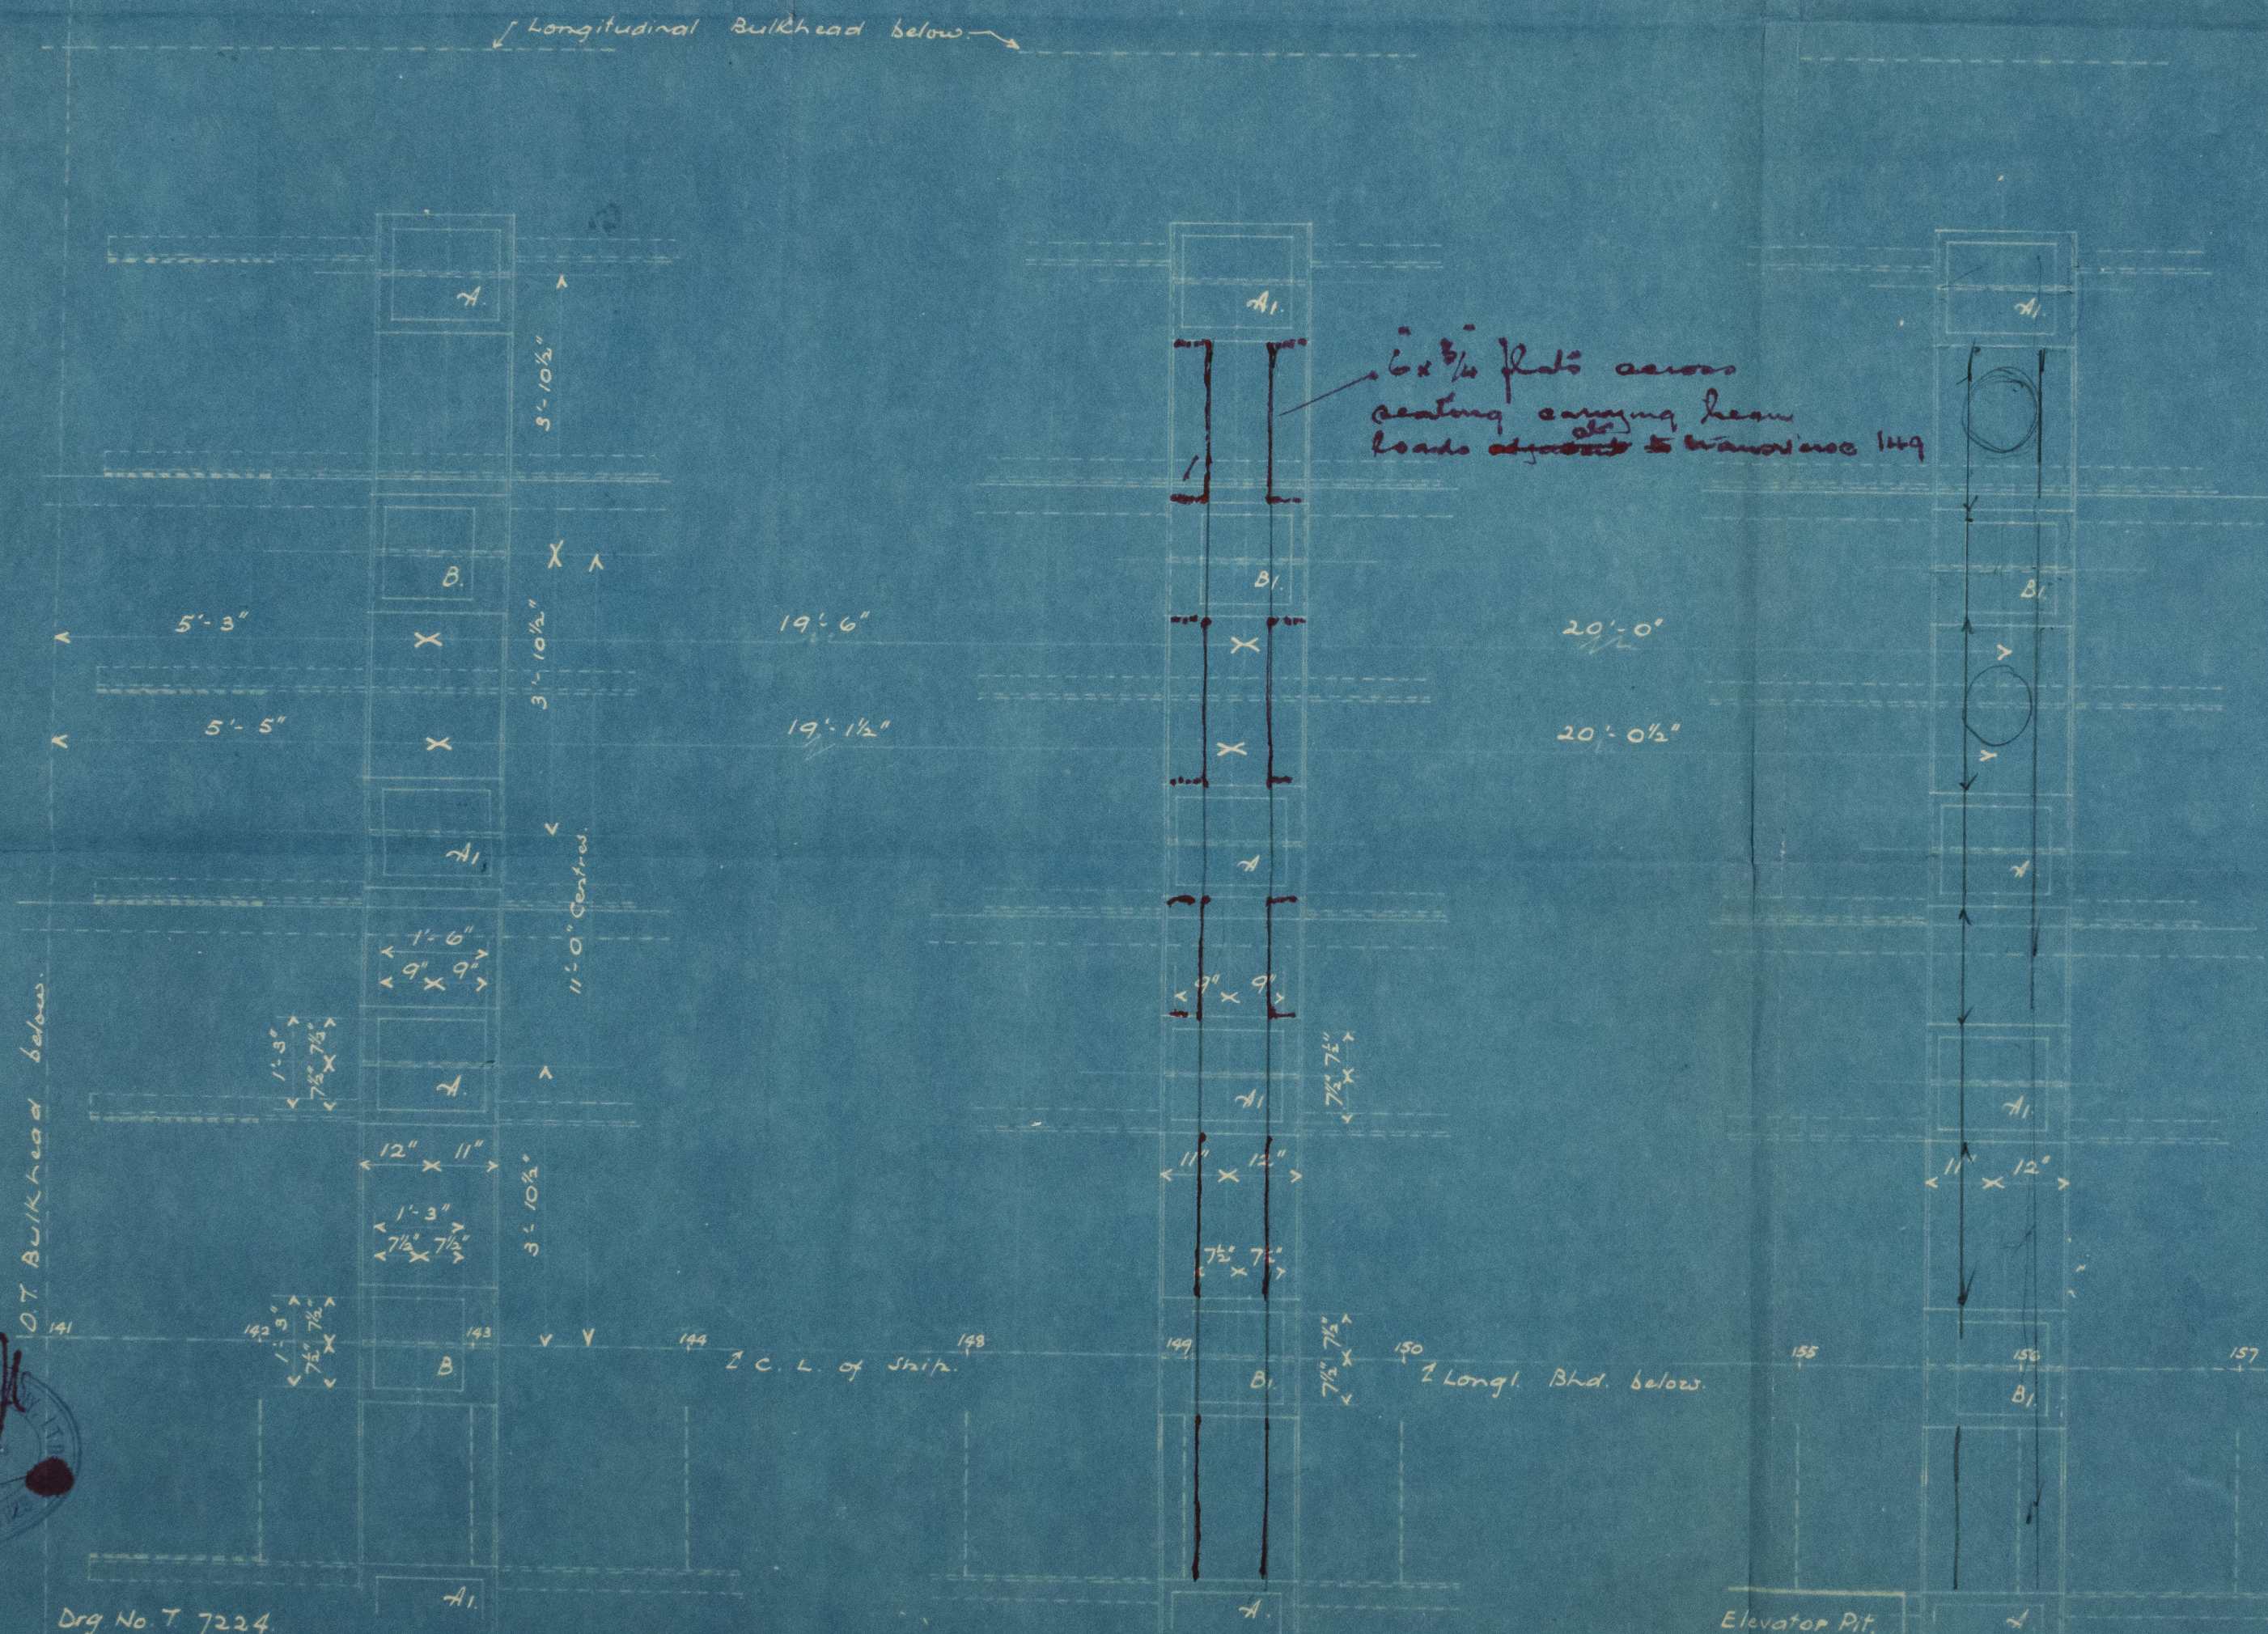

PLAN AT TANK DECK.

SEATINGS ARE SYMMETRICAL ABOUT C.L. OF SHIP.

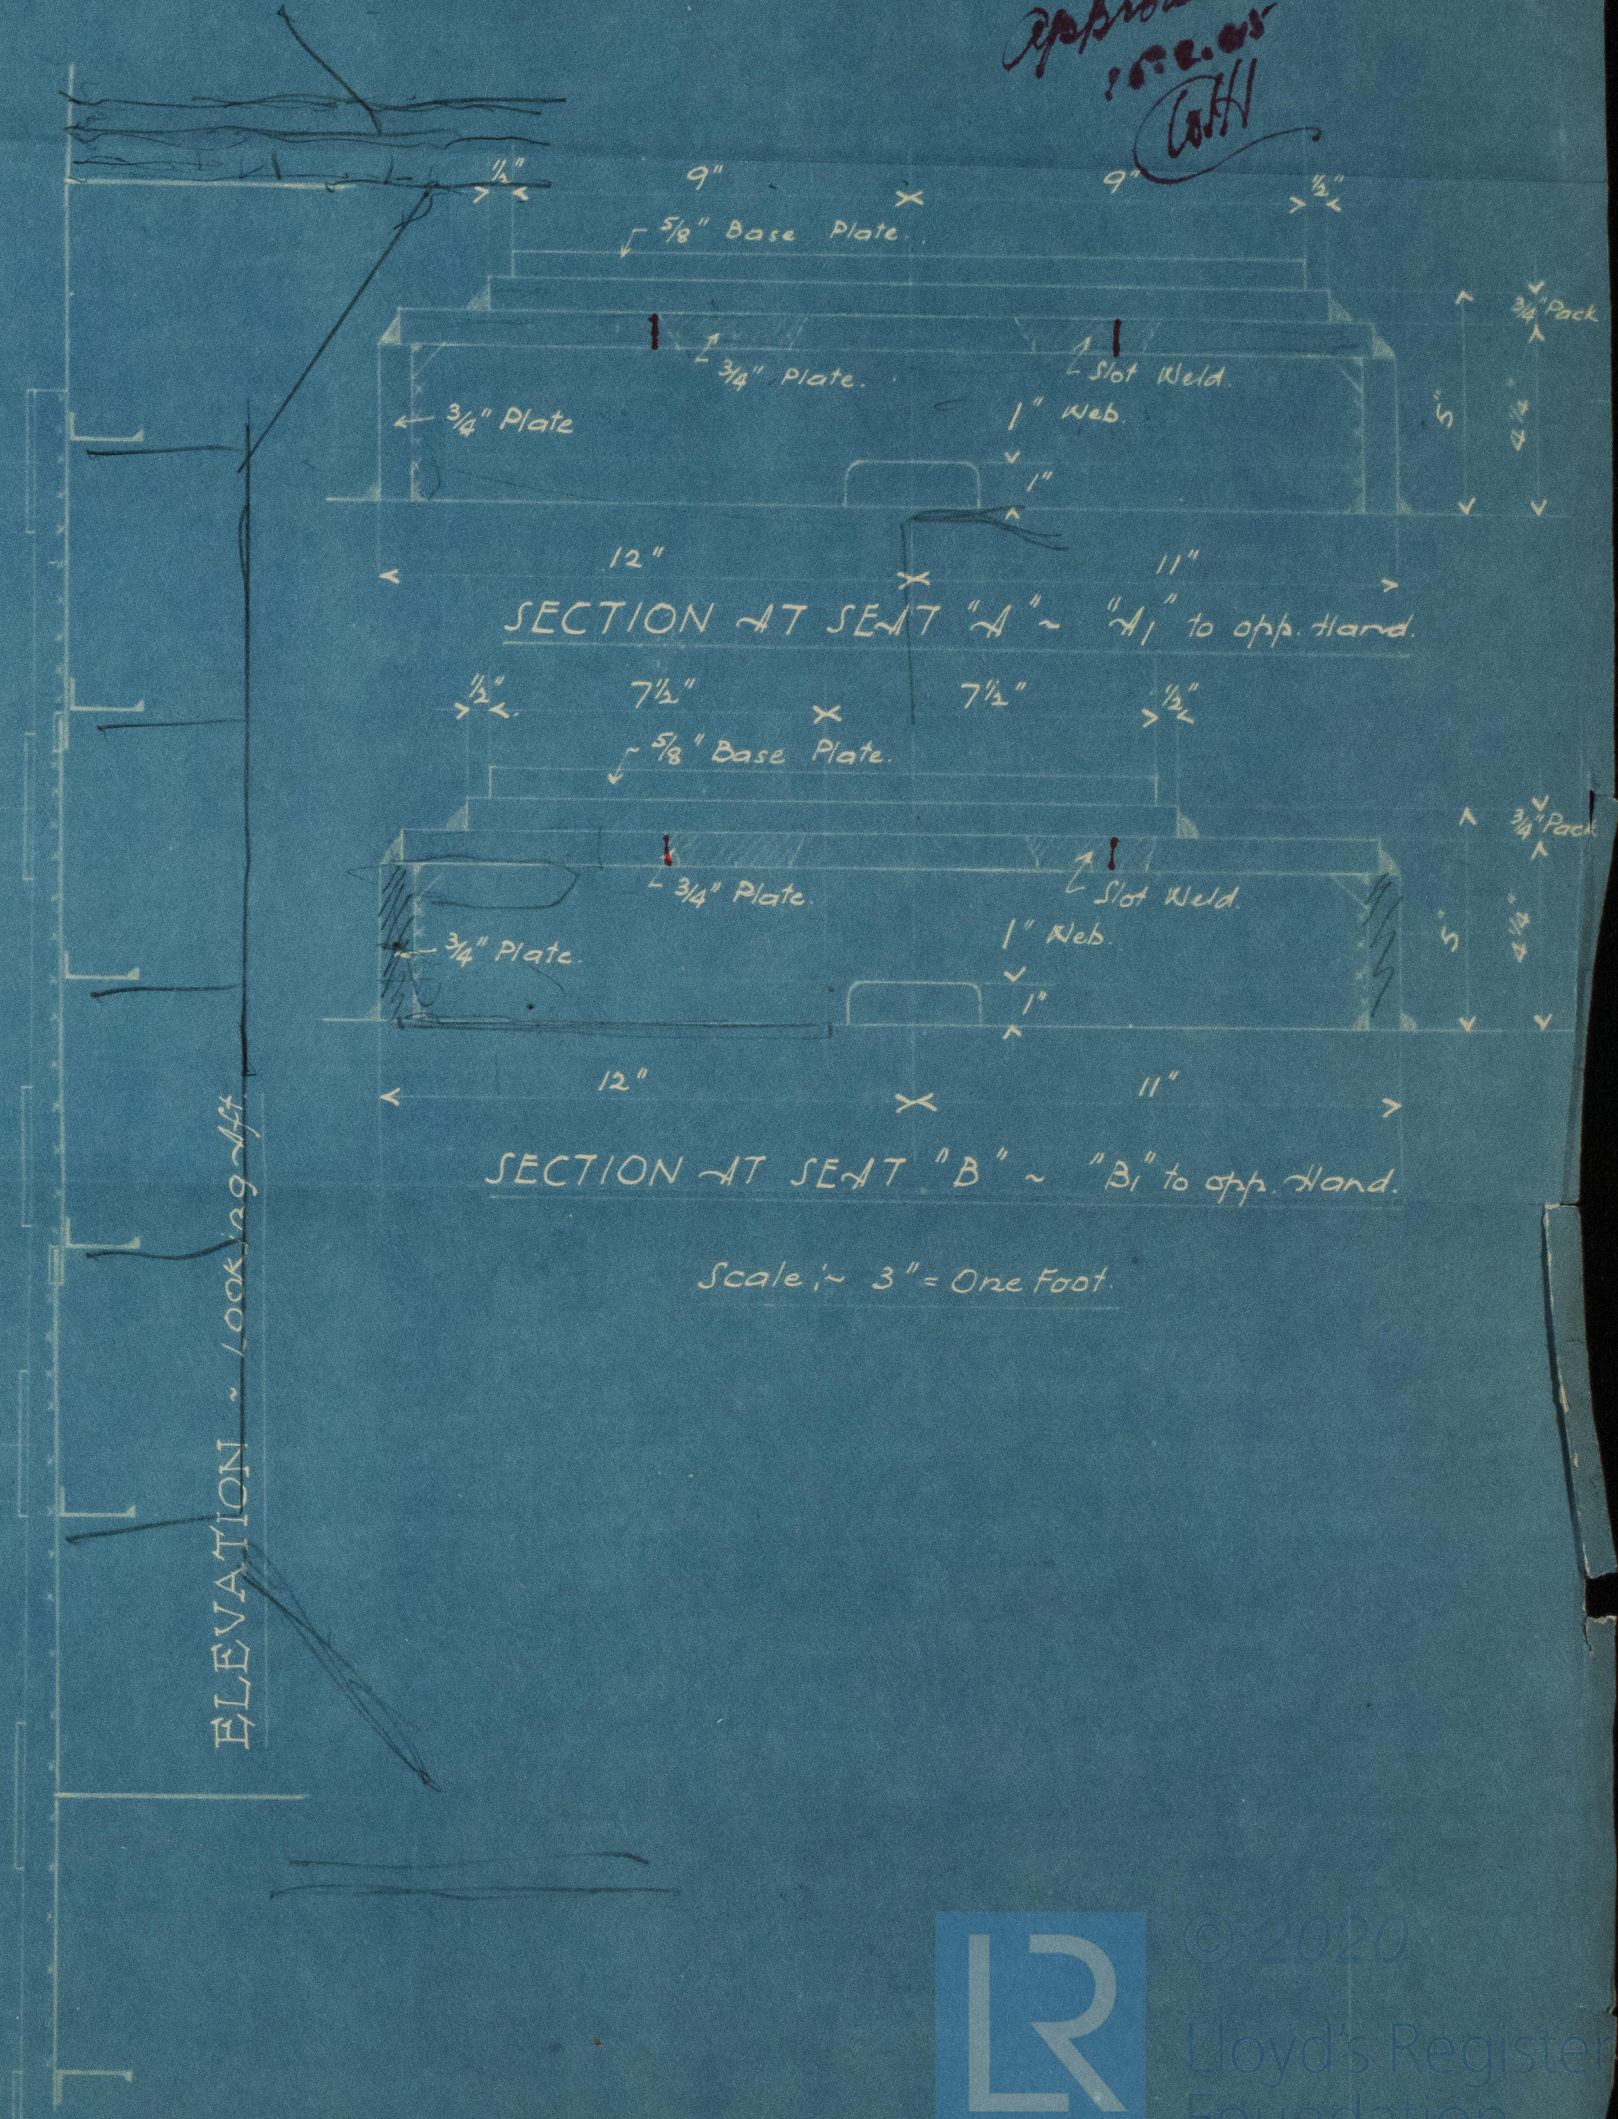

SHIPBUILDING
 Line No. X36103
 Ship Drawing Office
 Date 1-2-45

Dwg. No. T. 7224.



© 2020
 Lloyd's Register
 Foundation

009232 - 009234 - 0105

89.
Seatings for Buyer Get on meat
meal plant

Gurness 287

5 FEB 1945

Southern Venturer

17.2.45

No 287

Gurness & Co

Seatings for Buyer Get on meat meal plant

Rag

009232-009234-0105


89



© 2020

Lloyd's Register
Foundation

009232-009234-0105

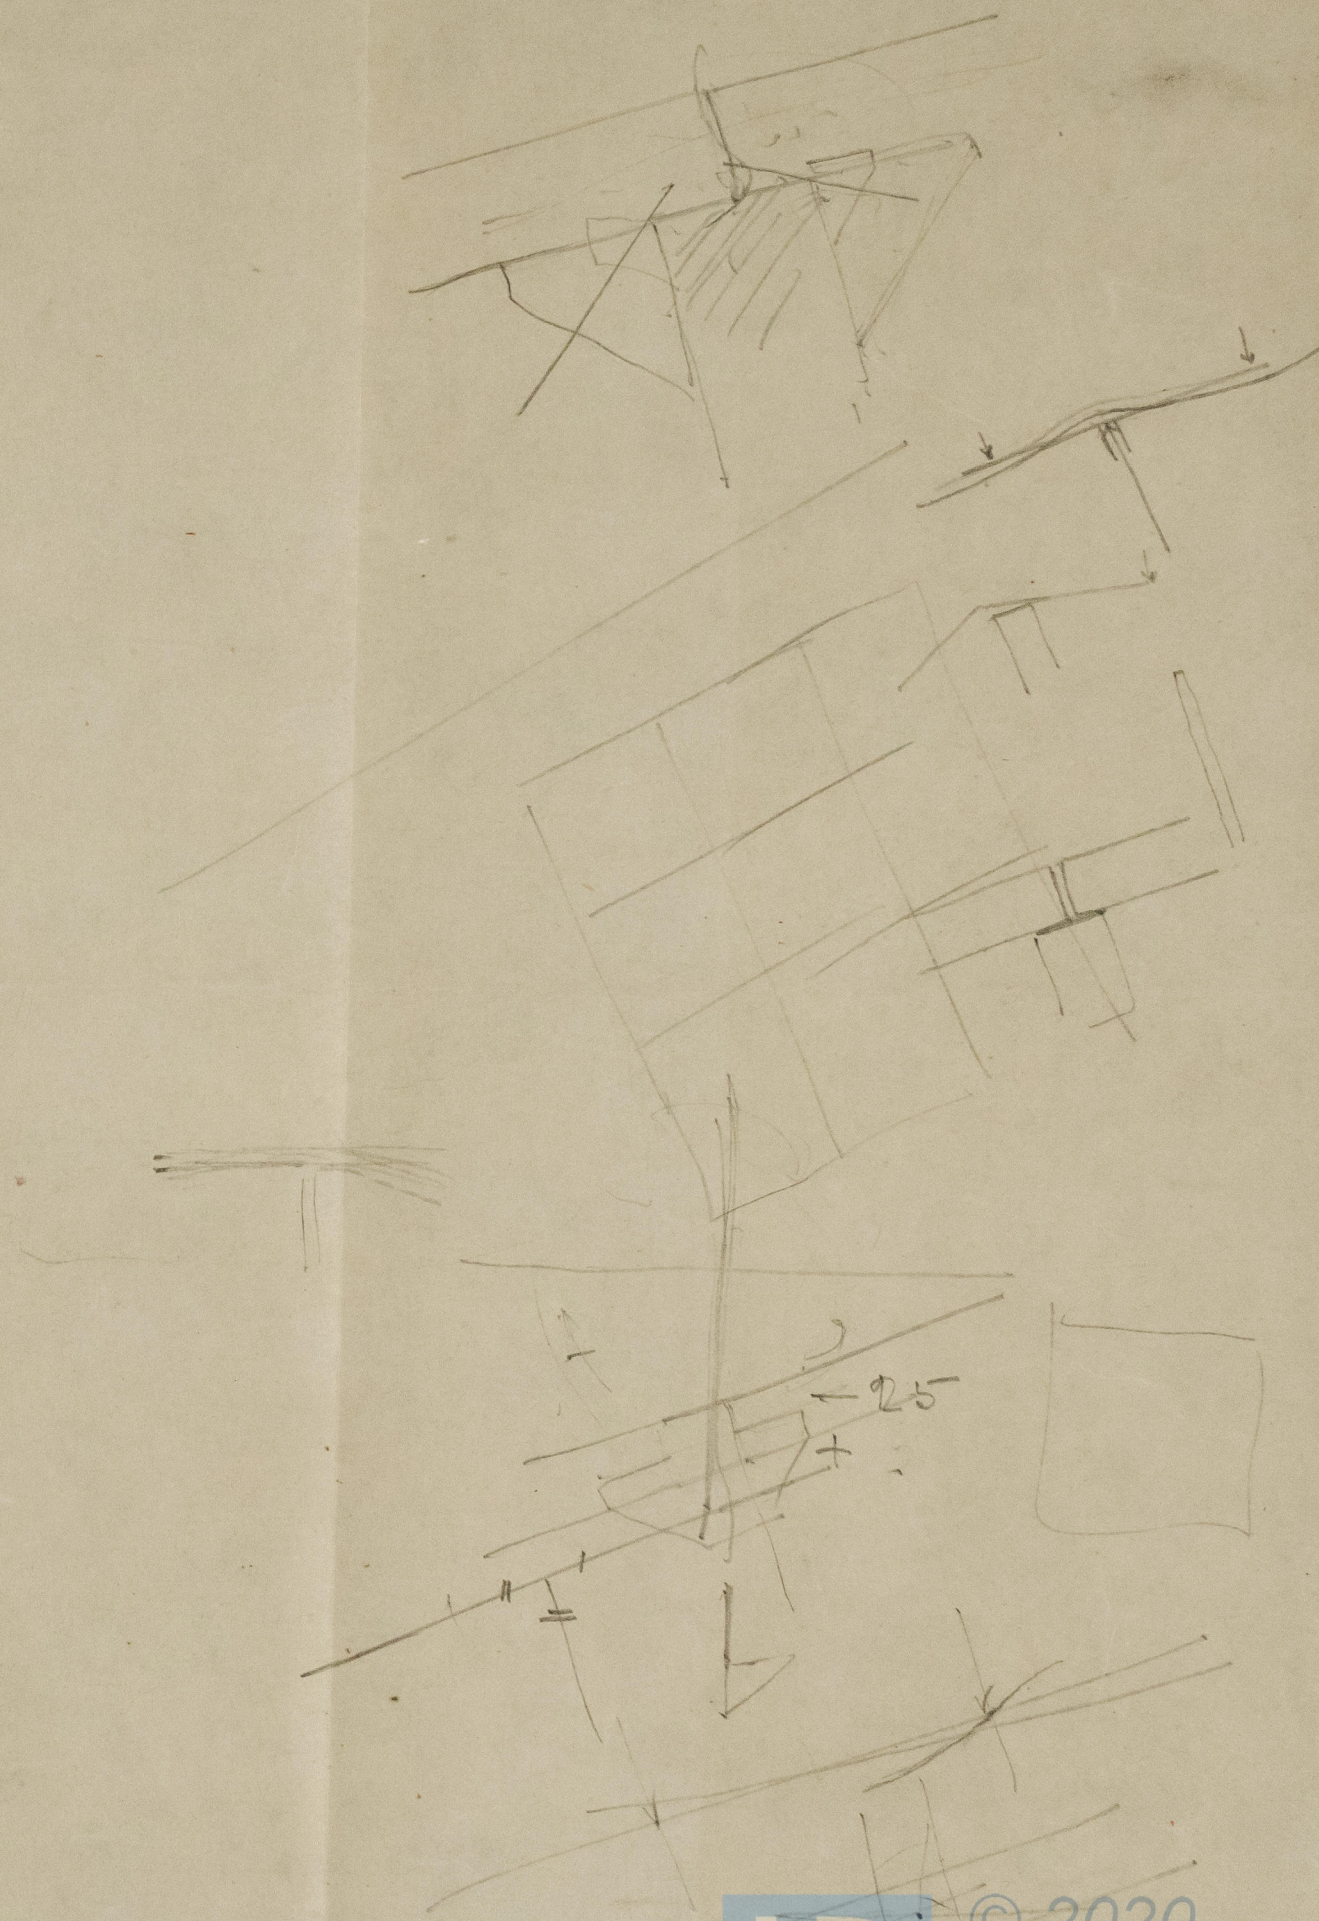

© 2020

Lloyd's Register
Foundation