
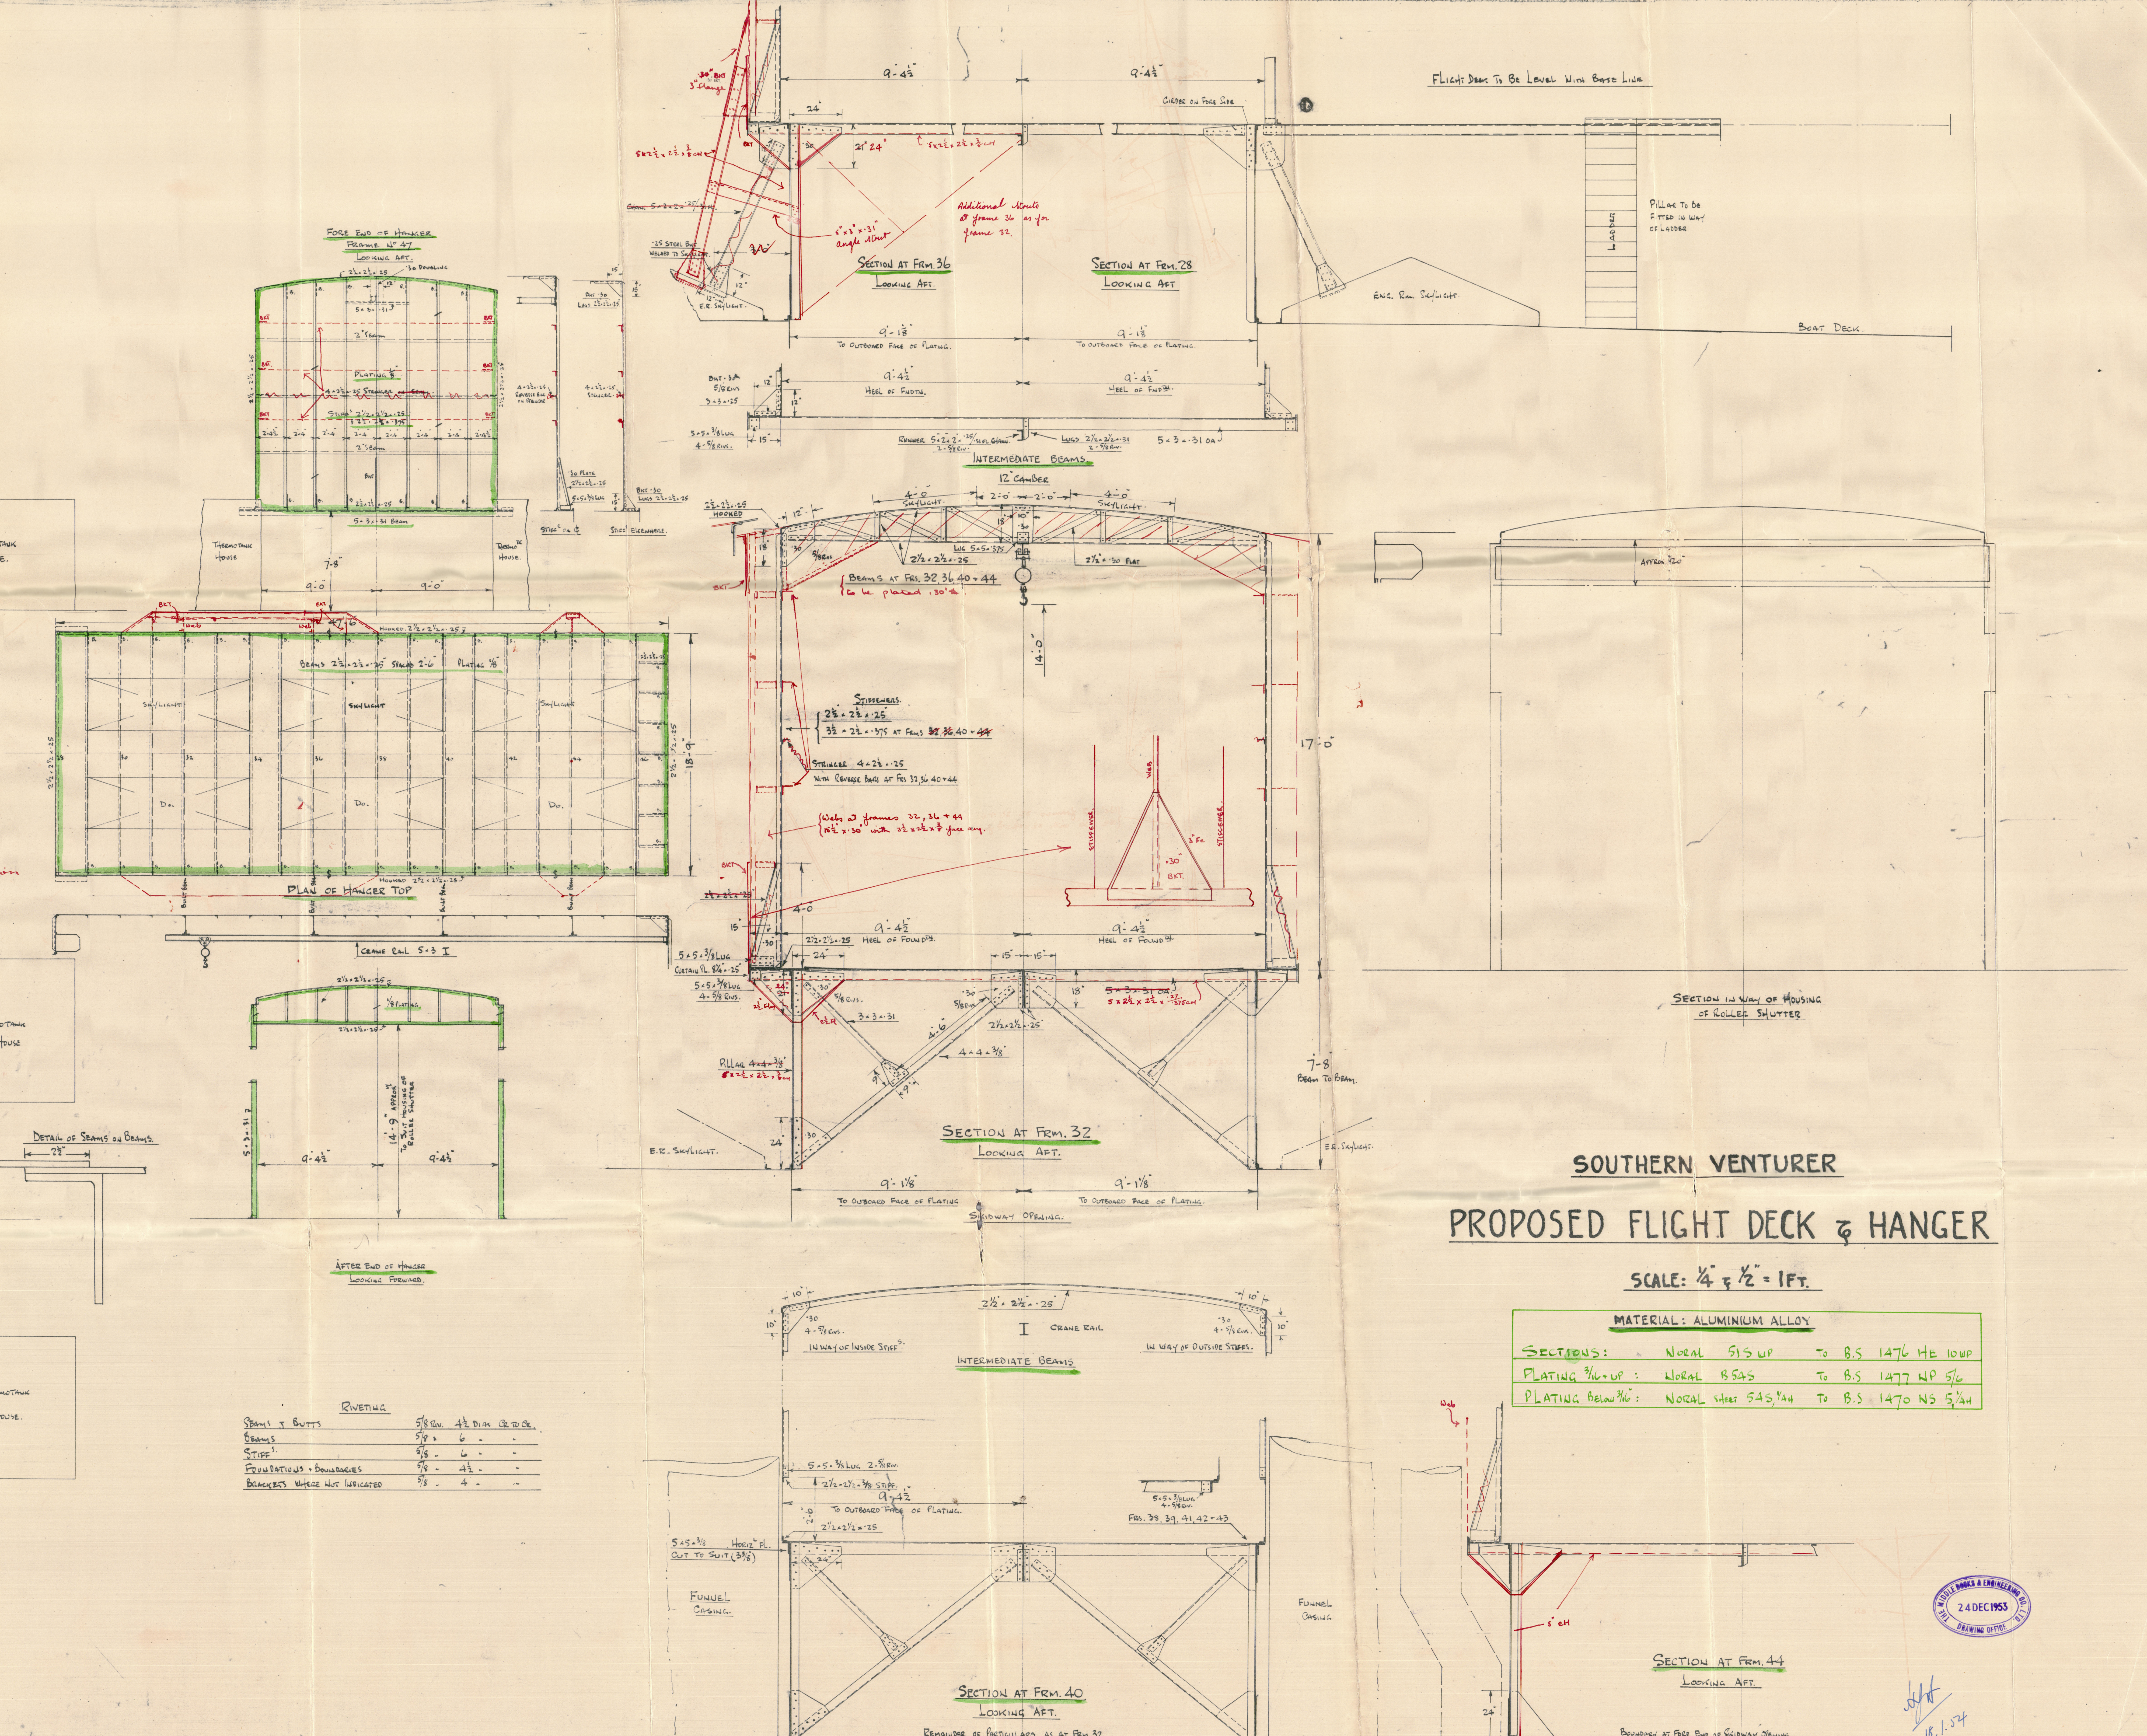


SOUTHERN VENTURER  
PROPOSED FLIGHT DECK AND HANGER  
NEWCASTLE-ON-TYNE, No. 111590

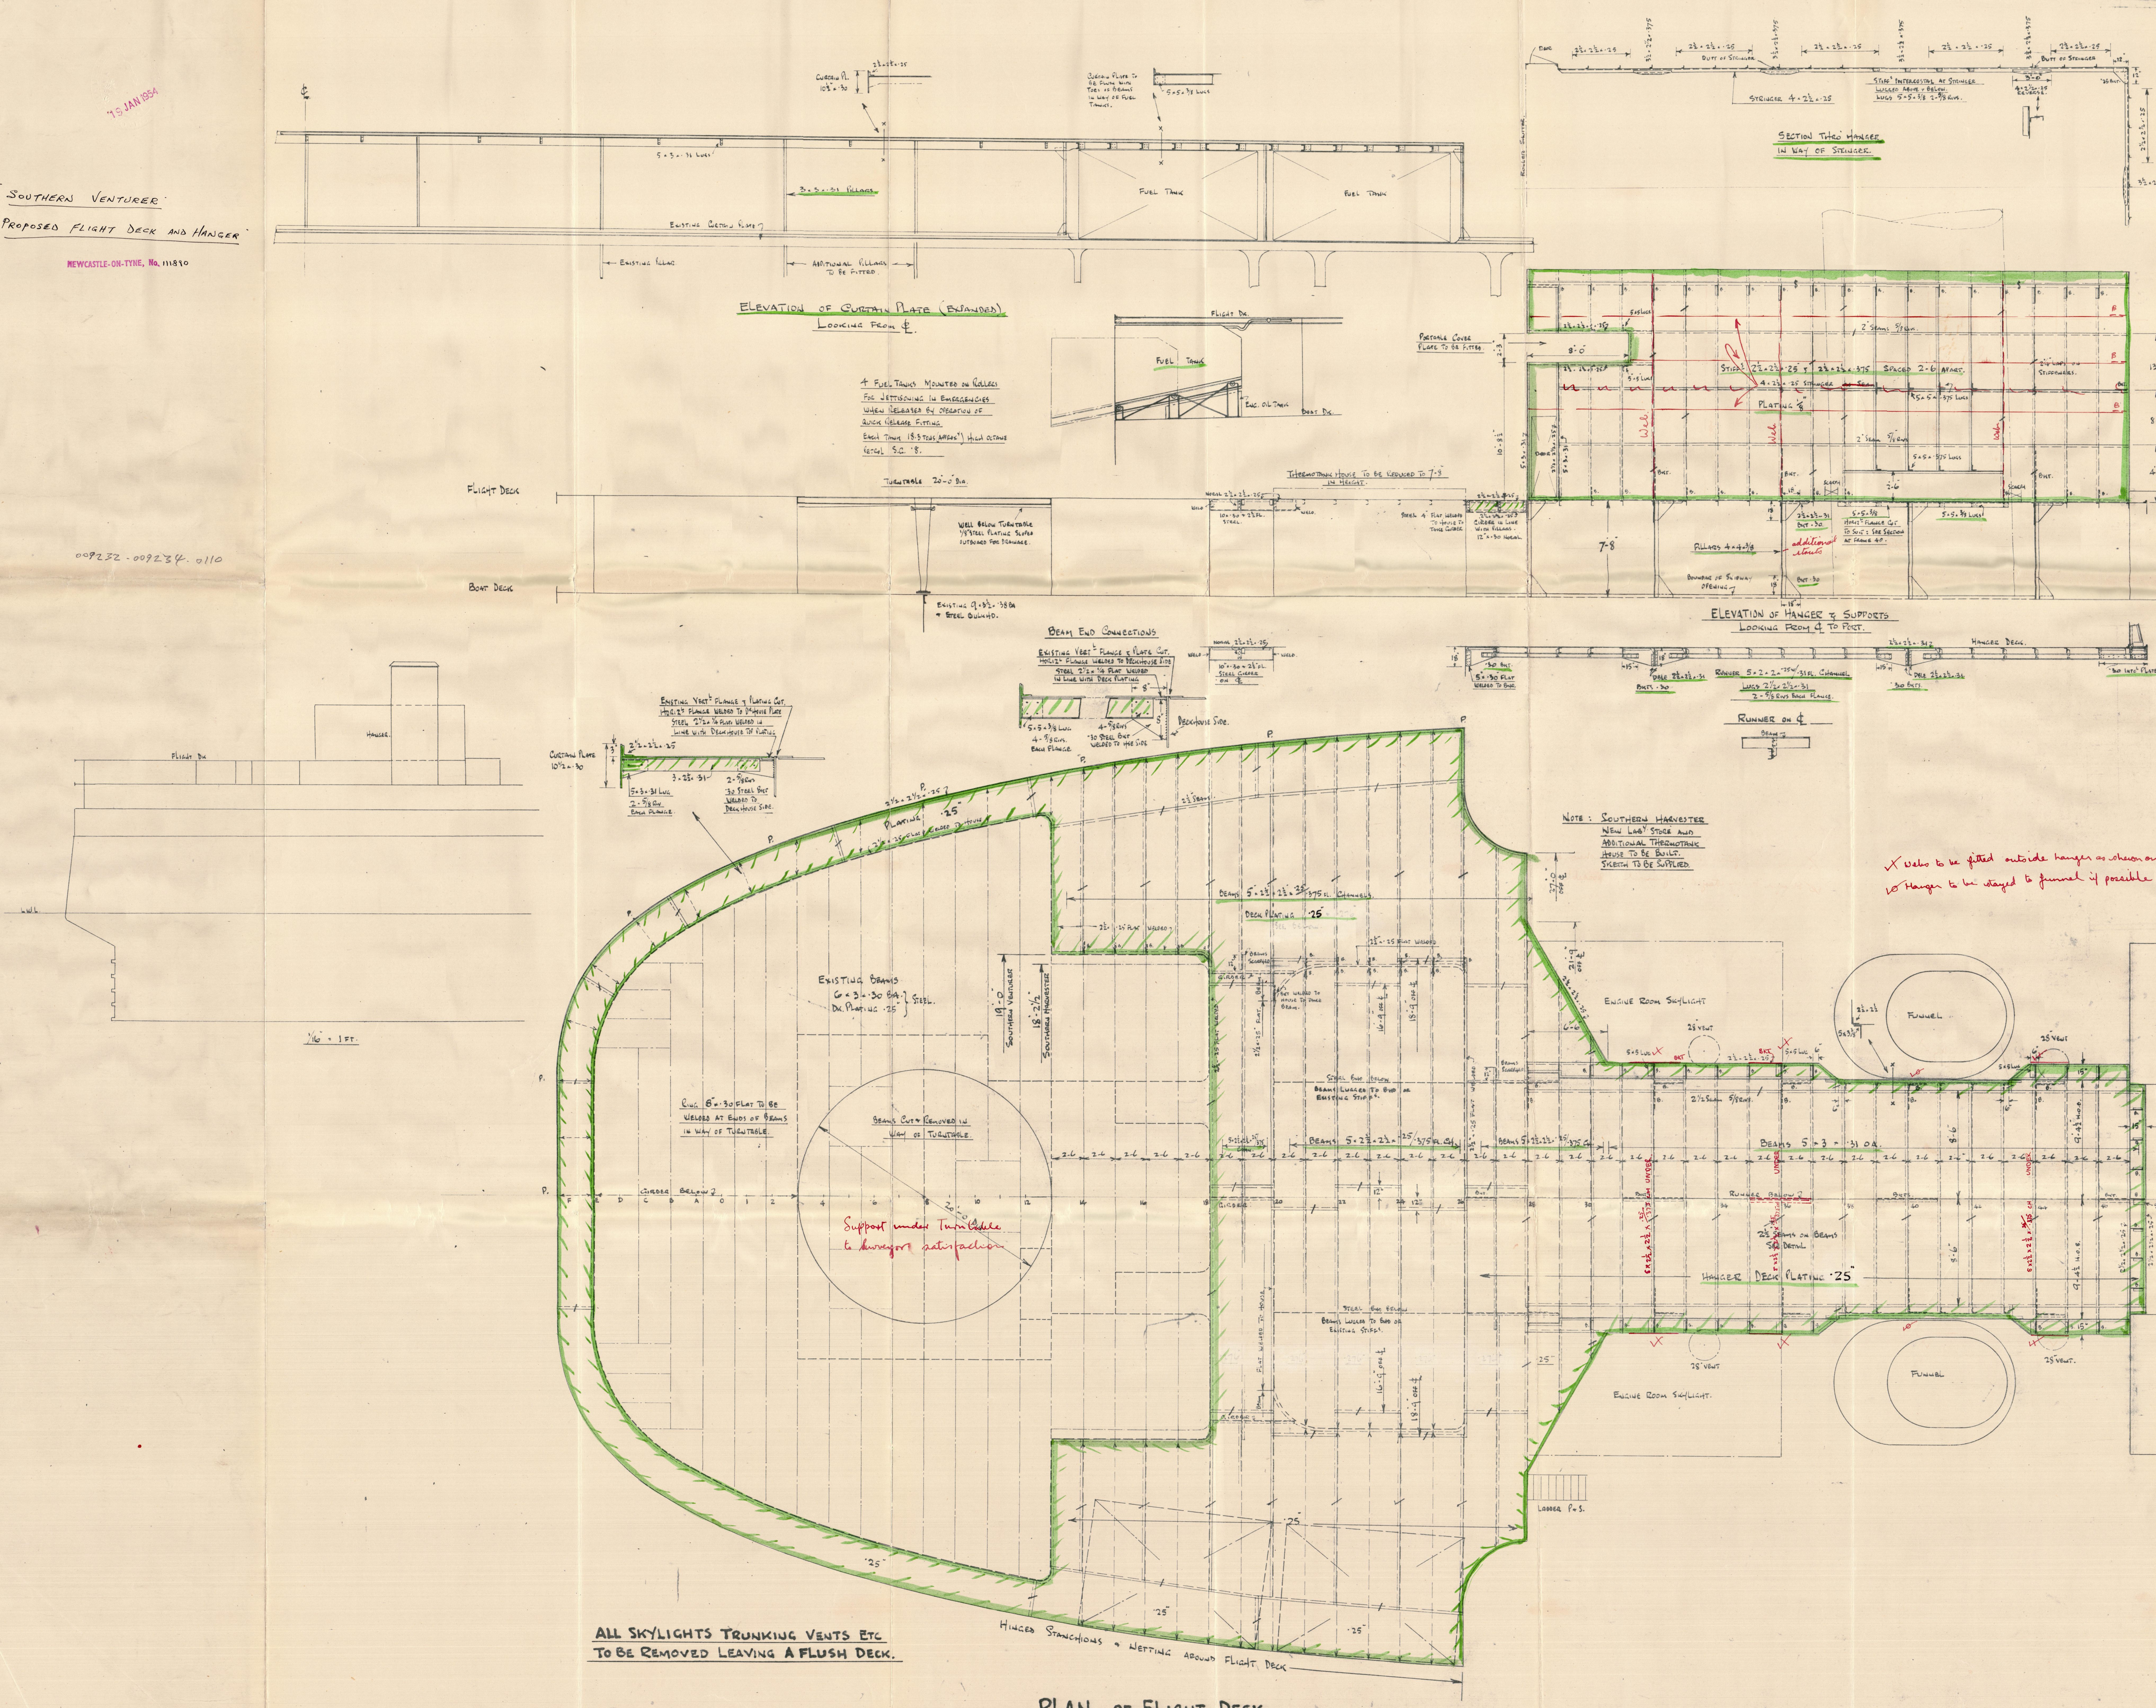









19 JAN 1954

SOUTHERN VENTURER

PROPOSED FLIGHT DECK AND HANGER

NEWCASTLE-ON-TYNE, No. 111890



© 2020

Lloyd's Register  
Foundation

009232 - 009234 - 0110