
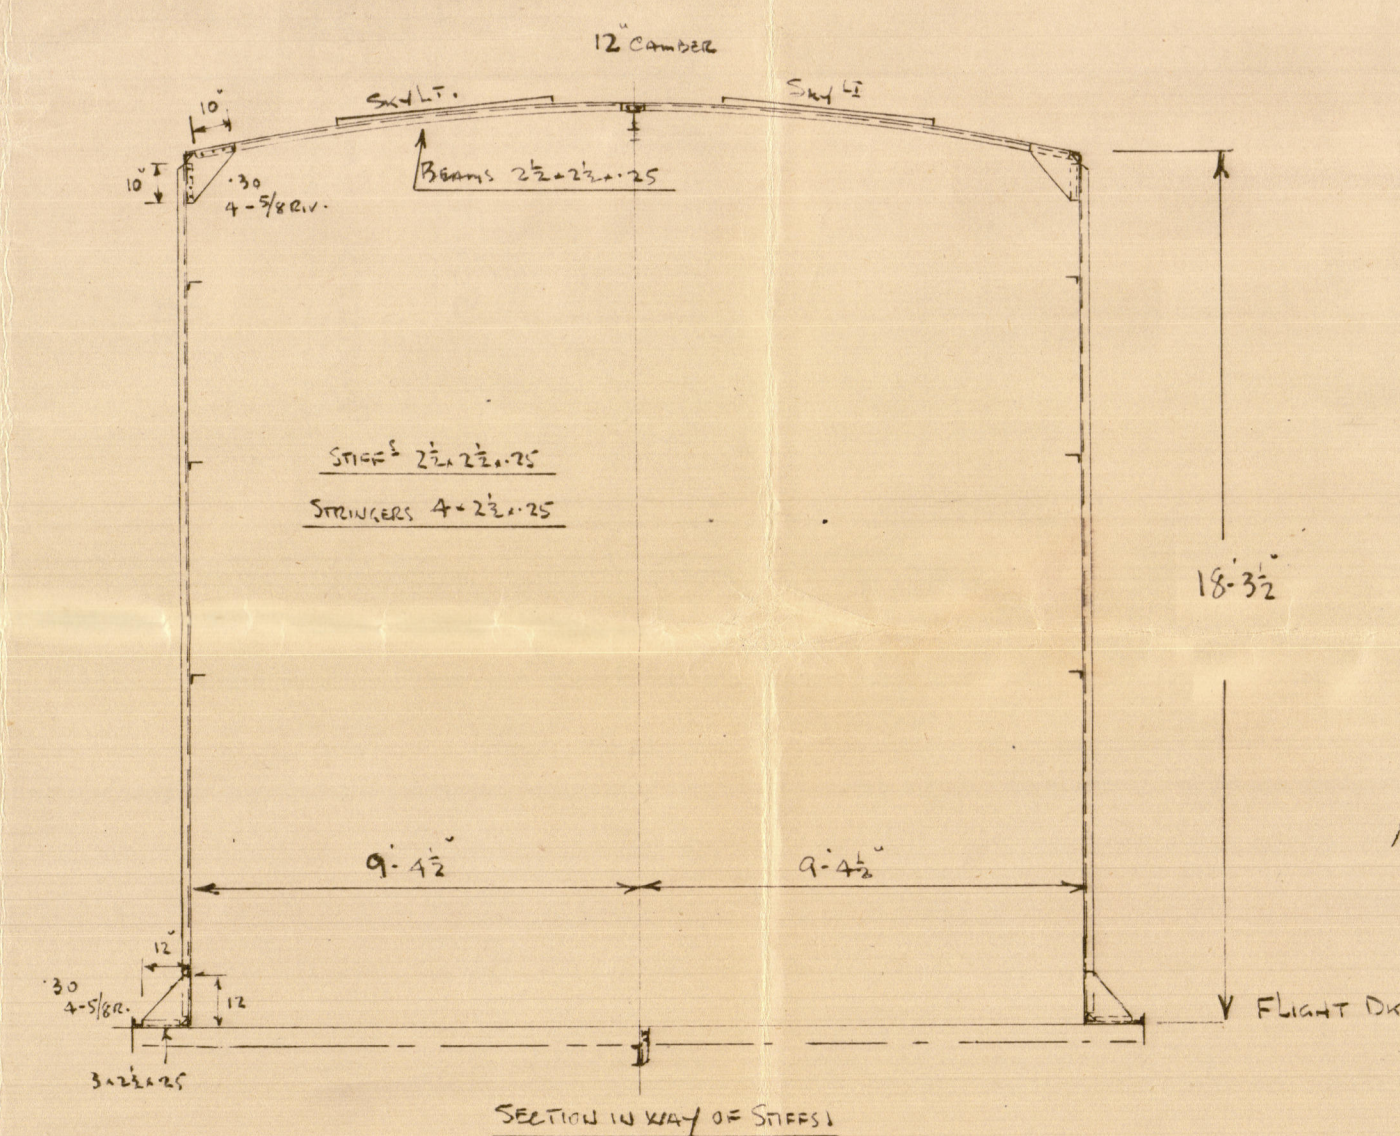
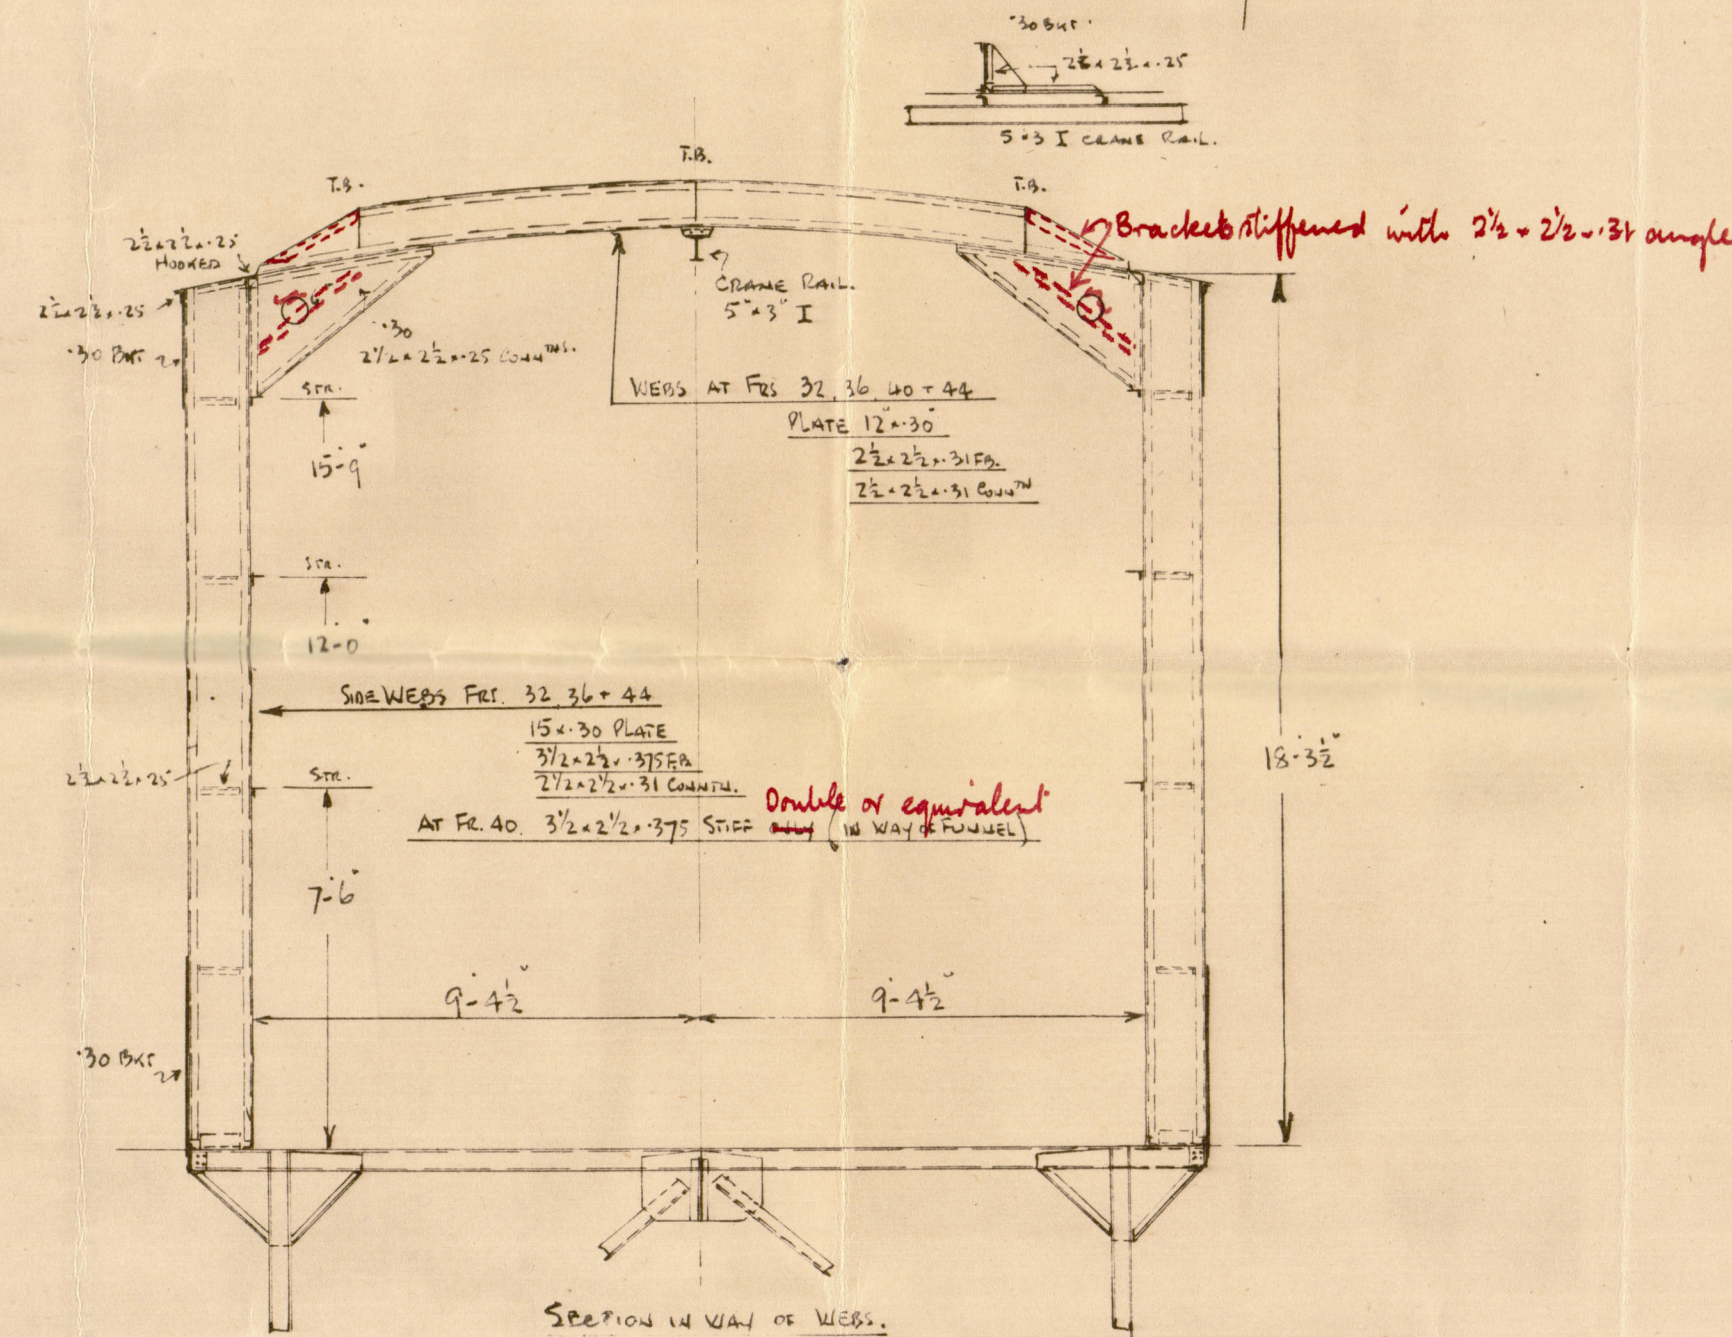


[illegible]

PARTICULARS OF FLIGHT DECK & SUPPORTS ETC AS
PER LLOYDS APPROVED PLANS 19 Jan. 1954.

MATERIAL : ALUMINIUM ALLOY		
SECTIONS :	NORAL	51 S.W. 51 W.P.
		To B.S. 1476 H.E. 10 W.P.
PLATING	$\frac{3}{16}$ - UP NORAL	B545
		To B.S. 1477 N.P. 5/6
	Below $\frac{3}{16}$ - STEEL	S45
		To B.S. 1470 U.S. 5/4 H.
ENDS	NORAL	A563
		To B.S. 1473 N.R. 6.

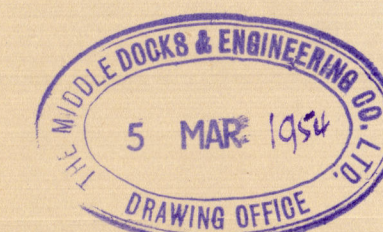

15.3.54

SOUTHERN VENTURER

PROPOSED AMENDMENTS TO HANGER

NEWCASTLE-ON-TYNE, No. 111890



© 2020

Lloyd's Register
Foundation

009232 - 009234 - 0111