

# MIDSHIP SECTION.

— Nos 493-4. —


STEEL SCREW TRAWLER

DIMS 140'-0" x 24'-0" EX. x 13'-6" MOULDED.

SCALE 1/2 = ONE FOOT.

PLAN No. 58  
FOR ENCLOSURE TO  
Messrs Lloyd's Surveyors  
Hull FROM  
COCHRANE & SONS.  
SHIPBUILDERS, SEB.  
DATE 2/3/11 RK

7.3.11

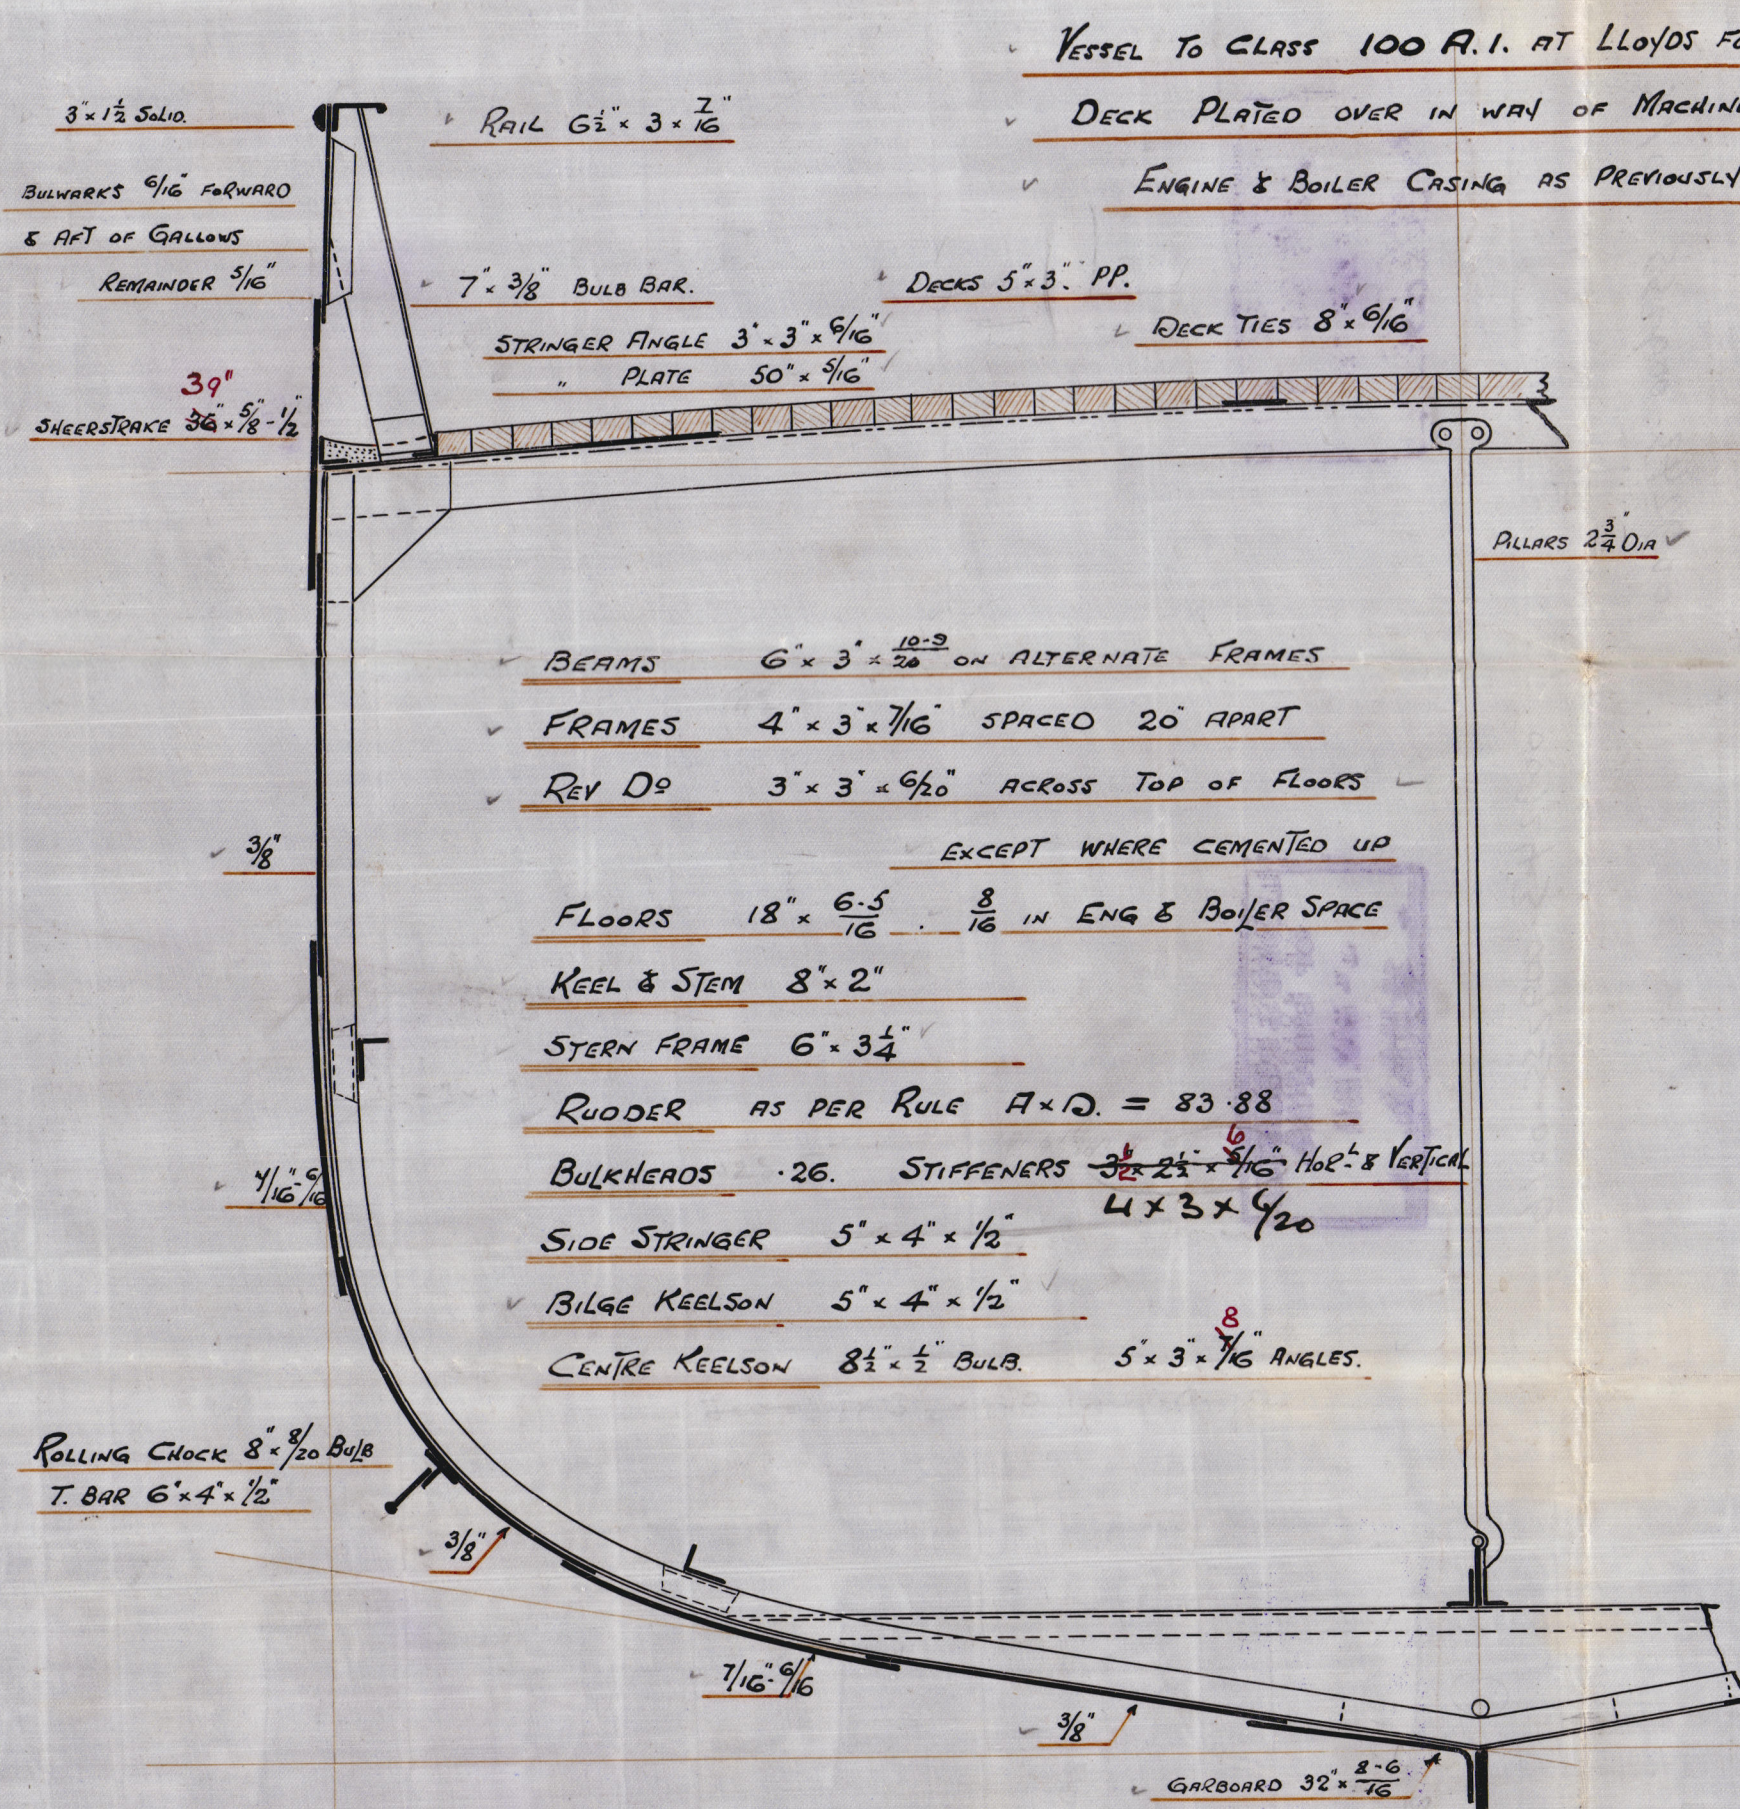

## NUMERALS

$$B + D = 37.375$$

$$L \times (B + D) = 5232$$

$$\text{EQUIPMENT NO} = 5232$$

## PROPORTIONS

$$\frac{D}{L} = 10.37$$

$$\frac{B}{L} = 5.86$$

## EQUIPMENT

1 <sup>ST</sup> BOWER ANCHOR	8 CWTs	STOCKLESS.
2 <sup>ND</sup> "	7 1/4	" "
KEDGE	3 1/4	EX STOCK.
120 FATHOMS	1 1/2	CABLE.
60 "	6"	HAWSER.
60 "	5"	WARP.

## RIVETING

- BUTTS OF SHELL PLATING TO BE LAPPED & DOUBLE RIVETED FOR 1/2 LENGTH
- EXCEPT GARBOARD & SHEERSTRAKE. GARBOARD STRAKE TO BE STRAPPED & DOUBLE RIVETED. 1/2 SHEERSTRAKE STRAPPED & TREBLE RIVETED FOR 1/2 L. AMIDSHIPS. ENDS DOUBLE RIVETED.
- ALL LANDINGS DOUBLE RIVETED. BULWARKS SINGLE RIVETED.

C.B.  
7.3.11.



Cochrane & Sons

N<sup>o</sup>: 493 - 494

Midship Section.

$\frac{2}{10}$  Blake-dony Hull Report No


EQUIPMENT No 2535.

$1 \times (B + D) = 2535.$

$B + D = 2535.$

UNIVERSITY

© 2021

Lloyd's Register  
Foundation

00 9243 009255 0016



22  
 Improved double beam  
 short  
 11 1/2 ft

MONITOR

NO 423

STEEL

FORWARD

5 1/2 x 100

3

1 1/2

1st Keelson 2 x 4 x 1/2  



Lloyd's Register  
 Foundation  
 009243-009255-0016