

CLASS + 100A 1 BARGE "NON SELF PROPELLING"  
 "CARRYING PETROLEUM IN BULK IN Nos 1 & 2 TANKS  
 AND HEAVY OIL FLASH POINT ABOVE 150°F IN No 3 TANK"  
 "STRENGTHENED FOR NAVIGATION IN ICE"

S.Nos 250-2

U. S. S. R. OIL BARGE


# MIDSHIP SECTION (FINISHED)

SCALE 1/2" TO 1'-0"

Nagasaki report No. 2224



" " No. 2225

" " No. 2226

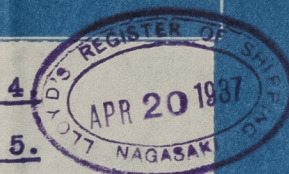

PRINCIPAL DIMENSIONS		
LENGTH	B.P.	110'-0"
BREADTH	M.L.D.	27'-0"
DEPTH	M.L.D.	11'-0"

SCANTLING NUMERALS	
L x D =	1,210.00
L x (B + D) =	4,180.00
L/D =	10.00

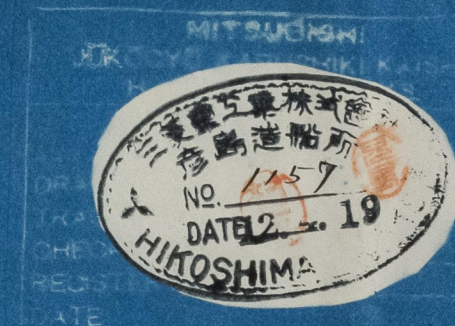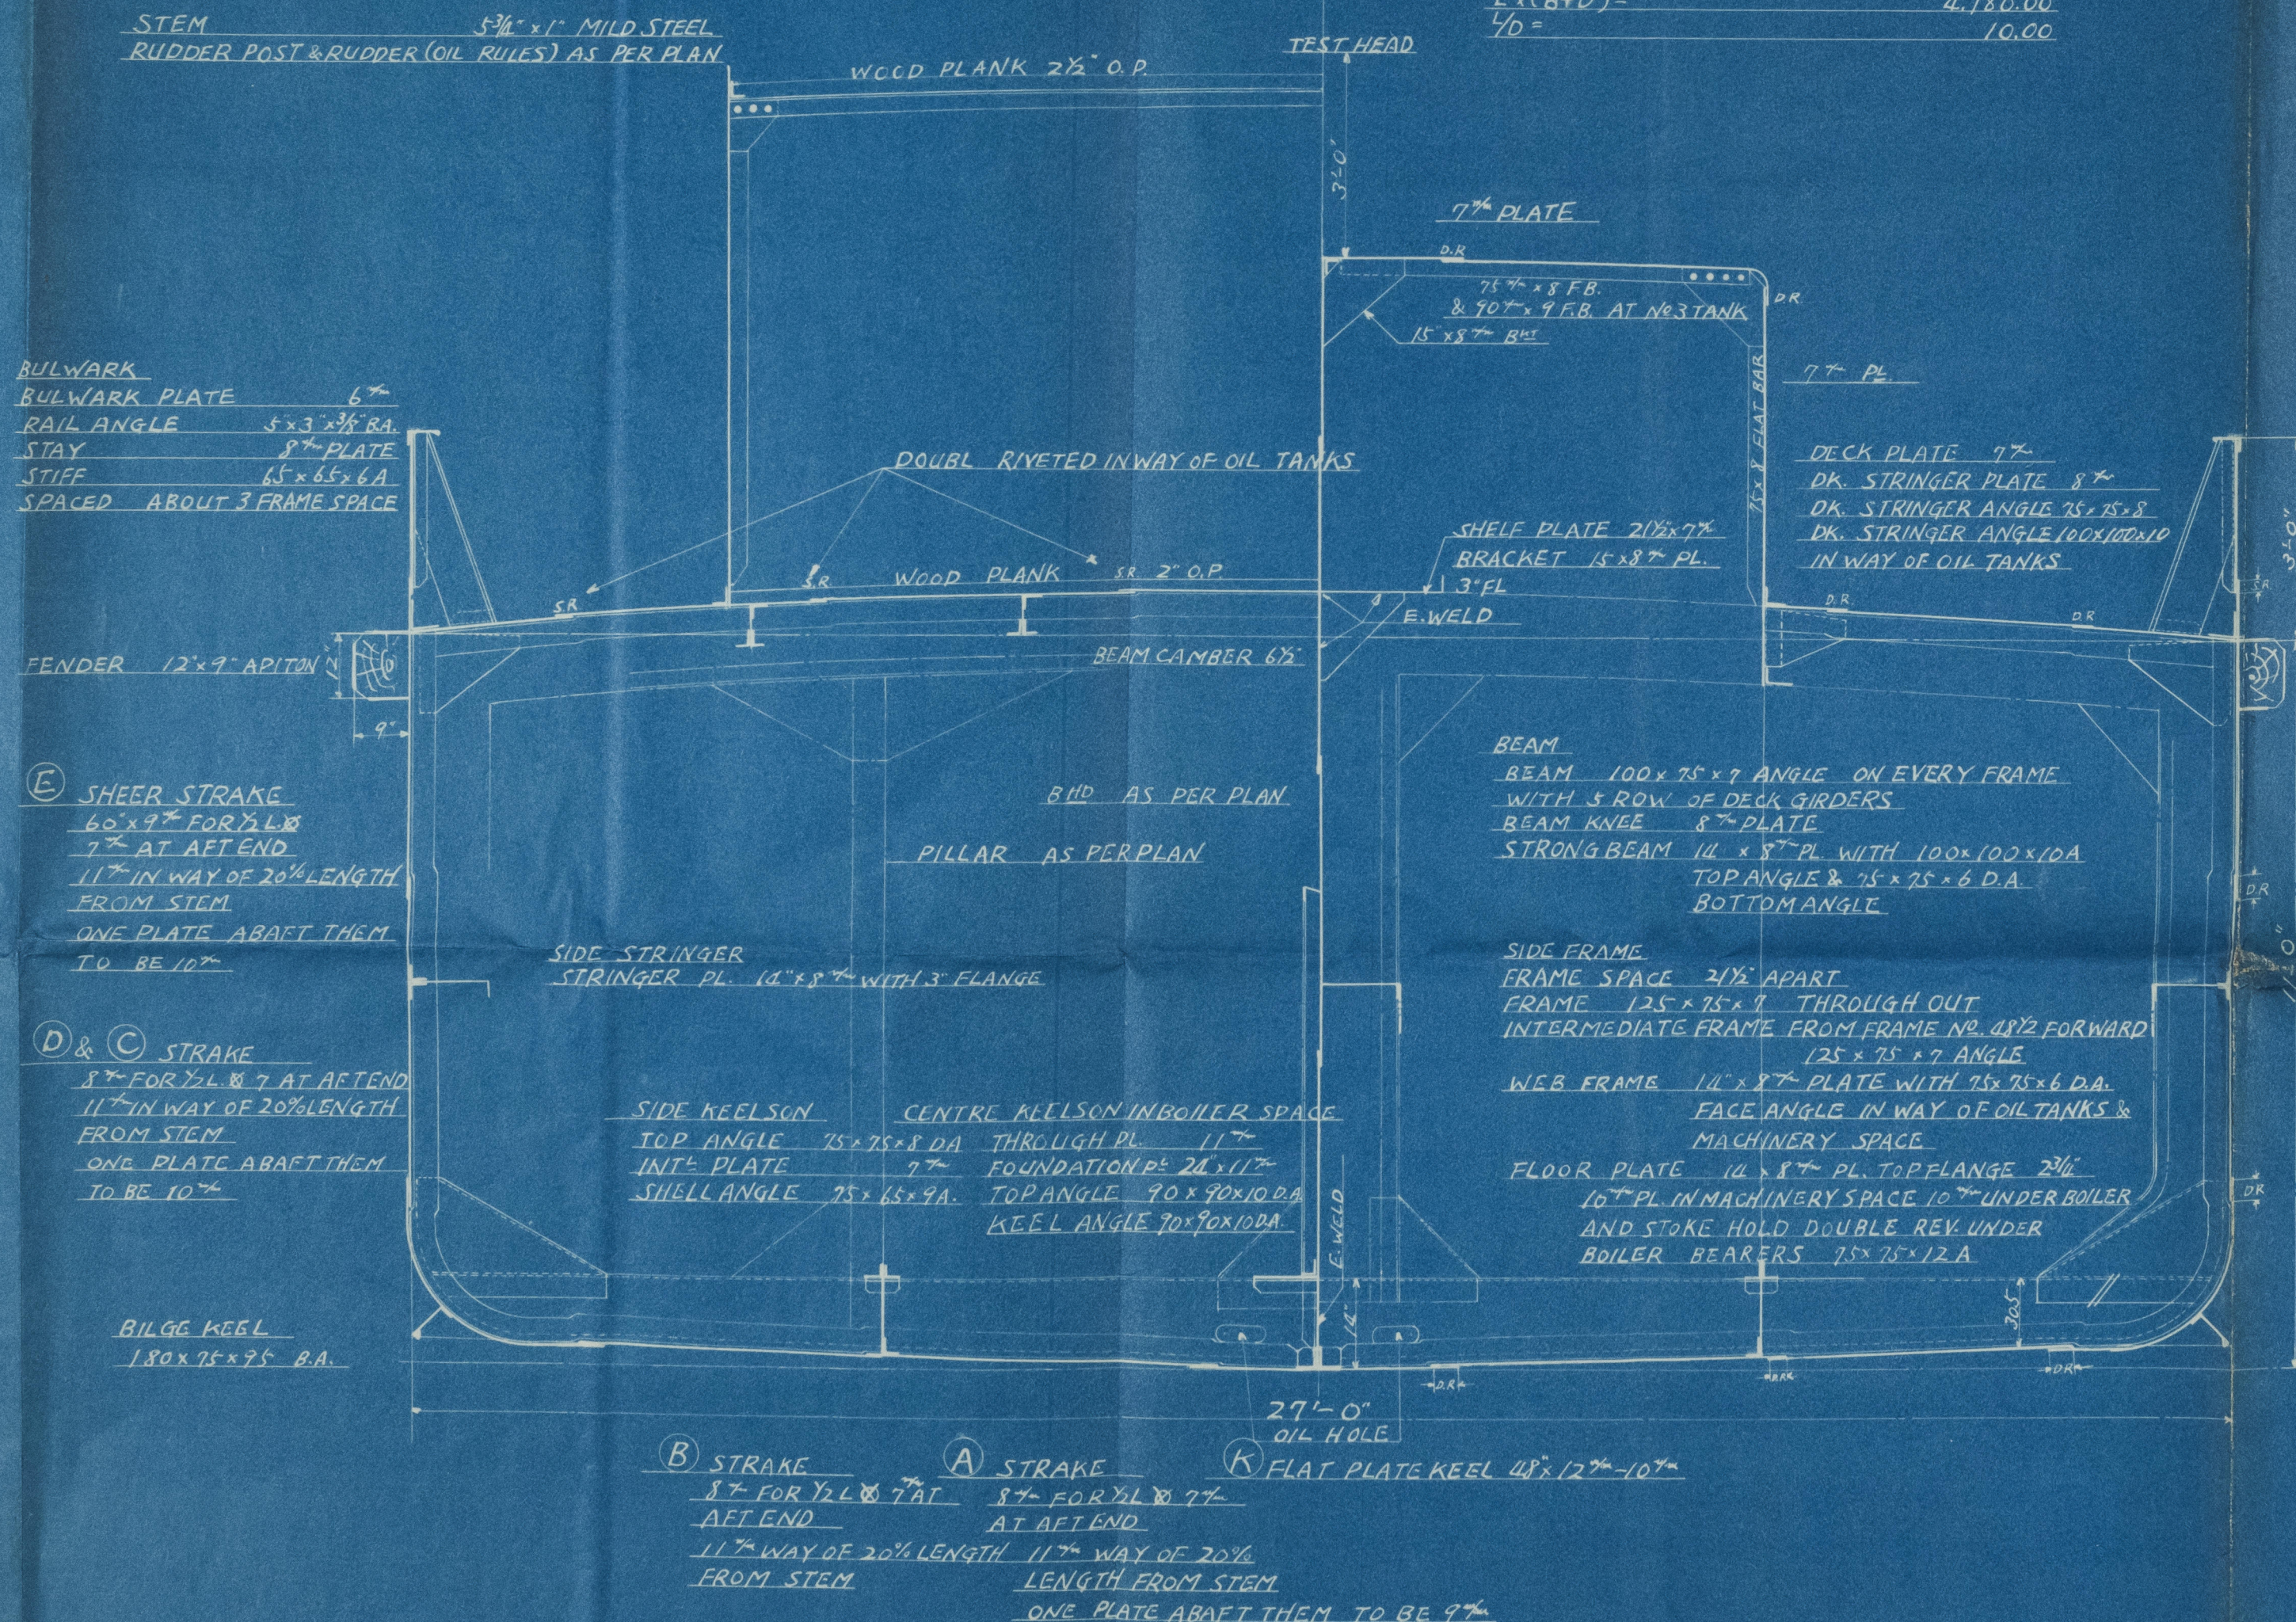

009256-009266-0101



Bingo  
No 1  
No 2  
No 3

209256 - 009266 - 0101



© 2020

Lloyd's Register  
Foundation