



COOK, WELTON & GEMMELL, LTD
SHIPBUILDERS
BEVERLEY

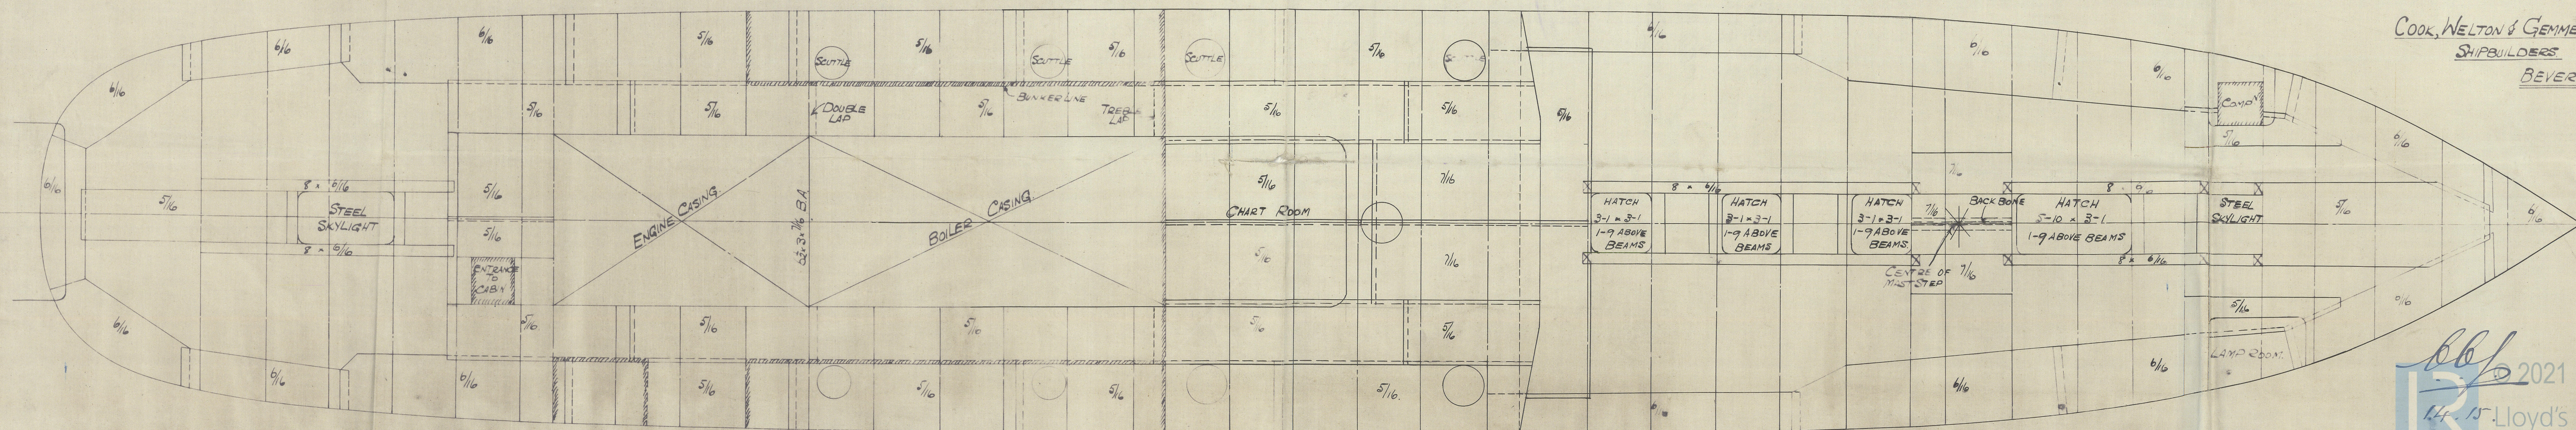

N^o 341. 2-3.

PROFILE + DECK

COOK WELTON + GEMMELL

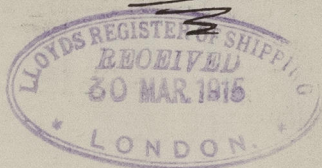

S. Sapageria - Hull Rpn
No 29617. *

S. Rugby - Hull Rpn No 29669.

S. Gambri - Hull Rpn No 29903.



© 2021

Lloyd's Register
Foundation

009278-009286-0002