


009278-009286-0003



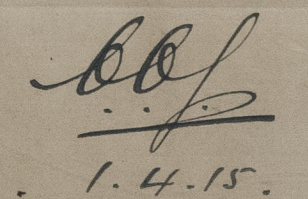

N<sup>o</sup> 341-2-3

Rudder + Stern Frame

Cook Welton + Gemmell



S. "Sapagena" Hull Rpt. No

29614 \*

S. "Rugby" Hull Rpt. No. 29669

S. "Gambri" Hull Rpt. No. 29903.



© 2021

Lloyd's Register  
Foundation

009278-009286-003