
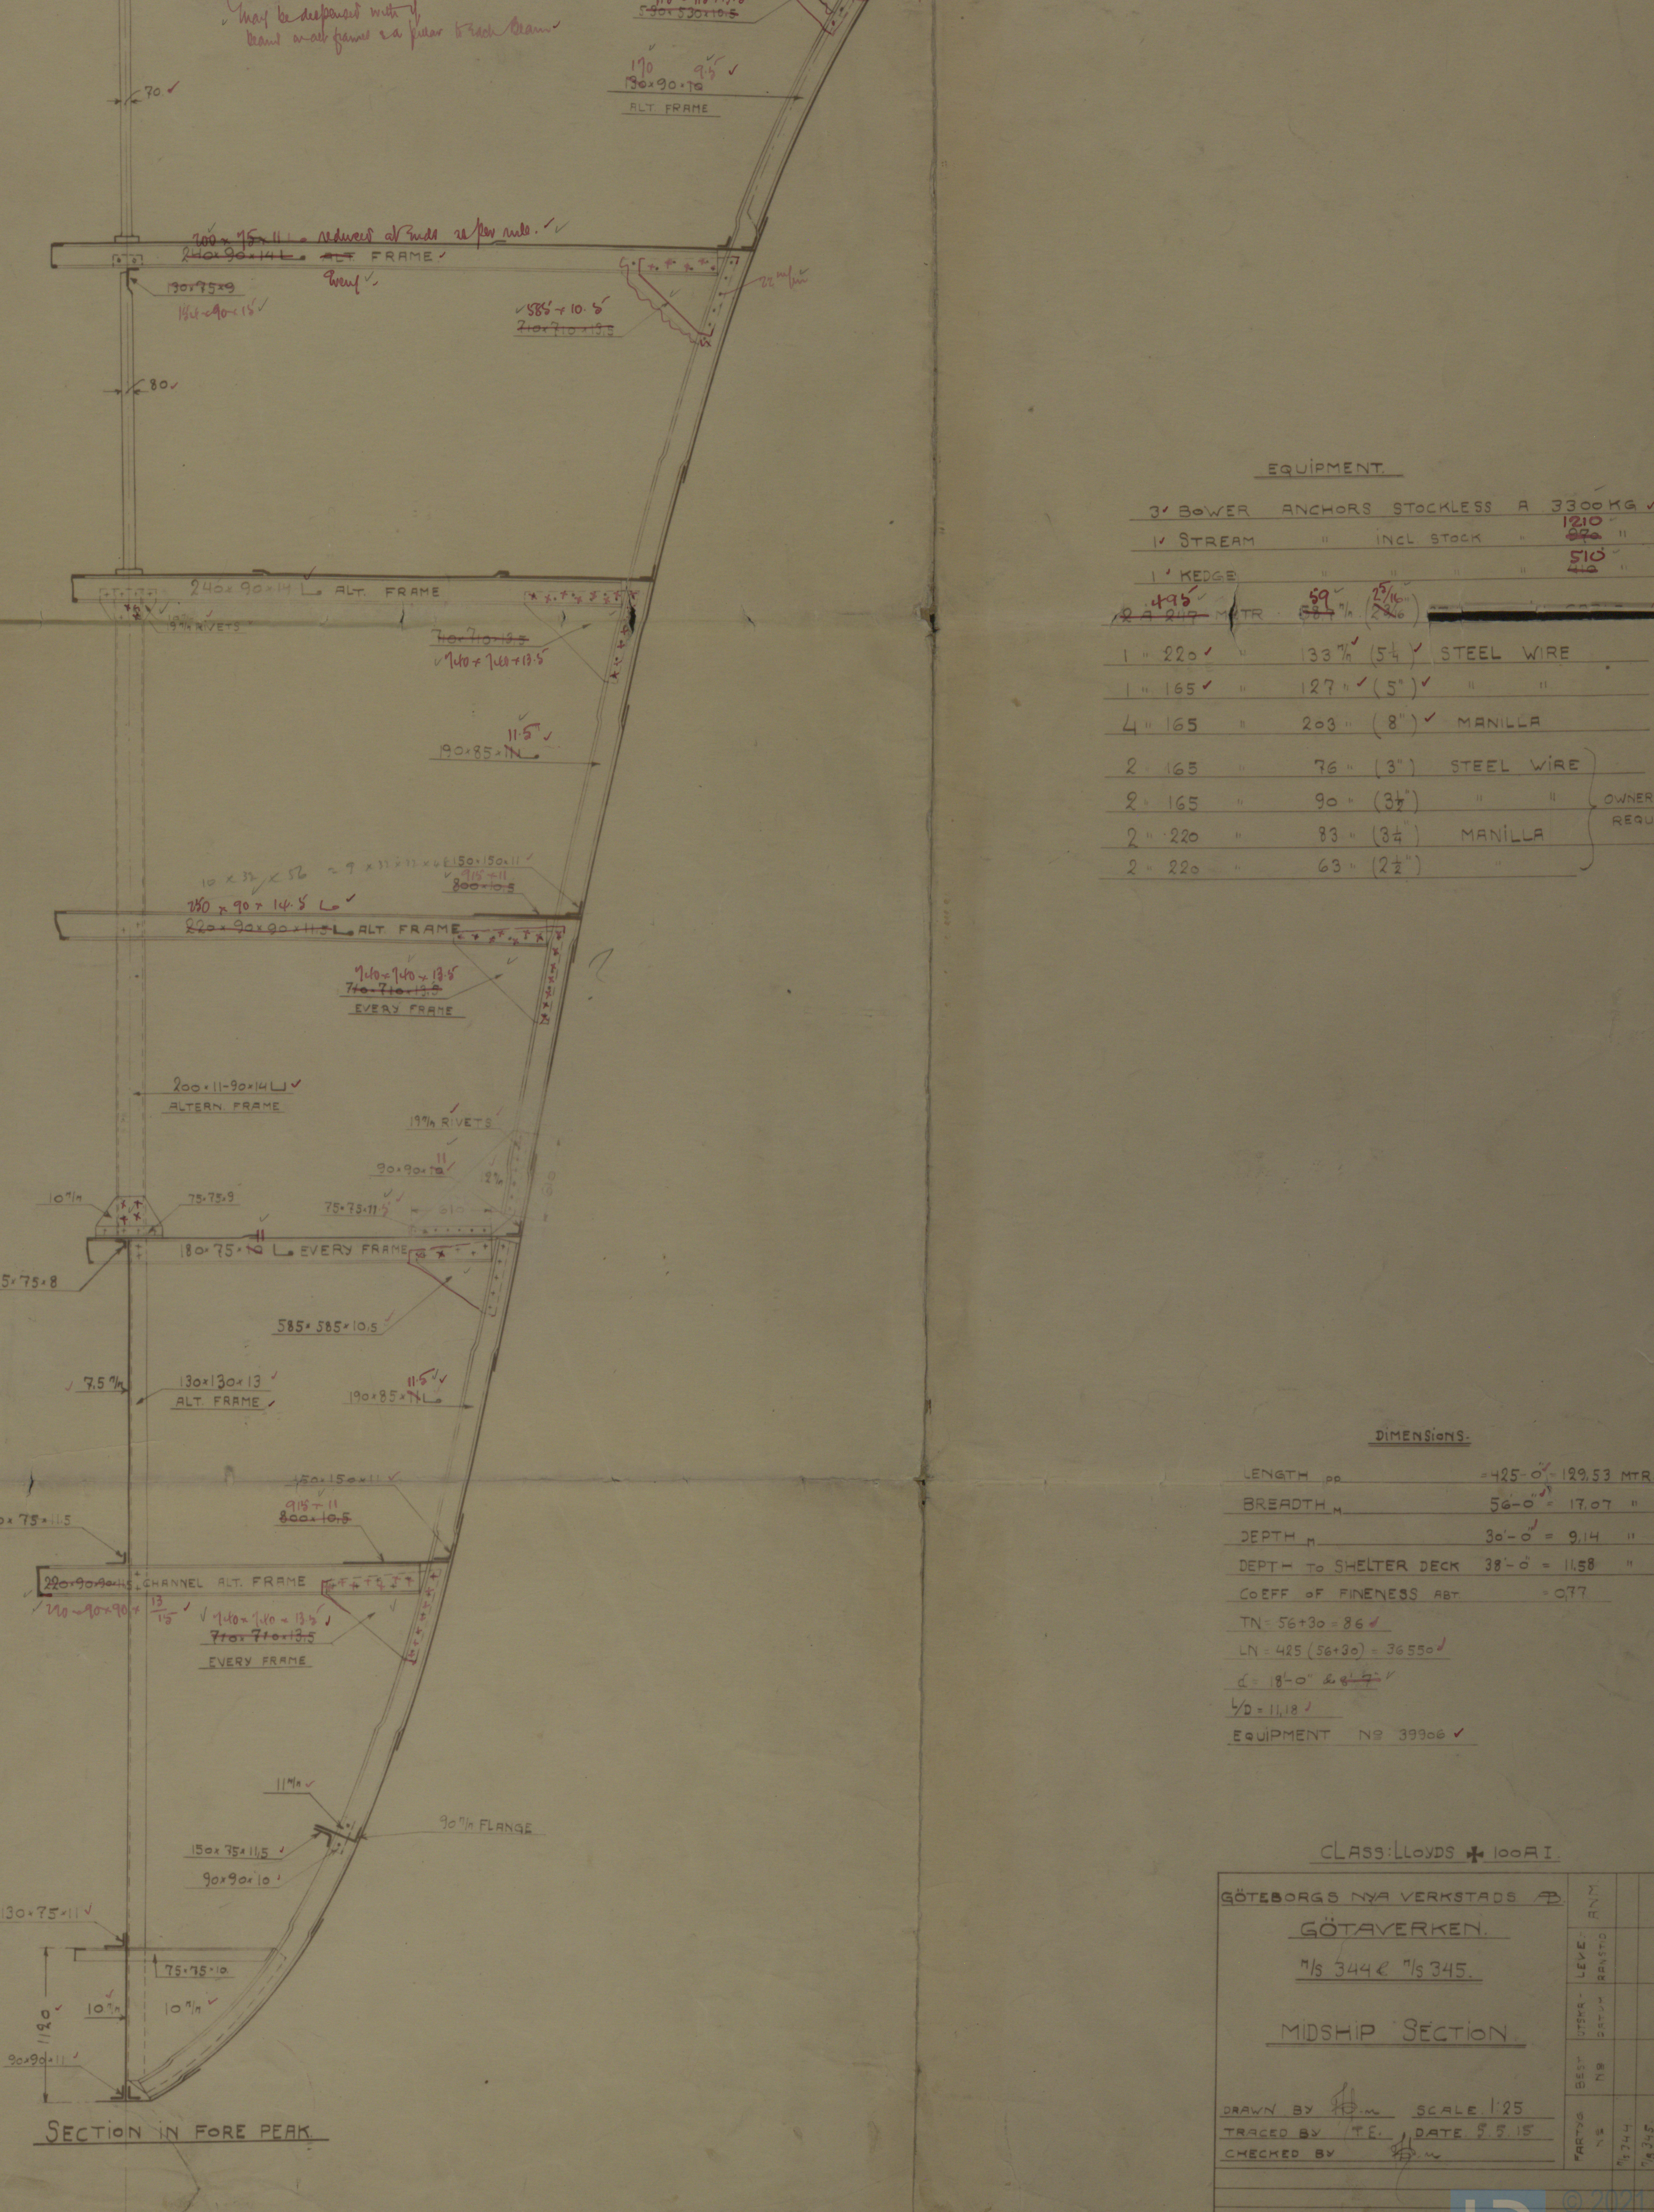
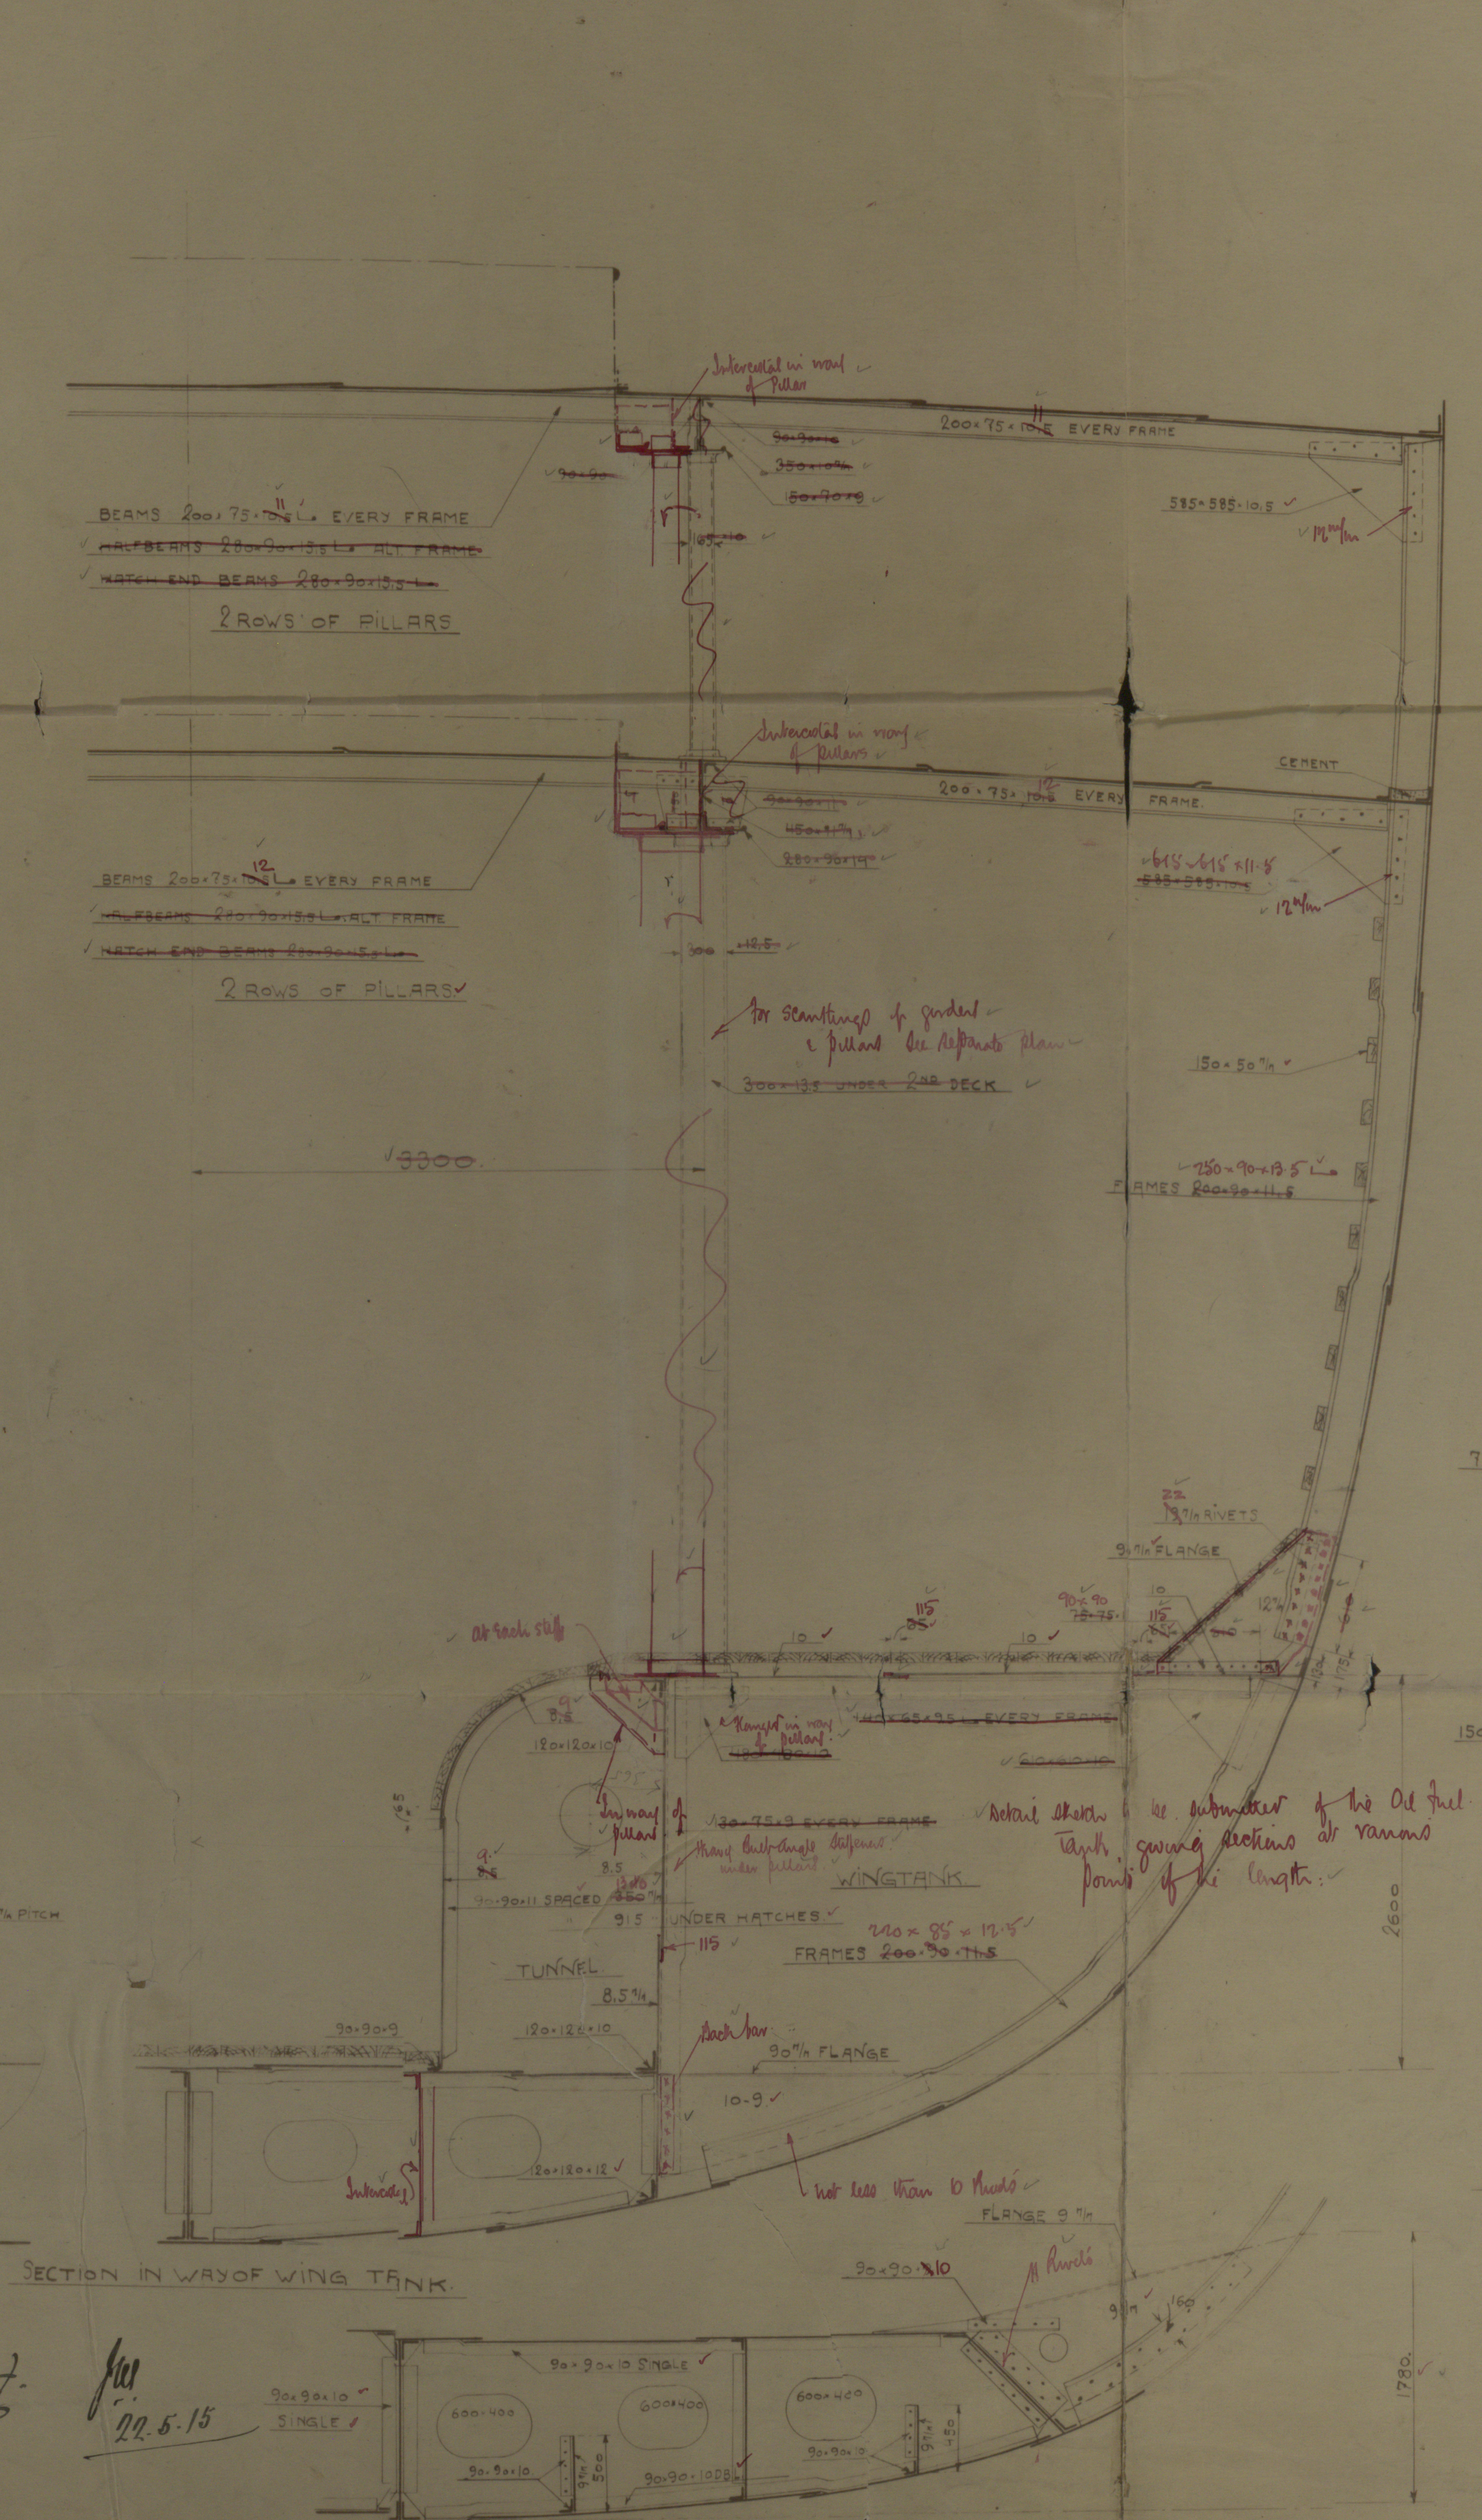



1.6.15
~~1.6.15~~

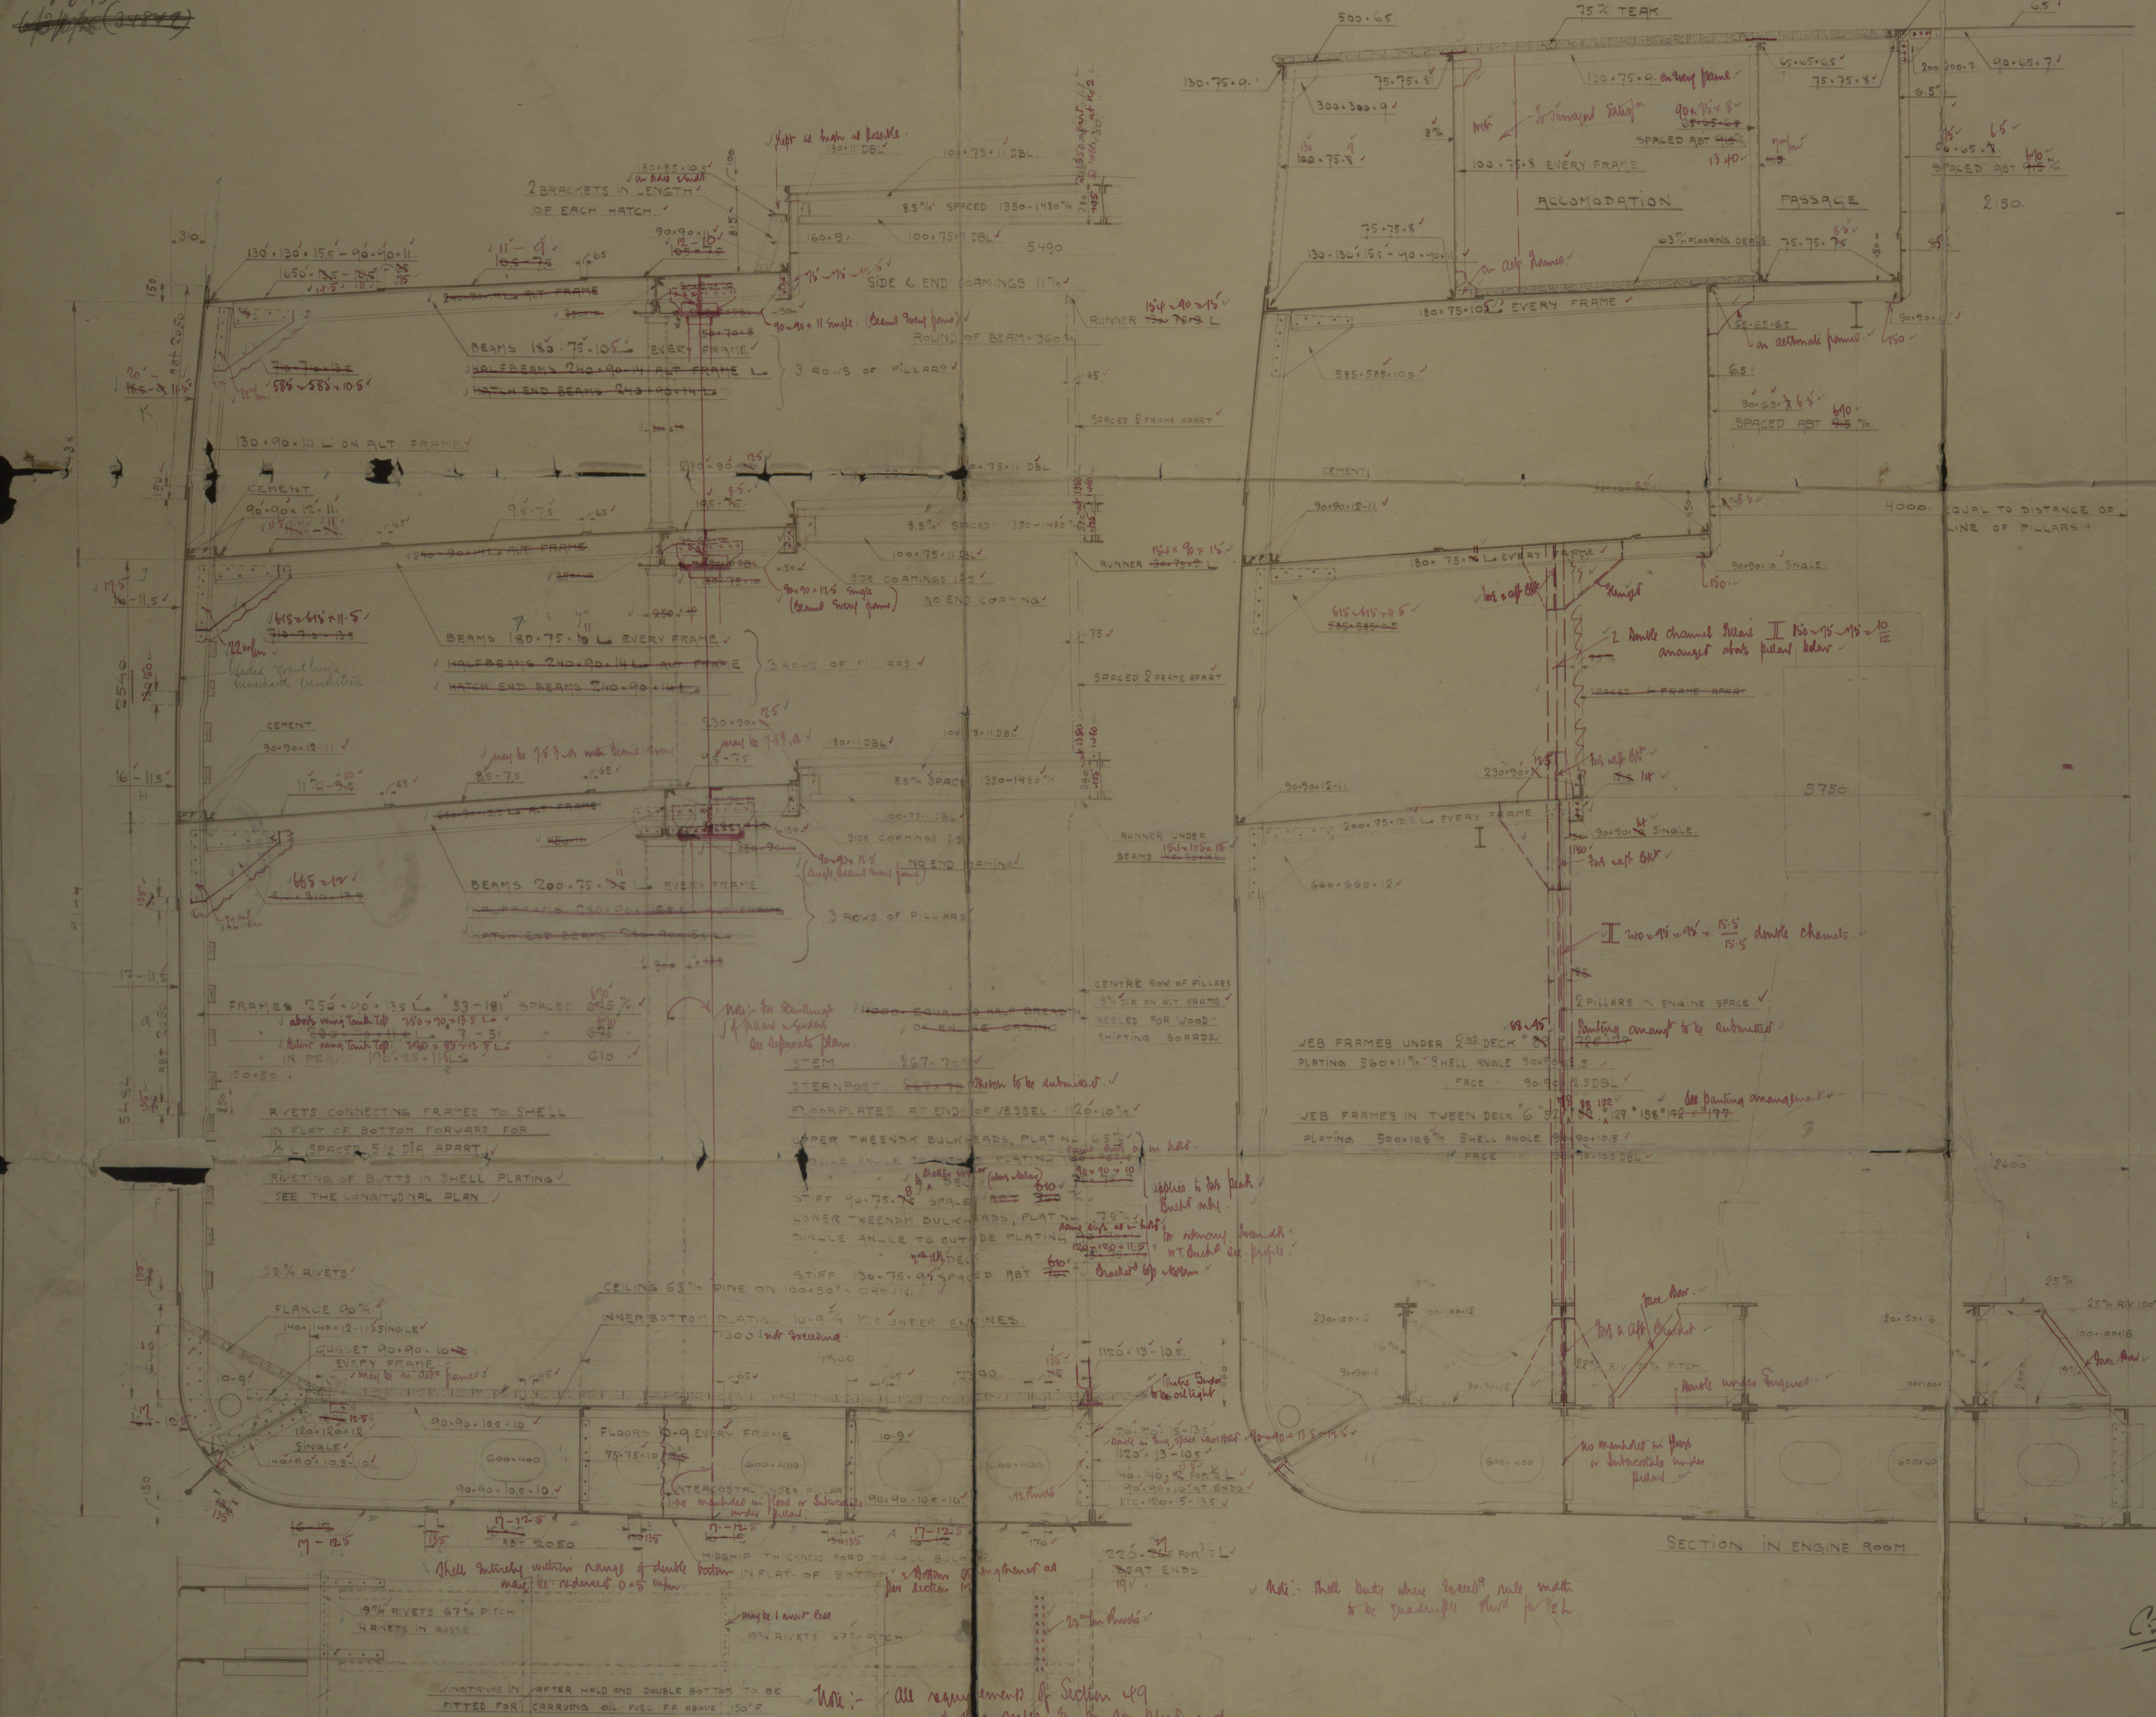

EQUIPMENT	
2 BOWER ANCHORS STOCKLESS A 33000 LB	
1 V. STREAM	INCL. STOCK
1 KEDGE	510
1 220	130 (5 1/2) STEEL WIRE
1 165	127 (5) "
4 165	203 (8) MANILLA
2 165	76 (3) STEEL WIRE
2 165	90 (3 1/2) "
2 220	83 (3 1/2) MANILLA
2 220	63 (2 1/2) "

DIMENSIONS	
LENGTH	425' 0" 129.53 MTR
BREADTH	56' 0" 17.07 "
DEPTH	30' 0" 9.14 "
DEPTH TO SHELTER DECK	38' 0" 11.58 "
COEFF. OF FINENESS	.077

GÖTEBORGS NYA VERKSTÄDS	
GÖTAVÄRKEN	
75 344 75 345	
MIDSHIP SECTION	
DRAWN BY	SCALE 1/25
TRACED BY	DATE 2.2.15
CHECKED BY	

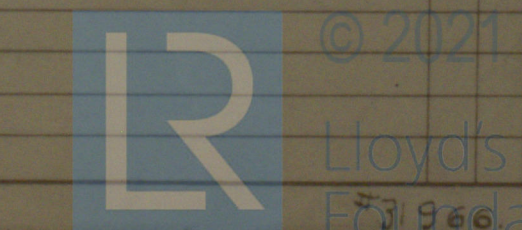





II

Midships Section

N. S. Nos 344 & 345

Göteborgs Kpa Verkskadsabblisbolag

Göteborg.

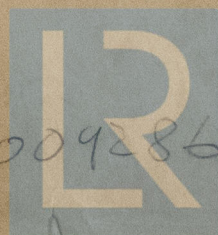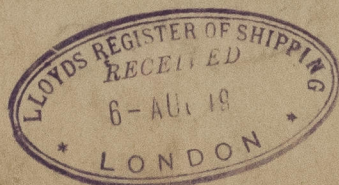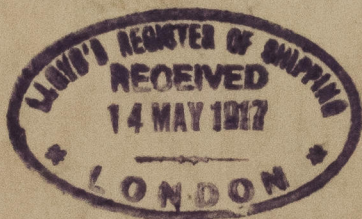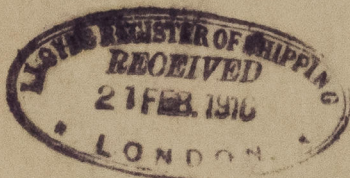

© 2021

00 9278-00 9286-Lloyd's Register
Foundation

1 " 220 ✓	"	133 7/8 (54) ✓	STEEL WIRE	
1 " 165 ✓	"	127 " (5") ✓	"	"
4 " 165	"	203 " (8") ✓	MANILLA	
2 " 165	"	76 " (3")	STEEL WIRE	OWNERS REQU.
2 " 165	"	90 " (3 1/2")	"	
2 " 220	"	83 " (3 1/4")	MANILLA	
2 " 220	"	63 " (2 1/2")	"	

DIMENSIONS.

LENGTH _{pp}	= 425'-0" = 129.53 MTR.
BREADTH _m	56'-0" = 17.07 "
DEPTH _m	30'-0" = 9.14 "
DEPTH TO SHELTER DECK	38'-0" = 11.58 "
COEFF OF FINENESS ABT.	= 0.77
TN = 56+30 = 86 ✓	
LN = 425 (56+30) = 36550 ✓	
d = 18'-0" 28'-7" ✓	
L/D = 11.18 ✓	
EQUIPMENT	Nº 39906 ✓

CLASS: LLOYDS + 100A I.

GÖTEBORGS NYA VERKSTADS AB		ANN				
GÖTAVERKEN.		LEVEL				
Nºs 344 & Nºs 345.		RANSTID				
MIDSHIP SECTION.		UTSÅR - DATUM				
DRAWN BY <i>H.M.</i> SCALE 1:25		BEST NØ				
TRACED BY T.E. DATE 5.5.15		FARTSG NØ	Nº 344	Nº 345		
CHECKED BY <i>H.M.</i>						

#31966.

009278-004286-0013

009278-004286-0013



© 2021
Lloyd's Register
Foundation