
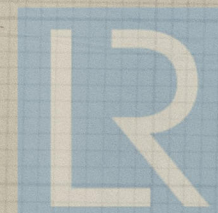


Moulded Depth as measured....30'-0" to Main Deck

NOTE. - If the depth is measured

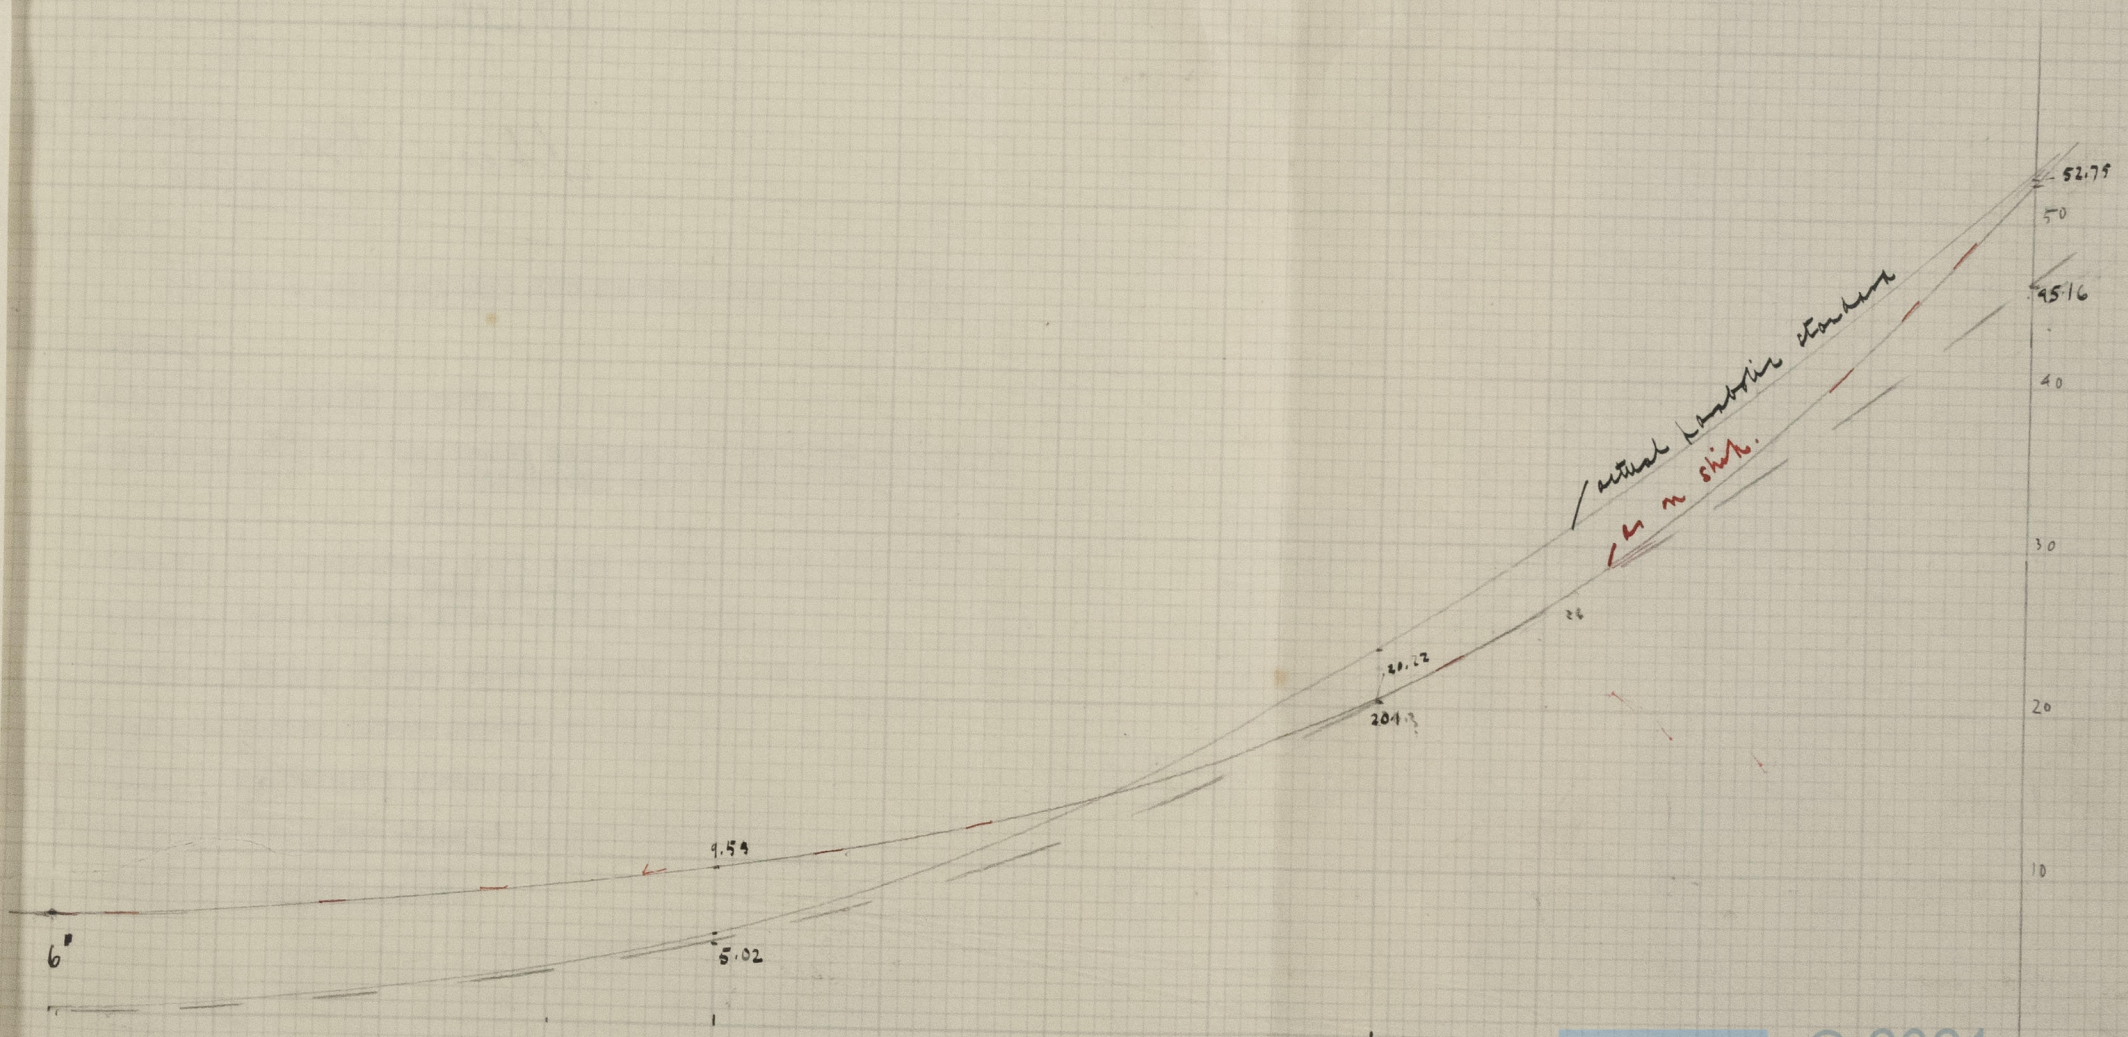

© 2021

Lloyd's Register
Foundation

009278-009286-0005

Bullaren .

Sheer curves .



© 2021

Lloyd's Register
Foundation