


S. S. "DURBAN MARU."

RUDDER & STERN FRAME.

SCALE $\frac{1}{2}$ TO ONE FOOT.

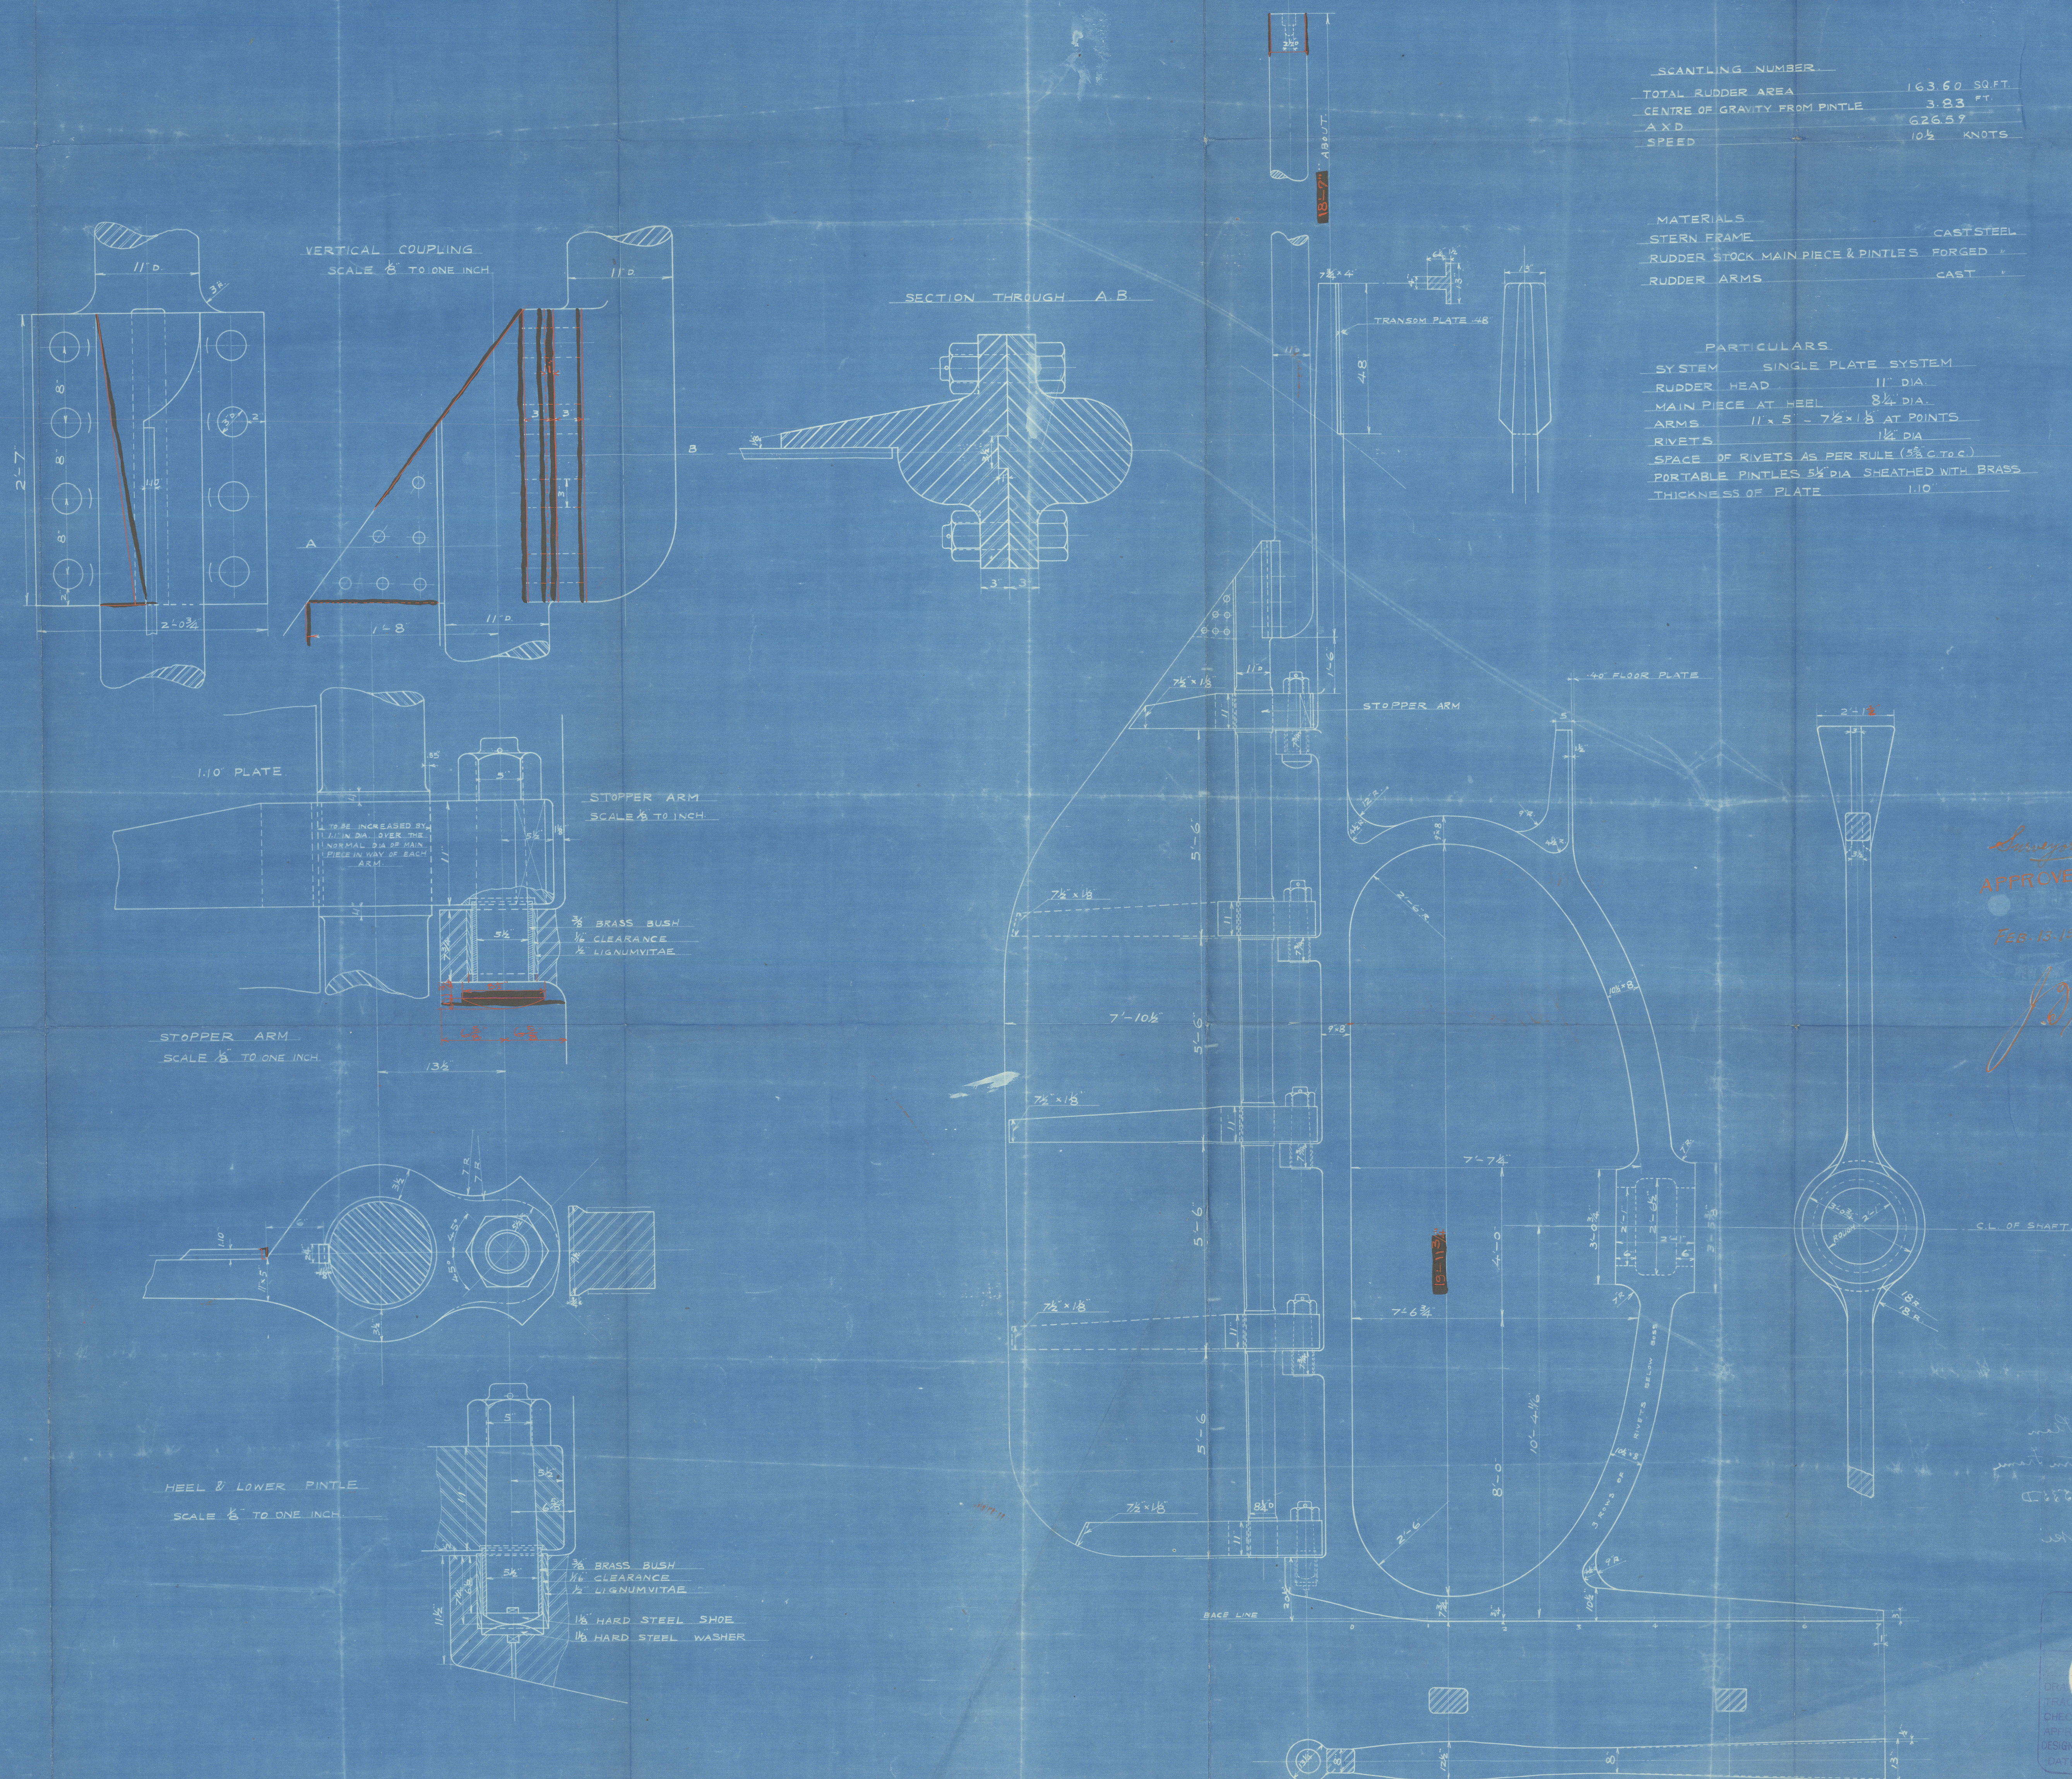


"Rudder & Stern Frame"

S. S. No. 329

Mitsubishi Zosen Kaisha

Nagasaki, Report No. 1268



© 2021

Lloyd's Register
Foundation

009278-009280-0235