
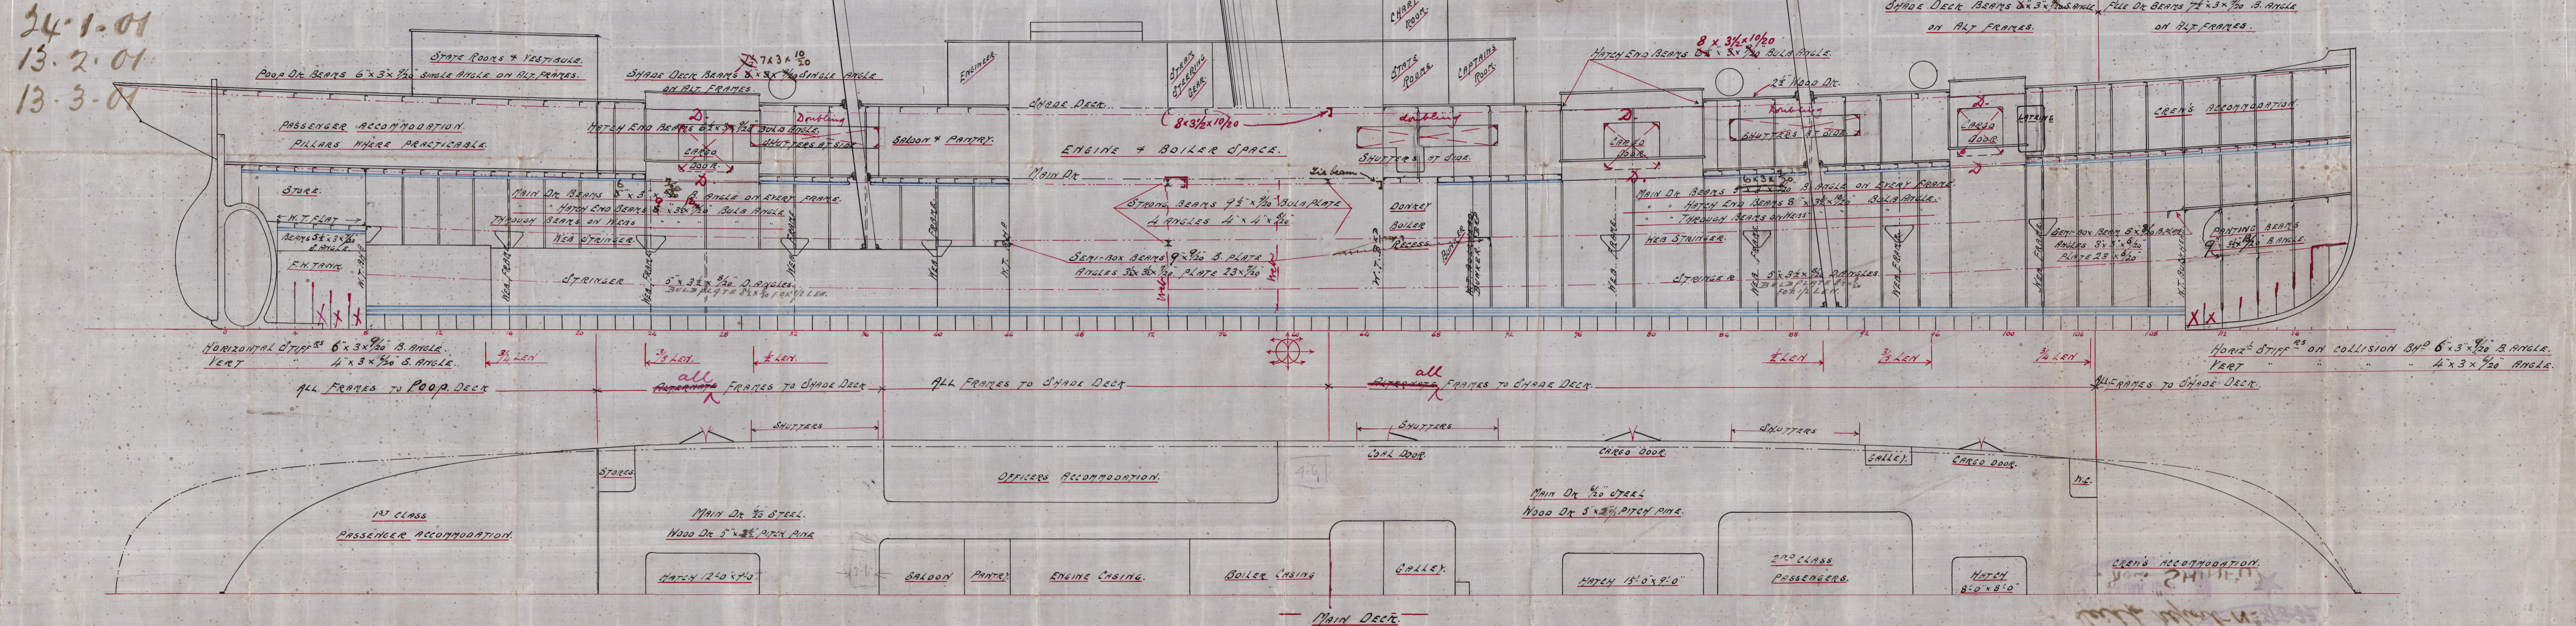


SCALE $\frac{1}{8}'' = 1 \text{ FT.}$

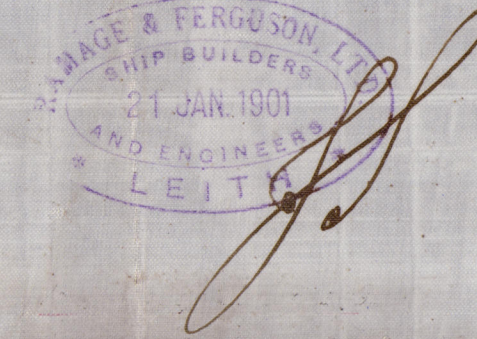

J. V. L.
24/1/07

[Handwritten:]
 87 N. 118
 10/2
 10/2

Profile


S. S. No 178

s/s "Rajah of Sarawak"

Leith Report No 9892

Now "SHINFU" ★

© 2021

Lloyd's Register
Foundation

000287-000300-0001