

NO. 54.  
S. S. "SHIMA MARU."  
MIDSHIP SECTION.  
SCALE  $\frac{1}{2}$ " TO ONE FOOT.



T. S.S. Form No. 48.

TOBA YARD No. 54


Ship's Name: SHIMA MARU

MIDSHIP SECTION

of Vessel as built

Rept No.

TEIKOKU STEAMSHIP CO., LTD., KOBE, JAPAN.

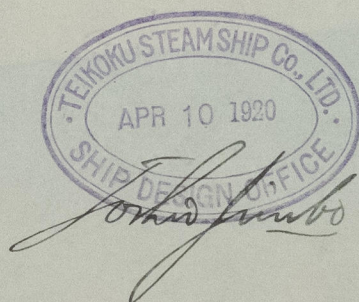

© 2021

Lloyd's Register  
Foundation

009287-009300-0109