



V. N° 122
 PROFILE & DECK PLAN
 SCALE $\frac{1}{4}$ " = 1 FT
 DIMS 75.0" x 16.0" x 8.0"
 To CLASS 100A1. For TOWING PURPOSES.
 20.6.19.
 AM 17/6/19.



Pillaring arrangements throughout
 to Surveyors Satisfaction.

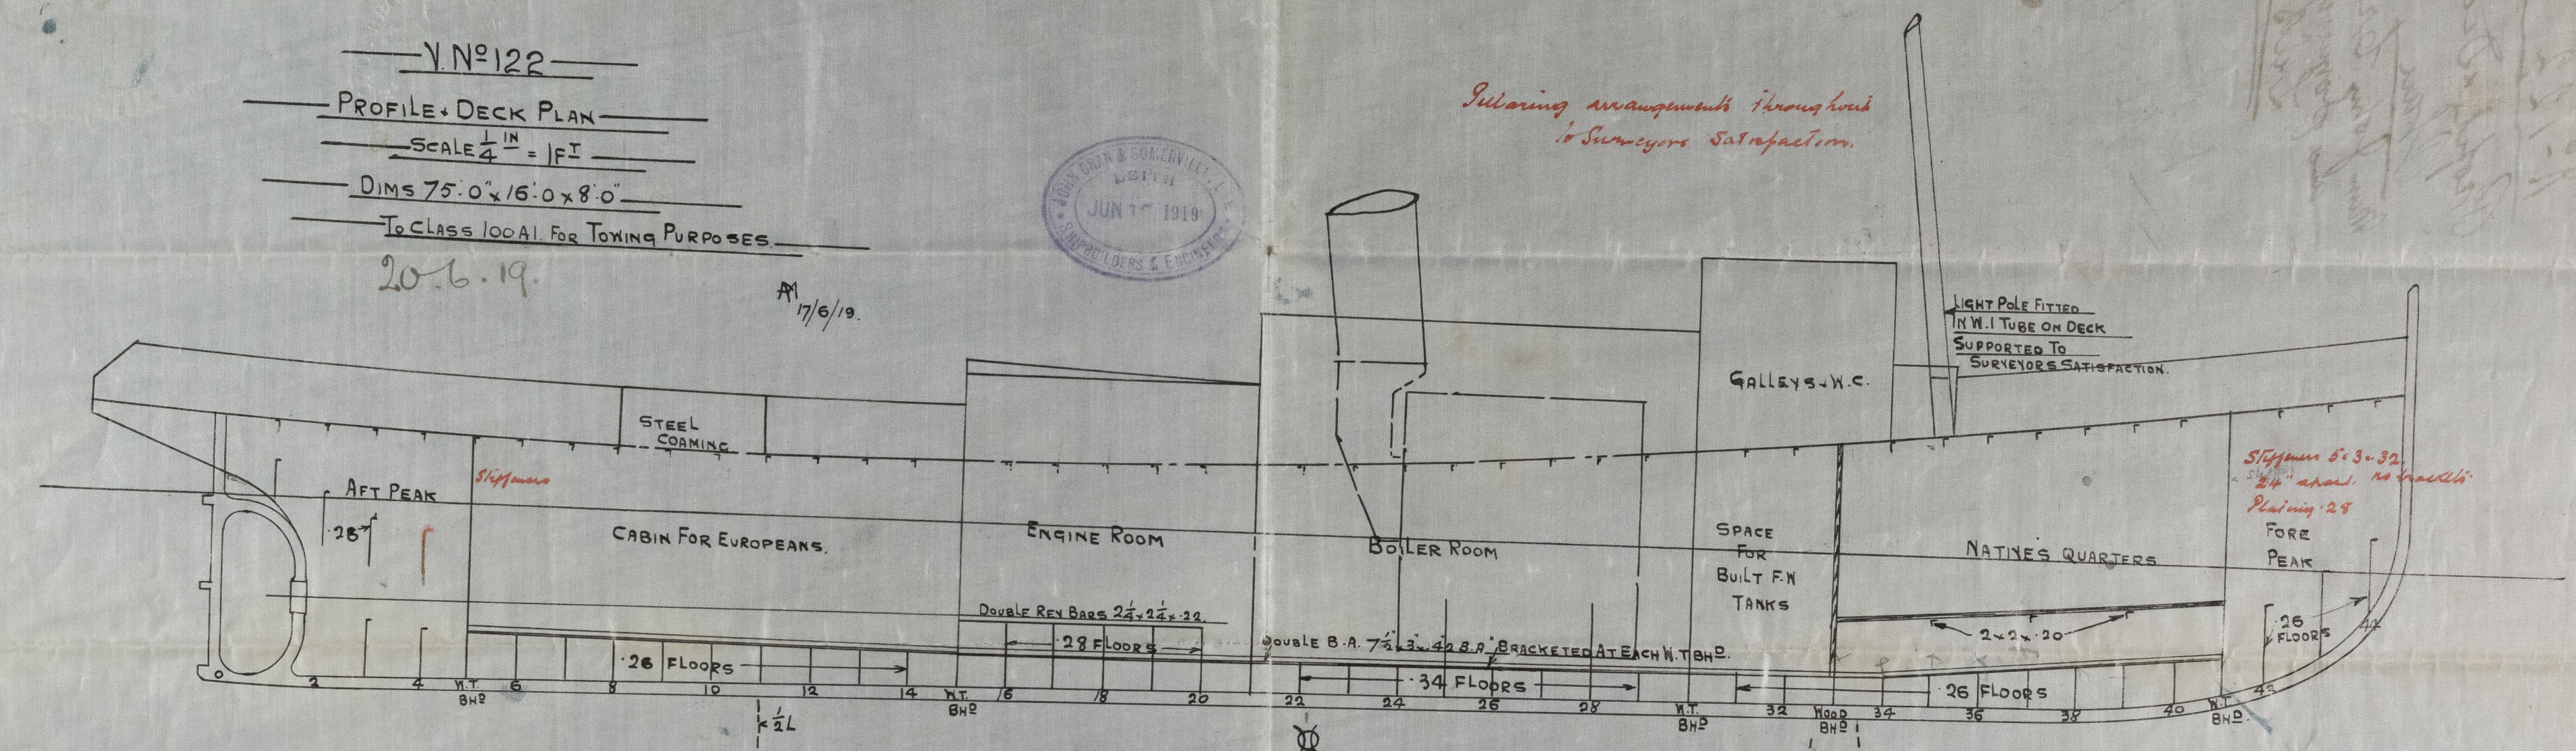

PILLARING THROUGHOUT TO SURVEYORS SATISFACTION.

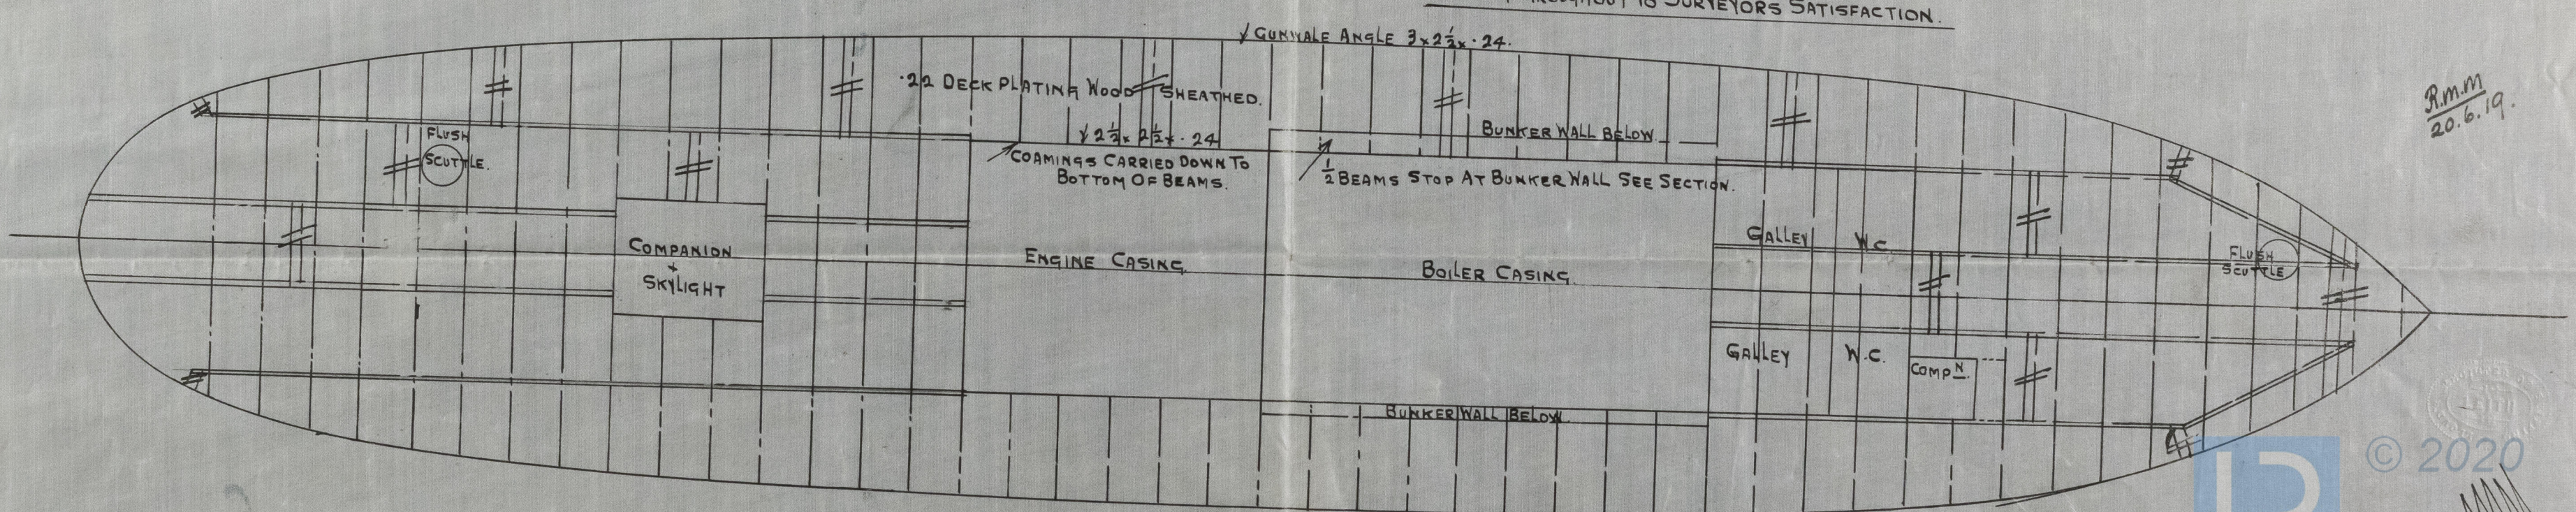

R.m.m.
 20.6.19.



© 2020
 Lloyd's Register
 Foundation

009311-009320-0016

No 122

Profile & Dicto
Plan

Mem John Cran
and Somerville
Leeds

"Dalmore"

Lth 15781

009311-009320-0016

© 2020

Lloyd's Register
Foundation

009311-009320-0016