

PROFILE & DECK PLAN

STEEL SCREW TRAWLER



No 493-4

DIM. 140'-0" x 24'-0" EX x 13'-6" MLD

SCALE 1/4" = ONE FOOT

PLAN NO. 882
FOR ENCLOSURE TO
Messrs. Lloyd's Surveyors
FROM
DOOHANE & SONS,
SHIPBUILDERS, SELBY.
DATE 7/1/11

PLAN NO. 87
TO
Messrs. Lloyd's Surveyors
FROM
DOOHANE & SONS,
SHIPBUILDERS, SELBY.
DATE 2/3/11

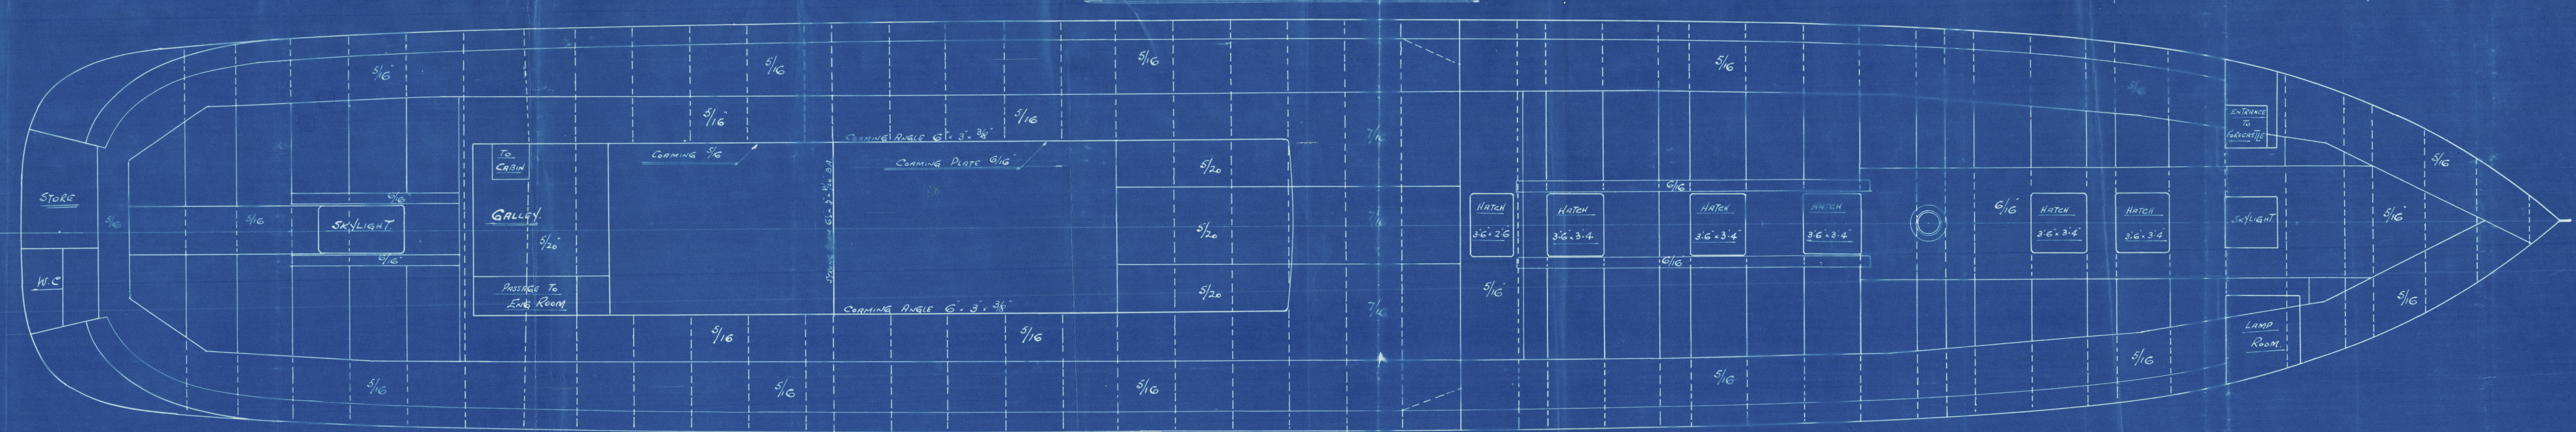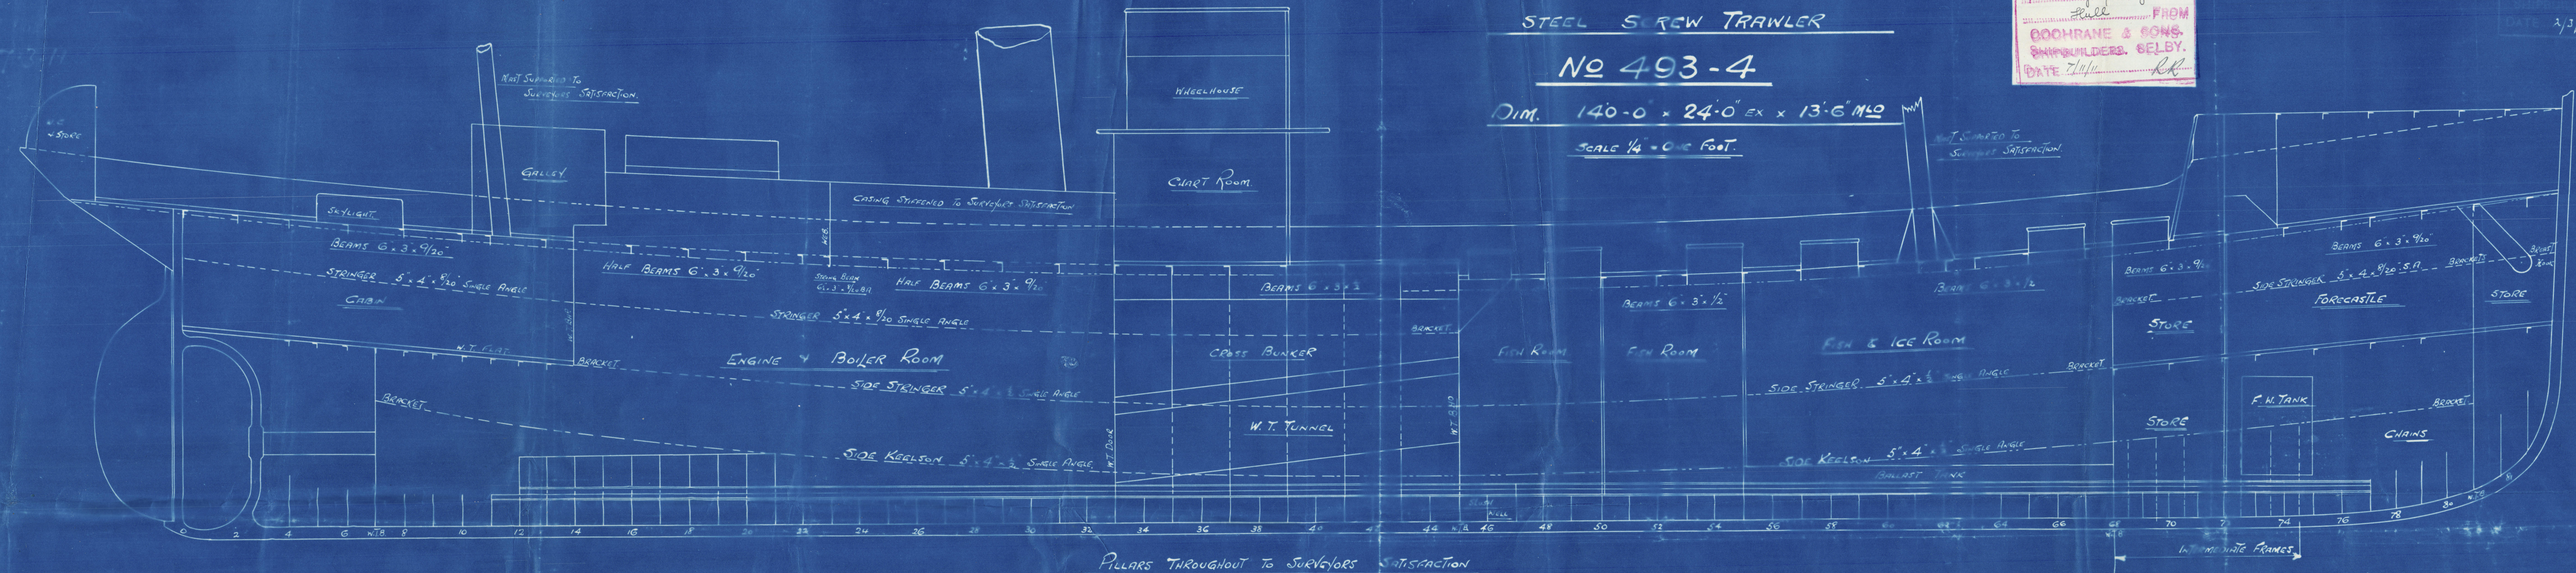

C.B.
7.3.11.

Profile

s/s Aquamarine

Cochrane & Sons

Hull Report No. 24411



009321-009330-0092



© 2021

Lloyd's Register
Foundation