Nº 542. SELF PROPELLING FLOATING CRANE.
TO LIFT 10 RESP: 60 TONS.
LLOYD'S ✠.A.1. STEEL (CRANE BARGE.)

WERF GUSTO
FIRMA A.F. SMULDERS
ENGINEERS & SHIPBUILDERS
SCHIEDAM (ROTTERDAM)

PRINCIPAL DIMENSIONS

LENGTH BETWEEN PP	= 115'-0"
BREADTH (BEAM)	= 56'-0"
DEPTH AT SIDE (FORE)	= 13'-2"
" " (AFT)	= 6'-0"
ROUNDING UP OF BEAMS	= 14"
SPACING OF FRAMES	= 22"

EQUIPMENT.

1 ANCHOR	OF 14 3/4 CWT, INCL: STOCK.
1 "	14 " " " "
1 "	13 1/4 " " " "
1 STREAM ANCHOR "	5 1/4 " " " "
1 KEDGE " "	2 1/2 " " " "
195 FATHOMS OF	1 3/16 STUD LINK CHAIN
120 " "	5/8 SHORT " " WITH CHACKLES.
120 " "	2 1/2 CINC: GALV: STEEL WIRE ROPS.
4 OFF 30 FATH: EACH 3	" " " " " (MOORING CABLES)

SCALE 1 TO 50 & 1 TO 20.

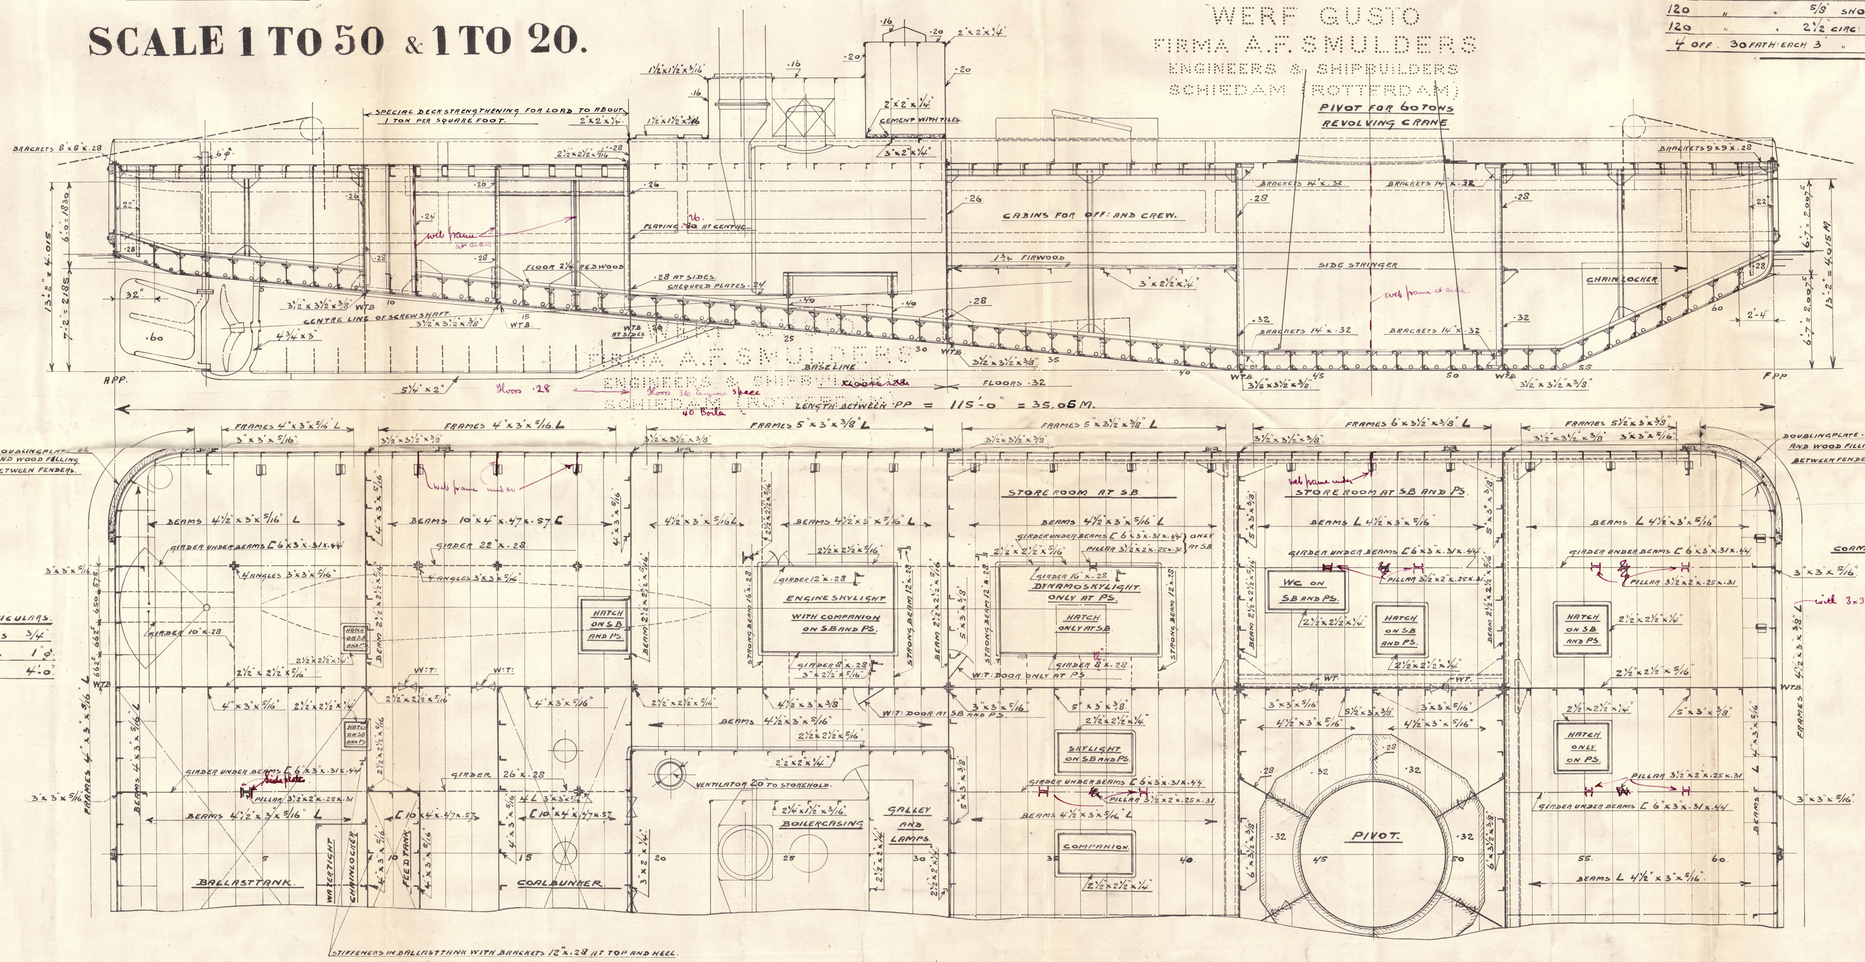

WERF GUSTO - SCHIEDAM
FIRMA A. F. SMULDERS

Nº 12432.

© 2021 Lloyd's Register Foundation

Smulders.

542

M.S. P&D.

Gen Bos.

3184

© 2021
Lloyd's Register
Foundation

009341.009349.0098

542

009341-009349-0098

© 2021
Lloyd's Register
Foundation