

中央切断

NOV 19 1925

009341-009349-0192

GEN. BOX NO 726

Yohiko Maeda
Kob. 5503.

HARIMA YARD No. 111.


Ship's Name:

MIDSHIP SECTION.

No.

THE KOBE STEEL WORKS, LTD., KOBE, JAPAN.

*Submitted
for
Attention*

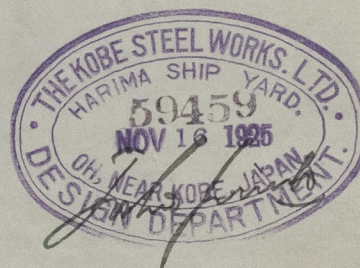

© 2021

Lloyd's Register

009341-009349-0192