

11.1.05


S.S. 207 & 208.

Screw frame.


to be made of cast steel.

1/25

Sketch of Rivet holes in Scarphs.

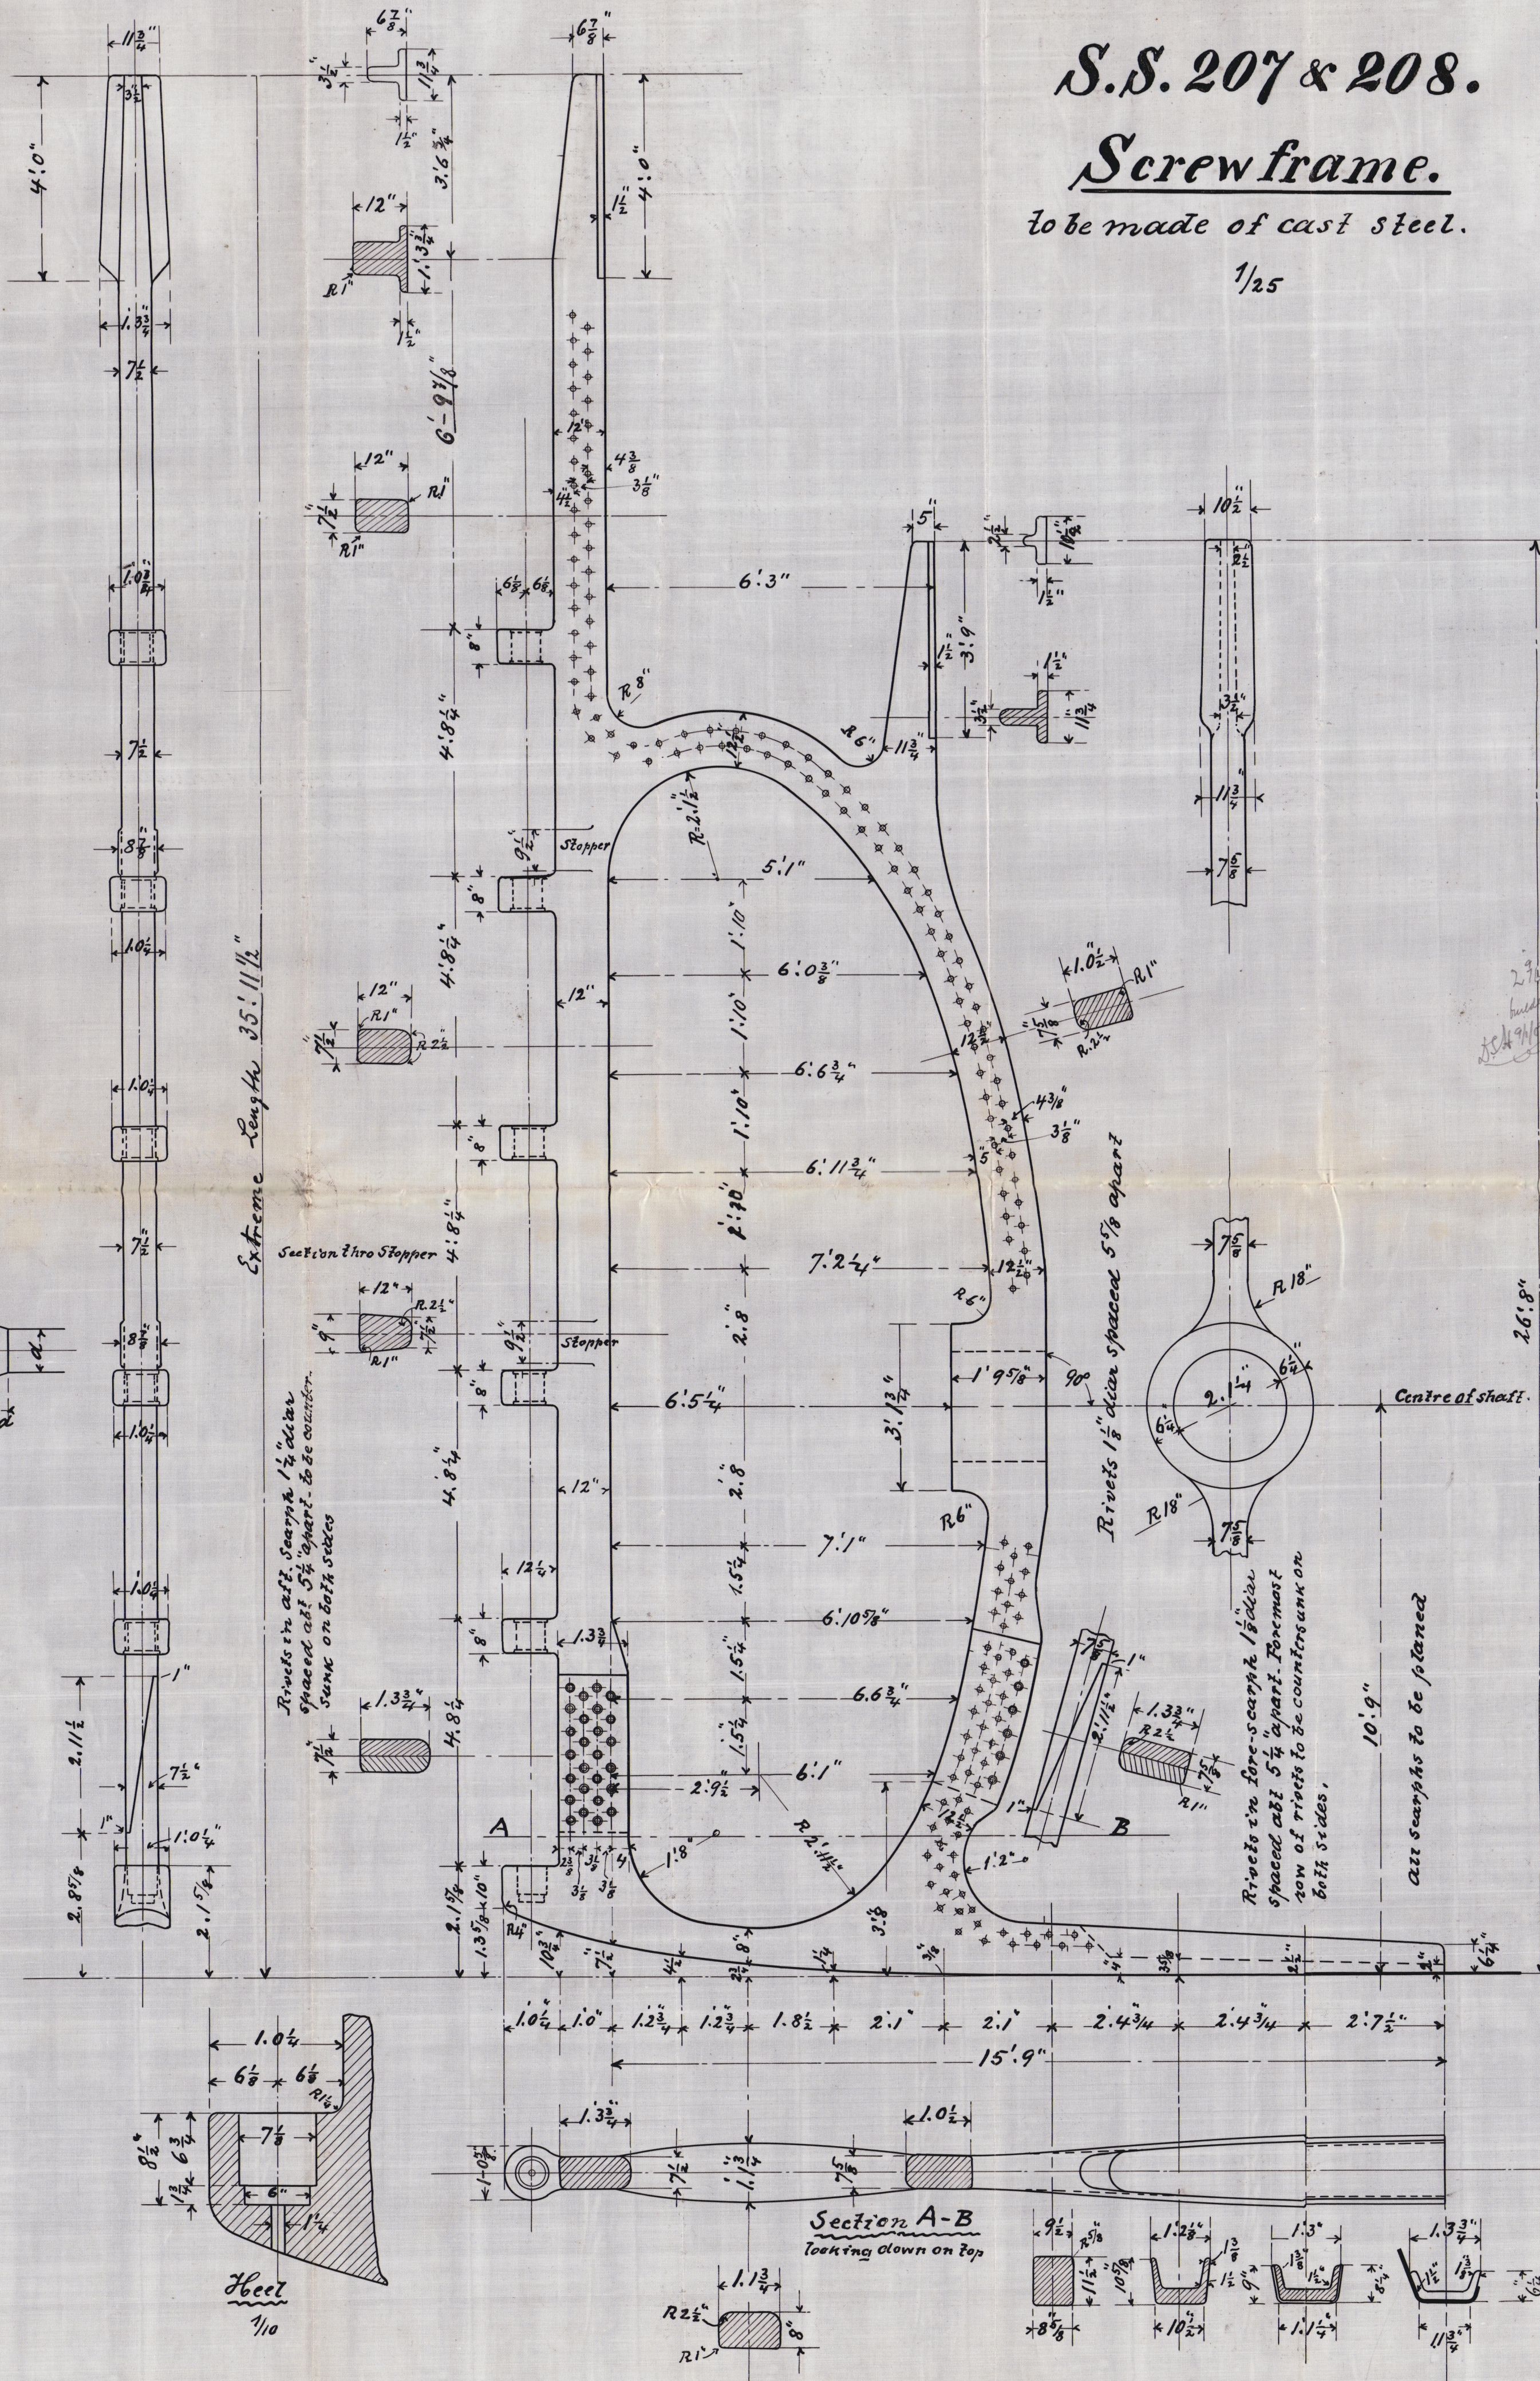


Section through Gudgeon.

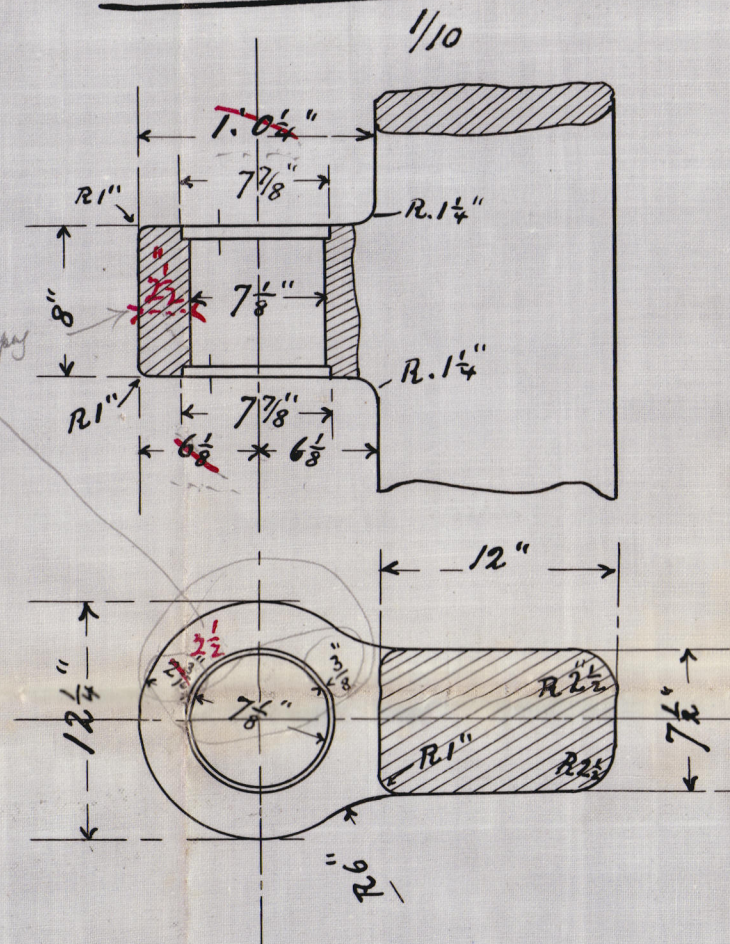

24060
JOHN C. TECKLETON & SONS
ENGINEERS AND MANUFACTURERS
BIRMINGHAM
30/12/04

J.P.L.
11/1/05

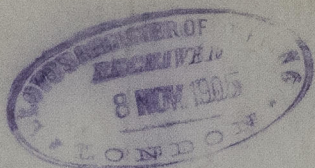

L. H. Keeler

Phn. 1107

G. S. Westfalen
1125

