

STEEL SCREW STEAMERS - SINGLE DECK TYPE.

SHIP Nos 8 AND 9

PLAN No 3

DIMENSIONS

LENGTH B.P. 330'-0" BREADTH M^{LD} 49'-0" DEPTH M^{LD} 30'-0"

Scale 1" = ONE FOOT.

DO NOT WRITE
OCT 1918
NAVY DEPARTMENT
WASHINGTON



POOP DECK.


UPPER DECK.

Sketch of Ballast Bed
sparring arrangements
to be continued.

FOUR DECK

UPPER DECK.

PLAN OF TANK TOP

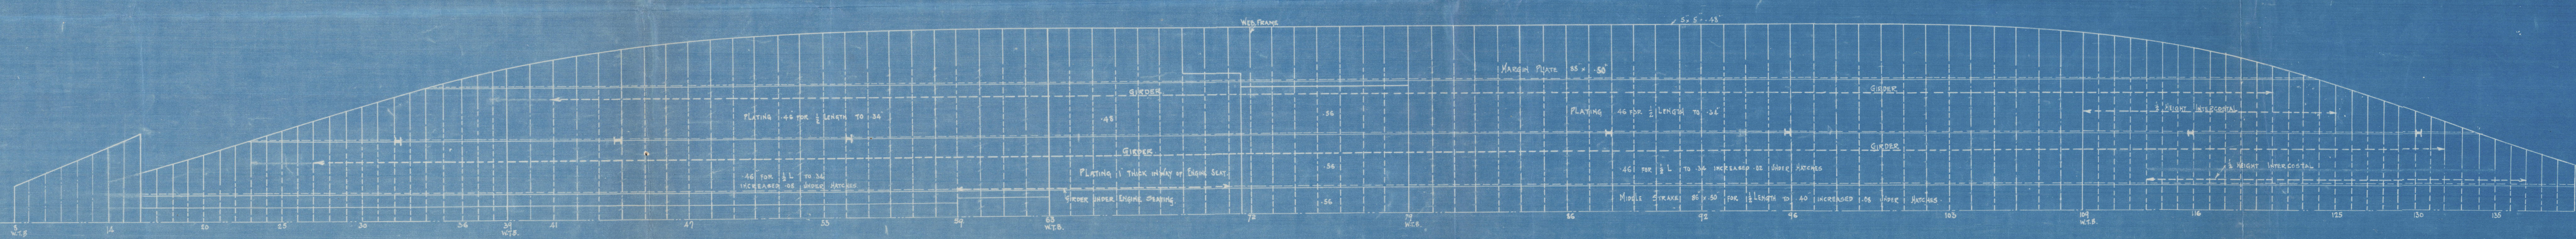

Approved
[Signature]

DO NOT WRITE
OCT 1918
NAVY DEPARTMENT
WASHINGTON

Longitudinal Section
PED

Corsanger

Intl 1522

009341-009349-0322



009341-009349-0322

009341-009349-0322



Lloyd's Register
Foundation


mont



© 2021

Lloyd's Register
Foundation

Plan
819

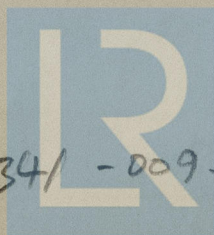

© 2021

009341 - 009349 - 0322

Lloyd's Register
Foundation