


CARGO STEAMERS N^{os} 8&9.
STEEL MASTS & STEEL WIRE RIGGING.

SCALE 1/8"=1FOOT.
PLAN N° 44.

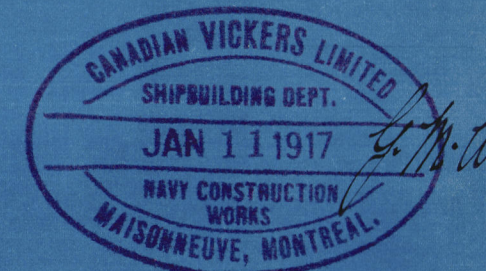


approved
J. J. Francis

Post & Rigging

"
Porsanger"

mtl 1522

009341-009349-0326

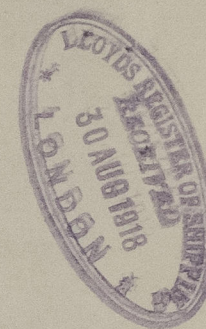

009341-009349-0326



© 2021

Lloyd's Register
Foundation

Montreal Surveyor

009341-009349-0326



© 2021

Lloyd's Register
Foundation