

Lloyd's Register Foundation

009350-009361-000

Cochrane & Sons


No 4 & 3

Midship Section


s/s down

Hull Report No. 19707

RECEIVED
23 JAN 1909
ON BOARD
STOVED & RECHARGED

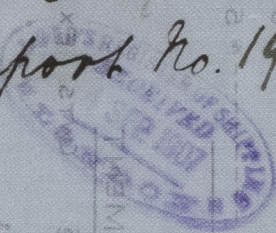

10.2
t

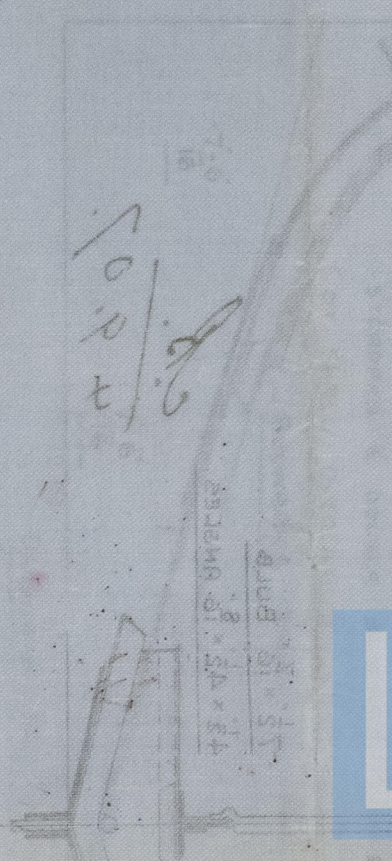

© 2021

Lloyd's Register
Foundation